


FILE #: TRB2
 DRAWING #: 3083
 SCALE: PLAT: 1" = 1500'
TICK: 1" = 2000'
 MINIMUM DEGREE OF ACCURACY: 1/200
 PROVEN SOURCE OF ELEVATION: SUBMETER MAPPING GRADE GPS

I, THE UNDERSIGNED, HEREBY CERTIFY THAT THIS PLAT IS CORRECT TO THE BEST OF MY KNOWLEDGE AND BELIEF AND SHOWS ALL THE INFORMATION REQUIRED BY LAW AND THE REGULATIONS ISSUED AND PRESCRIBED BY THE DEPARTMENT OF ENVIRONMENTAL PROTECTION.
 Signed: [Signature]
 L.L.S. #2124 : Ernest J. Benchek III

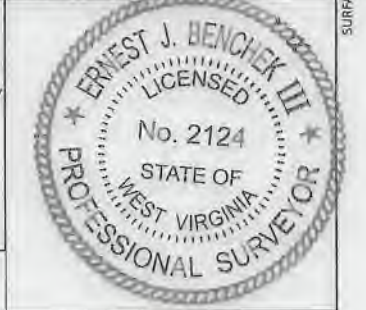

(+) DENOTES LOCATION OF WELL ON UNITED STATES TOPOGRAPHIC MAPS WYDEP
 OFFICE OF OIL & GAS
 601 57TH STREET
 CHARLESTON, WV 25304

Well Type: Oil Waste Diposal Production Deep
 Gas Liquid Injection Storage Shallow

WATERSHED: OUTLET MIDDLE ISLAND CREEK
 COUNTY/DISTRICT: TYLER / McELROY
 SURFACE OWNER: WEST VIRGINIA DEPT. OF NATURAL RESOURCES
 OIL & GAS ROYALTY OWNER: Tribune Resources, LLC, Et Al
 LEASE NUMBERS: _____

DATE: SEPTEMBER 1, 2022
 OPERATOR'S WELL #: BFT 2H
 API WELL #: 47 95 02832
 STATE COUNTY PERMIT
 AS-BUILT ELEVATION: 880'

QUADRANGLE: CENTER POINT
 ACREAGE: 110.00 +/-
 ACREAGE: 877.7 +/- 12/02/2022

DRILL CONVERT DRILL DEEPER REDRILL FRACTURE OR STIMULATE
 PLUG OFF FORMATION PERFORATE NEW FORMATION PLUG & ABANDON
 CLEAN OUT & REPLUG OTHER CHANGE (SPECIFY): _____

TARGET FORMATION: MARCELLUS
 ESTIMATED DEPTH: TVD: 6930' TMD: 17720.06'
 WELL OPERATOR: TRIBUNE RESOURCES, LLC
 DESIGNATED AGENT: HARMAN BROWN
 ADDRESS: 3861 AMBASSADOR CAFFERY PARKWAY SUITE 600
 ADDRESS: 18396 MOUNTAINEER HIGHWAY
 CITY: LAFAYETTE STATE: LA ZIP CODE: 70503
 CITY: WILEYVILLE STATE: WV ZIP CODE: 26581

PROPERTY OWNER INDEX	
5-8-8	WV DEPT. OF NATURAL RESOURCES COMMERCE
5-8-21	JERRY L. WALTERS
5-8-21.1	SYLVIA R. & RUPPERT S. DAWSON JR.
5-8-33	JERRY L. WALTERS
5-8-34	ROBERT MARK HUFFMAN
5-13-4	ASCENT RESOURCES MARCELLUS MINERALS
5-13-5	FRED LOREN GLOVER ET AL
5-13-6	JASON GLOVER
5-13-65	MELBA JEAN TEMPLETON LIFE ESTATE
5-13-30	MELBA JEAN TEMPLETON LIFE ESTATE
5-13-29	KENNETH DALE NICE JR.
5-13-25	ROYCE J. & ROYAL J. WATTS
5-13-24	DONNA WOLF

LEASE INDEX			
A	MARC00713-000	G	MARC01379-001
B	MARC00713-000	H	MARC01575-000
C	MARC00925-001	I	MARC03489-000
D	MARC00765-000	J	MARC01363-001
E	MARC00712-000	K	MARC01228-001
F	MARC00722-000	L	MARC01574-00

12/02/2022

FILE #: TRB2

DRAWING #: 3083


SCALE: N/A

DATE: SEPTEMBER 1, 2022

OPERATOR'S WELL #: BFT 2H

API WELL #: 47 095 02882
STATE COUNTY PERMIT

WELL NAME: BFT 2H
CENTER POINT, WV

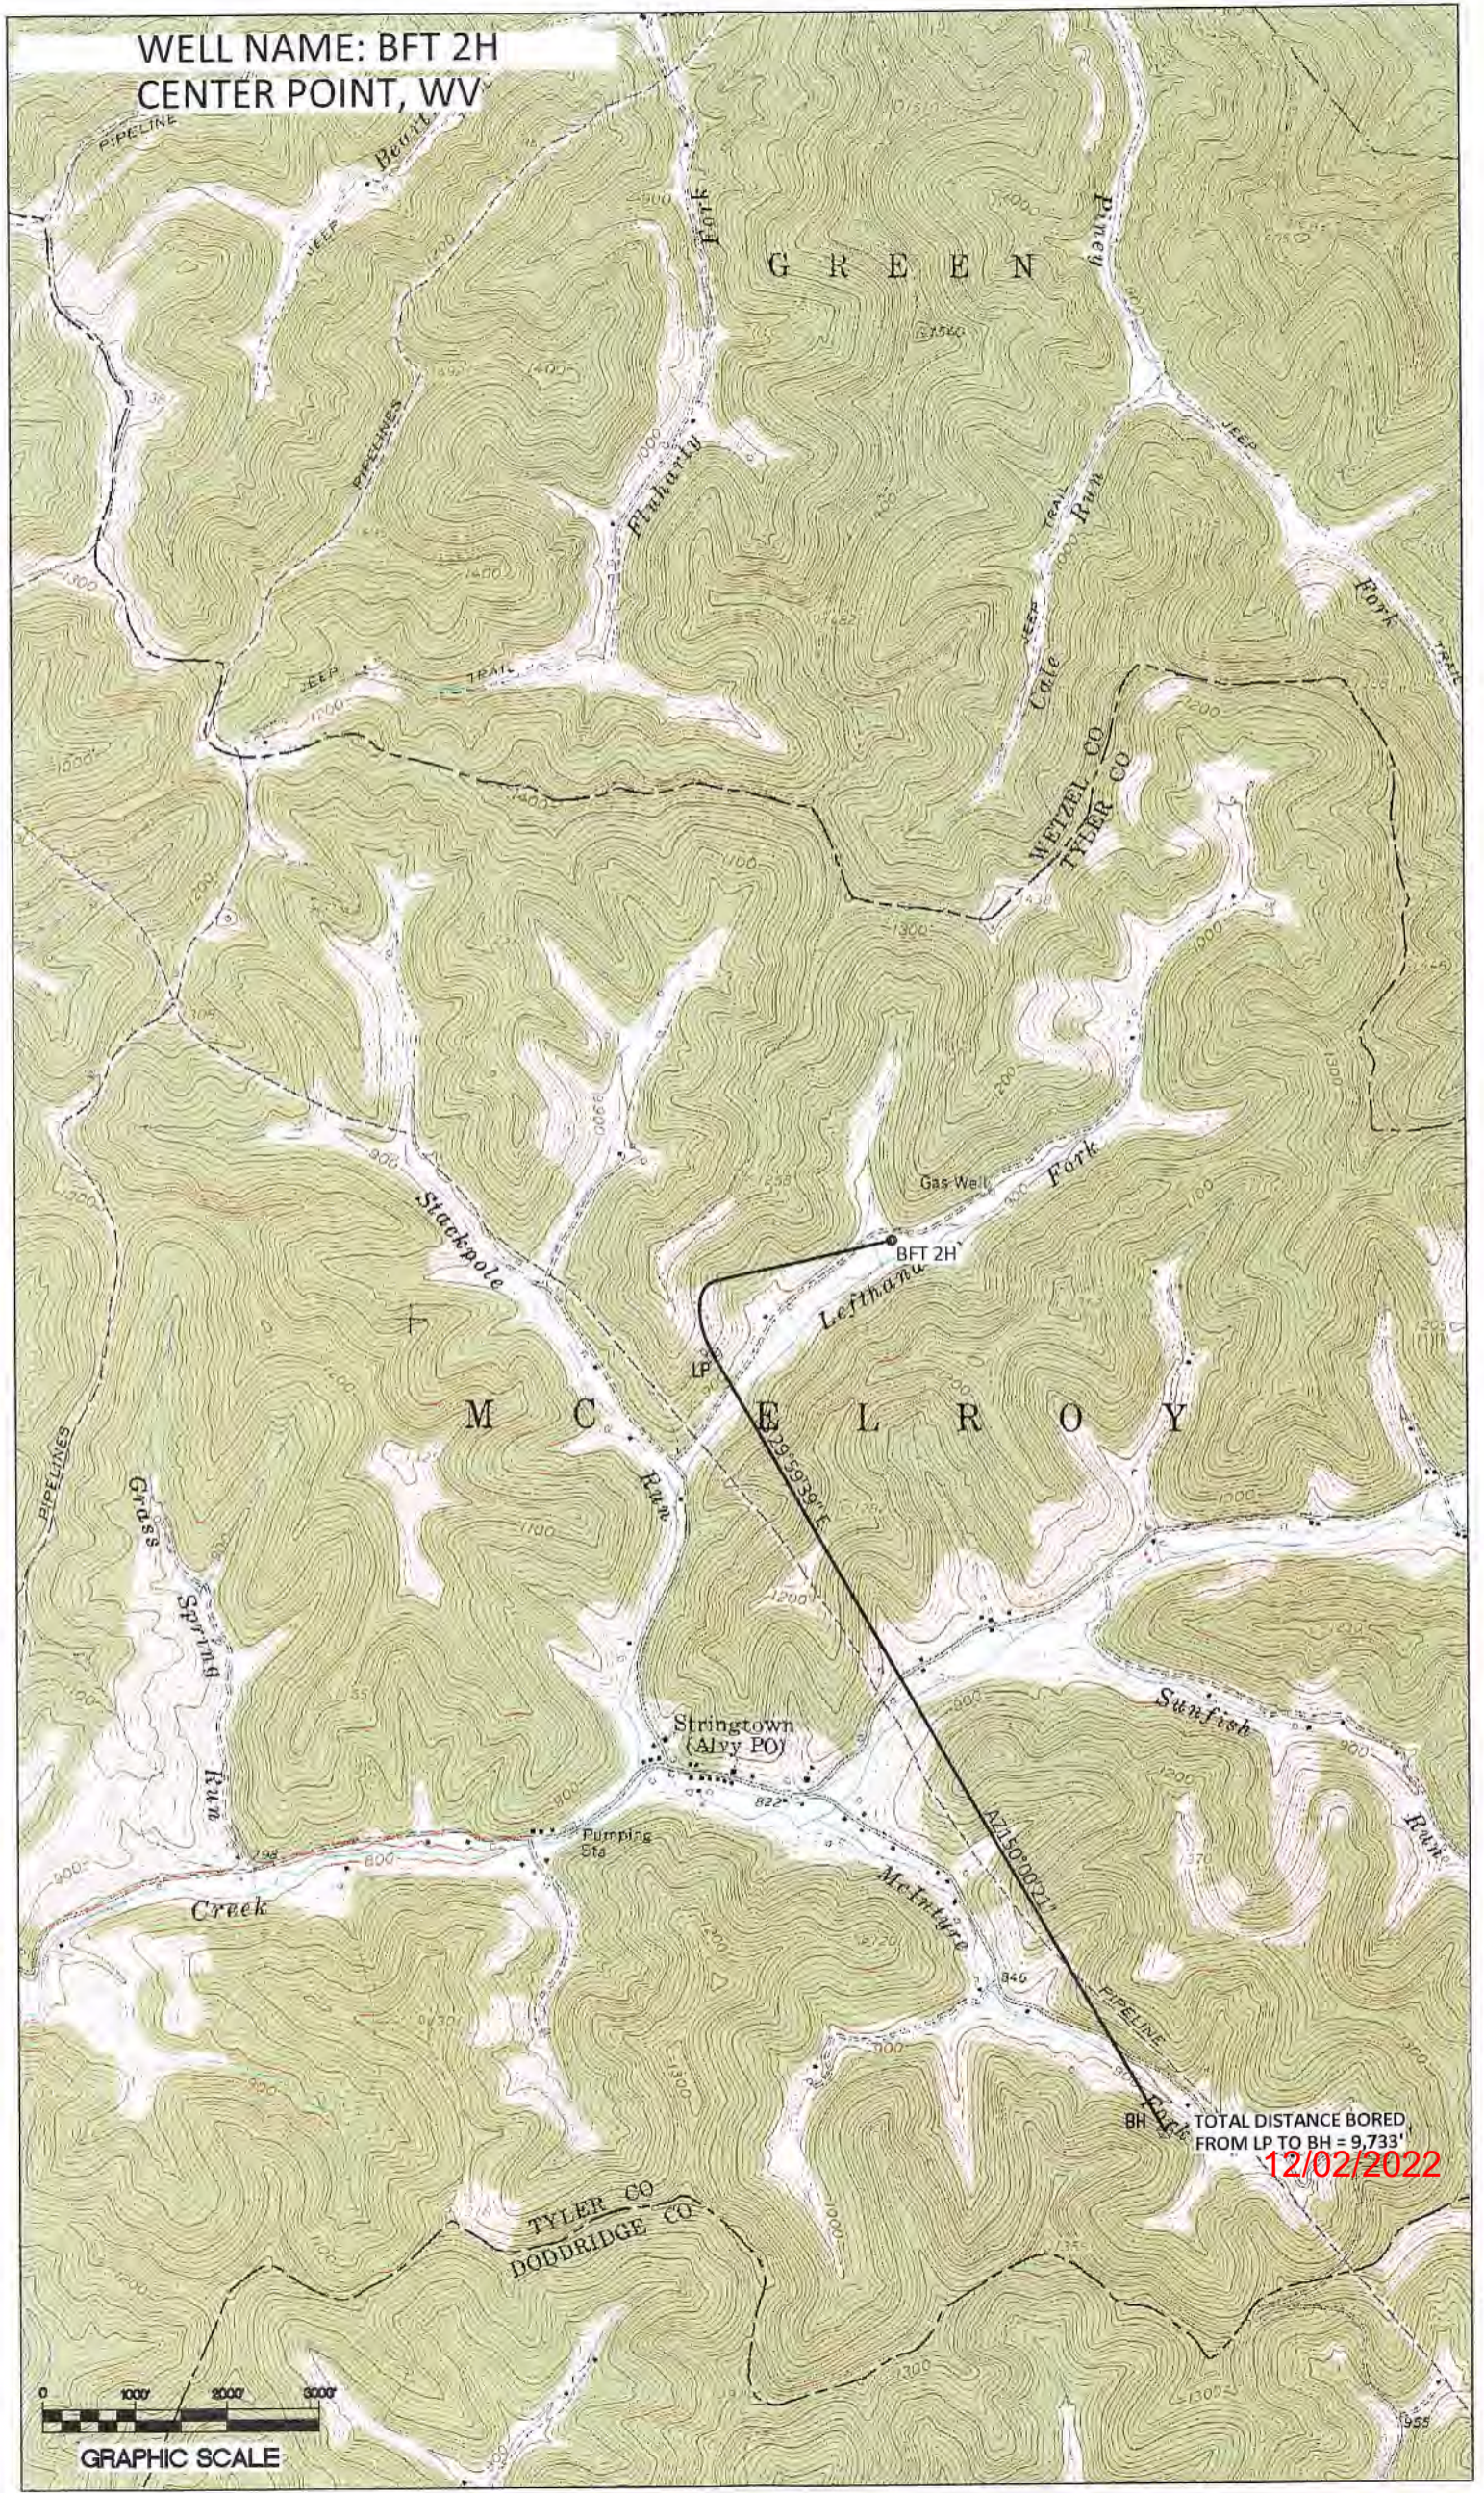

BH TOTAL DISTANCE BORED
FROM LP TO BH = 9,733'

12/02/2022