

LOTTIE B. GRINNELL

F. P. LASURE

I THE UNDERSIGNED, HEREBY CERTIFY THAT THIS MAP IS CORRECT AND SHOWS ALL THE INFORMATION TO THE BEST OF MY KNOWLEDGE AND BELIEF, REQUIRED BY THE OIL AND GAS SECTION OF THE MINING LAWS OF WEST VIRGINIA.

SURVEYOR
FOR NETZEL CO. WEST

ACKNOWLEDGED BEFORE ME A NOTARY PUBLIC THIS ____ DAY OF ____.

MY COMMISSION EXPIRES ON day of 193 -- NOTARY PUBLIC FOR NESTLE CO. WEST L.

W.t-10

WEST VIRGINIA DEPARTMENT OF MINES

OIL & GAS SECTION

PRELIMINARY DATA SHEET NO. 1

File No. Wet-10Well No. 1

M. E. Schapp Company, of Porters Falls
WETZEL COUNTY WV on the H. A. Jennings Farm
 containing acres. Location
Green District, in WETZEL County, W. Va.

The surface of the above tract is owned in fee by H. A.
Jennings of Porters Falls address, and the
 mineral rights are owned by H. A. Jennings of Porters Falls

The oil and gas privileges are held under lease by the
 above named company, and this well is drilled under permit No. _____
 issued by the West Virginia Department of Mines, Oil and Gas Section,
 1929.

Elevation of surface at top of well, _____ Spirit
 Barometric.

The number of feet of the different sized casings used in the well.

16 feet 13 size. Wood conductor.

200 8 feet 10 size, csg. feet _____ sized csg.

1518 feet 8 1/2 size, csg. feet _____ sized csg.

2169 feet 6 1/2 size, csg. feet _____ sized csg.

packer of _____ size, set at _____

packer of _____ size, set at _____

in. casing perforated at _____ feet to _____ feet.

in. casing perforated at _____ feet to _____ feet.

Coal was encountered at _____ feet; thickness _____ inches, and at
 _____ feet; thickness _____ inches; and at _____ feet;
 thickness _____ inches.

liners were used as follows: (Give details) _____

November 21, 1929
 Date.

Approved H. A. Jennings Owner.
 By J. L. Shaeffer (Title)

wet P -.


COMPLETION DATA SHEET NO. 2

FORMATION RECORD

~~the~~ ball was not shot at 3363 feet; well was shot at _____ feet.

Salt salt
Fresh water at feet; fresh water at

Well was ~~producing~~ hole.
dry

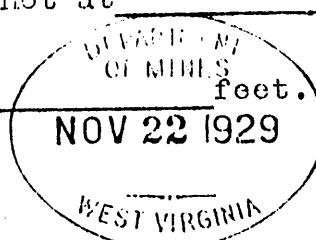

dry November 6 1929 Approved Stock & Company
Date 34 Owner Stock

NOTE: All bottom formations must be noted as indicated above and all key-rocks and oil and gas sands must be recorded under their proper geological names in the district as well as any local names for which strata that may be common to the district.