

LATITUDE 394230

OGIS  
75'10"

5208

LONGITUDE

7'5 OGIS topo location

7.5' 10c	<u>0.15S</u>	15' 10c	<u>3.03S</u>
	<u>0.15W</u>	(calc.)	<u>0.15W</u>

Company \_\_\_\_\_

Farm \_\_\_\_\_

Quad Hundred Manington NW

County \_\_\_\_\_

District church

WELL LOCATION MAP

File No. Wet 117

1) Attach a photo copy of the location of the well on a 7.5 minute Quadrangle with the corresponding Longitude and Latitude.  
 2) Designate the location of the well with the symbol(+).

LATITUDE 39°42'20"

0.185  
0.09W

152°08'

LONGITUDE 80°25'06"



I, the undersigned, hereby certify that this plat is correct to the best of my knowledge and belief.

SIGNED Be D Al  
 TITLE VICE-PRESIDENT

DATE MARCH 15, 1993  
 OPERATORS WELL NO. 7  
 API WELL NO. 103-1565-N

17000

STATE OF WEST VIRGINIA  
 DEPARTMENT OF ENERGY  
 OIL AND GAS DIVISION

WELL TYPE: OIL  GAS  LIQUID INJECTION \_\_\_\_\_ WASTE DISPOSAL \_\_\_\_\_  
 (IE "GAS" PRODUCTION  STORAGE \_\_\_\_\_ DEEP \_\_\_\_\_ SHALLOW )

LOCATION: ELEVATION 1195 WATER SHED CARPO RUN  
 DISTRICT CHURCH COUNTY WETZEL  
 QUADRANGLE HUNDRED

SURFACE OWNER S. MAIN ACREAGE \_\_\_\_\_

OIL & GAS ROYALTY OWNER \_\_\_\_\_ LEASE ACREAGE \_\_\_\_\_  
 LEASE NO. \_\_\_\_\_

PRODUCING FORMATION 4th SAND TOTAL DEPTH 3500

WELL OPERATOR CHELSEA OIL & GAS CO. INC DESIGNATED AGENT AL ANDERSON

ADDRESS BOX 1145 ADDRESS 901 WEST MAIN  
BRIDGEPORT WV 26330 BRIDGEPORT WV 26330  
Section 5

STATE OF WEST VIRGINIA  
DIVISION OF ENVIRONMENTAL PROTECTION  
SECTION OF OIL AND GAS

WELL REGISTER ASSIGNMENT

This API Number 47-103-01565, issued to CHELSEA OIL & GAS, INC is evidence of permission to operate the well that is referenced at the location described on the attached plat, subject to the provisions of Chapters 22 and 22B of the West Virginia Code of 1931, as amended, and all rules and regulations promulgated thereunder. The name and telephone number of the Oil and Gas Inspector for this well is RANDAL MICK  
304-986-3324.

Spills or emergency discharges must be reported to 1-800-654-3312.

Failure to abide by all statutory and regulatory provisions governing all duties and operations hereunder may result in suspension or revocation of your permits and in addition may result in civil and/or criminal penalties.

The enclosed WR-35 must be completed by you and returned to this office. In addition annual production reports must be submitted on this well and failure to do so may require you to plug the well.

Theodore M. Streit  
Chief

By: 

Title: \_\_\_\_\_

Operator's Well No: 7

Farm Name: MAIN, S.

API Well Number : 47-103-01565 N

Date Issued : 01/27/94



STATE OF WEST VIRGINIA  
DEPARTMENT OF MINES  
OIL AND GAS DIVISION

Quadrangle \_\_\_\_\_

Permit No. WET-117-D

WELL RECORD

Oil or Gas Well Oil  
(KIND)

Company Bissett Oil & Gas Company  
Address New Freeport, Pennsylvania  
Farm Stephenson & Mary Main Acres 117.5  
Location (waters) \_\_\_\_\_  
Well No. 7 Elev. 1235  
District Church County Wetzel  
The surface of tract is owned in fee by Julia Mann  
Address Hundred, W. Va.  
Mineral rights are owned by Julia Mann & Heirs  
Address Hundred, W. Va.  
Drilling commenced 9-2-61  
Drilling completed 10-12-61  
Date Shot 10-13-61 From 3130 To 3142  
With 30 qts. 20 qts.  
Open Flow 6/10ths Water in 1 Inch  
/10ths Merc. in \_\_\_\_\_ Inch  
Volume \_\_\_\_\_ Cu. Ft.  
Rock Pressure 20 lbs. 24 hrs.  
Oil 7 bbls., 1st 24 hrs.  
WELL ACIDIZED \_\_\_\_\_

Casing and Tubing	Used in Drilling	Left in Well	Packers
Size			Kind of Packer
16	This was a drilling down		
13	job - all pipe was in		
10	the well.	205'	Size of
8 1/4		1562'	
6 1/2		1970'	Depth set
5 3/16			
3			Perf. top
2			Perf. bottom
Liners Used			Perf. top
			Perf. bottom

CASING CEMENTED \_\_\_\_\_ SIZE \_\_\_\_\_ No. Ft. \_\_\_\_\_ Date \_\_\_\_\_

COAL WAS ENCOUNTERED AT \_\_\_\_\_ FEET \_\_\_\_\_ INCHES  
\_\_\_\_\_ FEET \_\_\_\_\_ INCHES \_\_\_\_\_ FEET \_\_\_\_\_ INCHES  
\_\_\_\_\_ FEET \_\_\_\_\_ INCHES \_\_\_\_\_ FEET \_\_\_\_\_ INCHES


WELL FRACTURED \_\_\_\_\_

RESULT AFTER TREATMENT \_\_\_\_\_

ROCK PRESSURE AFTER TREATMENT \_\_\_\_\_

Fresh Water \_\_\_\_\_ Feet \_\_\_\_\_ Salt Water \_\_\_\_\_ Feet \_\_\_\_\_

Formation	Color	Hard or Soft	Top	Bottom	Oil, Gas or Water	Depth	Remarks
✓ Big Lime			2140	2206			
✓ Big Injun			2206	2440			
Gas					Gas	2308-2310	
Slate & Shells			2440	2529			
Sand			2529	2548			
Slate & Shells			2548	2726			
Lime		Hard	2726	2748			
Sand			2748	2760			
Slate & Shells			2760	2774			
Sand			2774	2790			
Slate & Shells			2790	2862			
Same, Gritty			2862	2890			
Slate & Shells			2890	2905			
Sand			2905	2924			
Slate			2924	2930			
✓ Tifty Foot			2930	2955			
Slate & Shells			2955	2976			
Sand			2976	3025			
Slate			3025	3030			
✓ Sand Gordon Shag			3030	3038			
Red Rock			3038	3039			
✓ Sand Gordon			3039	3060			
Slate & Shells			3060	3077			
Sand			3077	3098			
Slate & Shells			3098	3100			
✓ 4th. Sand			3100	3152			
Oil					Oil	3134-3135	
Slate & Shells			3152	3180			
✓ 5th. Sand			3180	3202			
Slate			3202				
					Total Depth	---3210	

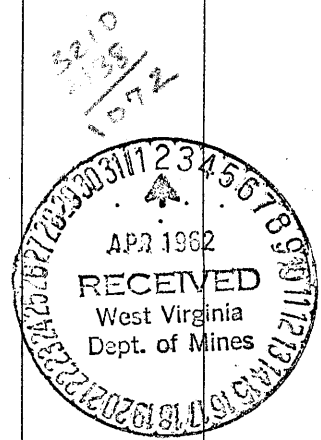

WEST VIRGINIA DEPARTMENT OF MINES

OIL AND GAS DIVISION

W E L L R E C O R D

Permit No. Wet. 117

Oil&Gas Well-

Quad. Not given

(Little of Each)

CASING & TUBING

Company	Cochran & Cochran	10	203	203
Address	Parkersburg	8 1/4	1362	1362
Farm	Stephenson Main Heirs Acres 117	6 5/8	1970	1970
Location	Cappo Run of Fish Creek	2	2138	2138
Well No.	7 Elev. 1235			
District	Church County <u>Wetzel</u>			
Surface	A.D.Snider & Main Heirs			
Address	Hundred, W.Va.			
Mineral	S.Main Heirs, Hundred, W.Va.			
Drilling	Commenced May 12, 1936			
	Completed June 15, 1936			
Date Shot	June 16, 1936 Depth 2124-31			
Open Flow	16/10ths W in 2"			
Rock Press.	140# in 24 hrs.			

Formation Color					Formation Color					
Color	Hor	Top	Base	Result	Color	Hor	Top	Base	Result	
Clay	Yellow	S	15		✓ Sand	White	H	2052	2138	Oil
Rock	White	S	15	60						2125-30
Clay	Red	S	60	170						
Lime	White	H	170	230	TOTAL DEPTH				2138	
Slate	Black	S	230	400						
Lime	White	H	400	475						
Rock	Red	S	475	500						
Slate	Black	S	500	595						
Sand	White	H	595	630						
✓ Fairview										
Coal	Black	S	630	635						
Slate	Black	S	635	700						
Lime	White	H	700	848						
✓ Mapletown										
Coal	Black	S	848	852						
Lime	White	H	852	875						
Slate	Black	S	875	900						
Lime	White	H	900	955						
✓ Pitts. Coal	Black	S	955	963						
Lime	White	H	963	1010						
Red Rock	Red	S	1010	1025						
Lime	White	H	1025	1100						
Slate	Black	S	1100	1120						
Rock	Red	S	1120	1135						
Lime	White	H	1135	1145						
Rock	Red	S	1145	1160						
Slate	Grey	S	1160	1190						
Lime	White	H	1190	1220						
Rock	Red	S	1220	1235						
Lime	White	H	1235	1320						
Slate	Black	S	1320	1350						
Sand	Dark	H	1350	1360						
Slate	Black	S	1360	1370						
Sand	Grey	H	1370	1400						
Slate	Black	S	1400	1480						
✓ Sand	Grey	H	1480	1515	Big Dunkard					
Slate	Black	S	1515	1545						
✓ Sand	White	H	1545	1560						
Slate	Black	S	1560	1650						
Sand	White	H	1630	1660						
Slate	Black	S	1660	1695						
Lime	White	H	1695	1710						
✓ Sand	White	H	1710	1770						
Slate	Black	S	1770	1820						
✓ Sand	White	H	1820	1870						
Slate	Black	S	1870	1890						
✓ Sand	White	H	1890	1955	Gas					
Lime	White	H	1955	2052	2114-18					