


4710300153W

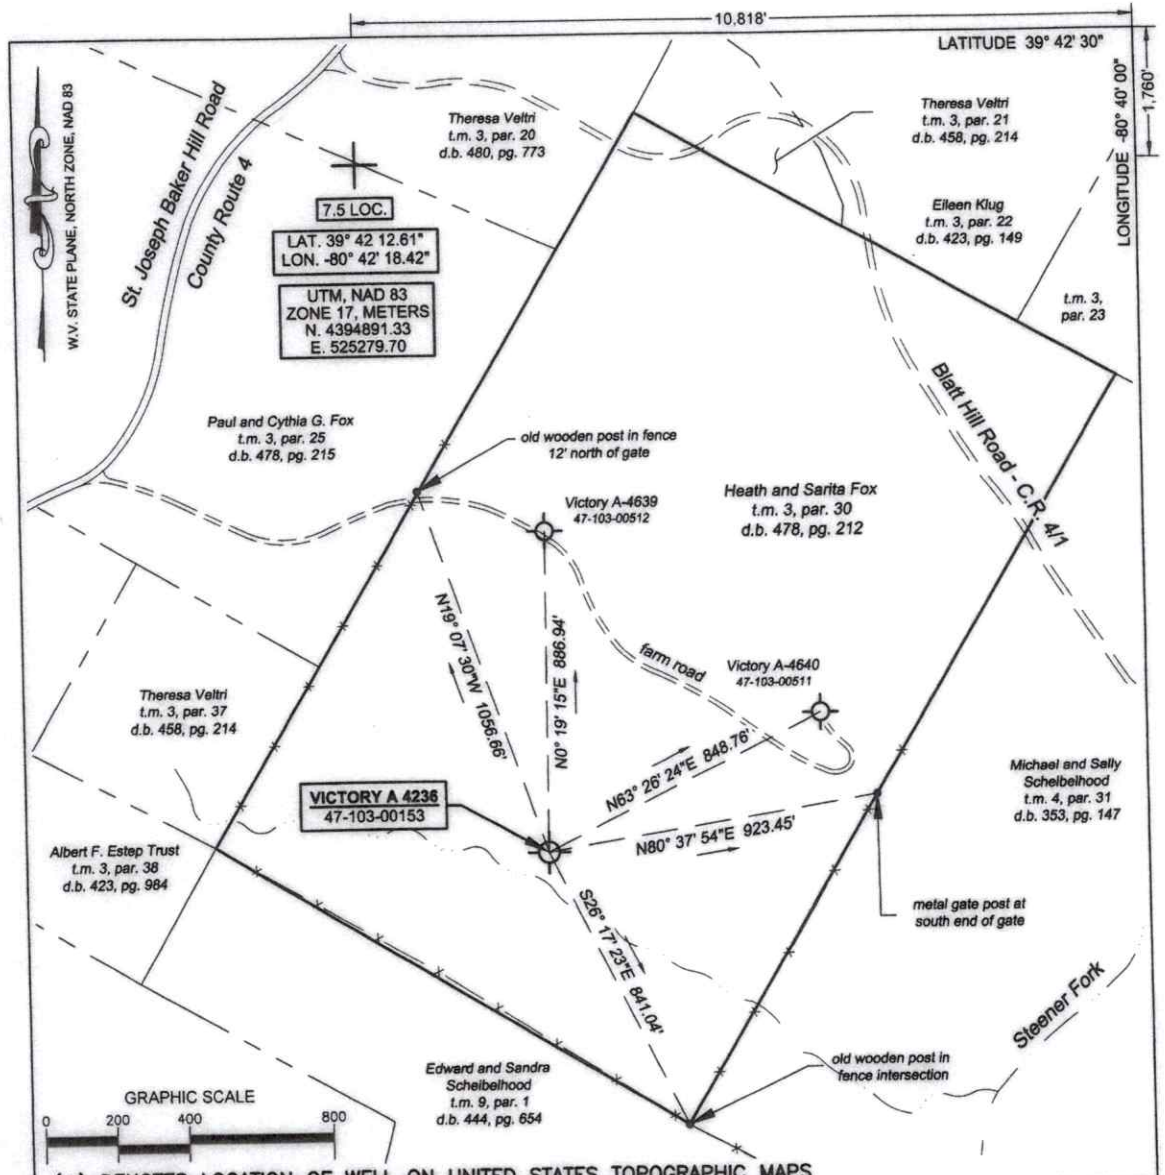


(+) DENOTES LOCATION OF WELL ON UNITED STATES TOPOGRAPHIC MAPS

FILE No 2101-2345-001-004  
 DRAWING No. VICTORY A-4236  
 SCALE 1"=400  
 MINIMUM DEGREE OF ACCURACY 1:200  
 PROVEN SOURCE OF ELEVATION TRIMBLE R10  
 GPS UNIT

I THE UNDERSIGNED, HEREBY CERTIFY THAT THIS PLAT IS CORRECT TO THE BEST OF MY KNOWLEDGE AND BELIEF AND SHOWS ALL THE INFORMATION REQUIRED BY LAW AND THE REGULATIONS ISSUED AND PRESCRIBED BY THE DIVISION OF ENVIRONMENTAL PROTECTION.

(SIGNED) R. Thaw  
 ROBERT F. THAW PS #965

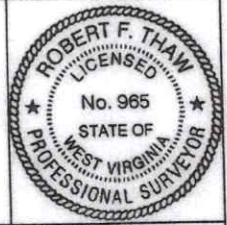

STATE OF WEST VIRGINIA  
 DIVISION OF ENVIRONMENTAL PROTECTION  
 OFFICE OF OIL AND GAS

NITRO, WV

DATE MARCH 22 2022  
 OPERATOR'S WELL No. 4236  
 API WELL No. 47 103 - 00153W

WELL TYPE: OIL  GAS  LIQUID INJECTION  WASTE DISPOSAL  STATE COUNTY PERMIT  
 (IF "GAS") PRODUCTION  STORAGE  DEEP  SHALLOW

LOCATION: ELEVATION 1152.6' WATER SHED STEENER FORK - A TRIBUTARY OF FISH CREEK  
 DISTRICT PROCTOR COUNTY WETZEL  
 QUADRANGLE WILEYVILLE, WV

SURFACE OWNER HEATH FOX AND SARITA FOX ACREAGE 75 ACRES  
 OIL & GAS ROYALTY OWNER THERESA AND JOSEPH VELTRI-TRUSTEES OF THE ALBERT F. ESTEP TRUST  
 LEASE ACREAGE 75 ACRES LEASE NO. 3027451-000, 3032044-000

PROPOSED WORK: DRILL  CONVERT  DRILL DEEPER  REDRILL  FRACTURE   
 STIMULATE  PLUG OFF OLD FORMATION  PERFORATE NEW FORMATION   
 OTHER PHYSICAL CHANGE IN WELL (SPECIFY) \_\_\_\_\_  
 PLUG AND ABANDON  CLEAN OUT AND REPLUG

TARGET FORMATION MAXTON ESTIMATED DEPTH 2955  
 WELL OPERATOR COLUMBIA GAS TRANSMISSION, LLC DESIGNATED AGENT BRAD NELSON  
 ADDRESS PO BOX 1273, CHARLESTON, WV 25325-1273 ADDRESS 455 RACETRACK ROAD WASHINGTON, PA 15301