



West Virginia Department of Environmental Protection
Office of Oil and Gas

WELL LOCATION FORM: GPS

API: 47-103-00177-00-00 WELL NO.: Victory A 3562

FARM NAME: BLATT, ELIZABETH

RESPONSIBLE PARTY NAME: Brad Nelson

COUNTY: Wetzel DISTRICT: Proctor

QUADRANGLE: Wileyville

SURFACE OWNER: Joseph Hohman and Mary Hohman

ROYALTY OWNER: Albert L. Hohman; Lavinia M. Bauer, Agent; William H. Singer; Margarty A. Tracey

UTM GPS NORTHING: 4394244.364 m

UTM GPS EASTING: 524946.506 m GPS ELEVATION: 373.125 m (1224')

The Responsible Party named above has chosen to submit GPS coordinates in lieu of preparing a new well location plat for a plugging permit or assigned API number on the above well. The Office of Oil and Gas will not accept GPS coordinates that do not meet the following requirements:

1. Datum: NAD 1983, Zone: 17 North, Coordinate Units: meters, Altitude: height above mean sea level (MSL) – meters.
2. Accuracy to Datum – 3.05 meters
3. Data Collection Method:

Survey grade GPS X: Post Processed Differential X

Real-Time Differential _____

Mapping Grade GPS _____: Post Processed Differential _____

Real-Time Differential _____

4. **Letter size copy of the topography map showing the well location.**

I the undersigned, hereby certify this data is correct to the best of my knowledge and belief and shows all the information required by law and the regulations issued and prescribed by the Office of Oil and Gas.

Brad Nelson
Signature

Storage Engineer
Title

12/12/2022
Date

RECEIVED
Office of Oil and Gas
MAR 29 2023
WV Department of
Environmental Protection

04/28/2023

(POWHATAN POINT)



4710300177P

WILEYVILLE QUADRANGLE
WEST VIRGINIA
TOPOGRAPHIC SERIES
(CAMERON)


080° 43' 34.3953" W
039° 43' 09.3823" N

(GLEN EASTON)

080° 41' 13.3905" W
039° 43' 09.3823" N

(NEW MARTINSVILLE)

(LITTLETON)

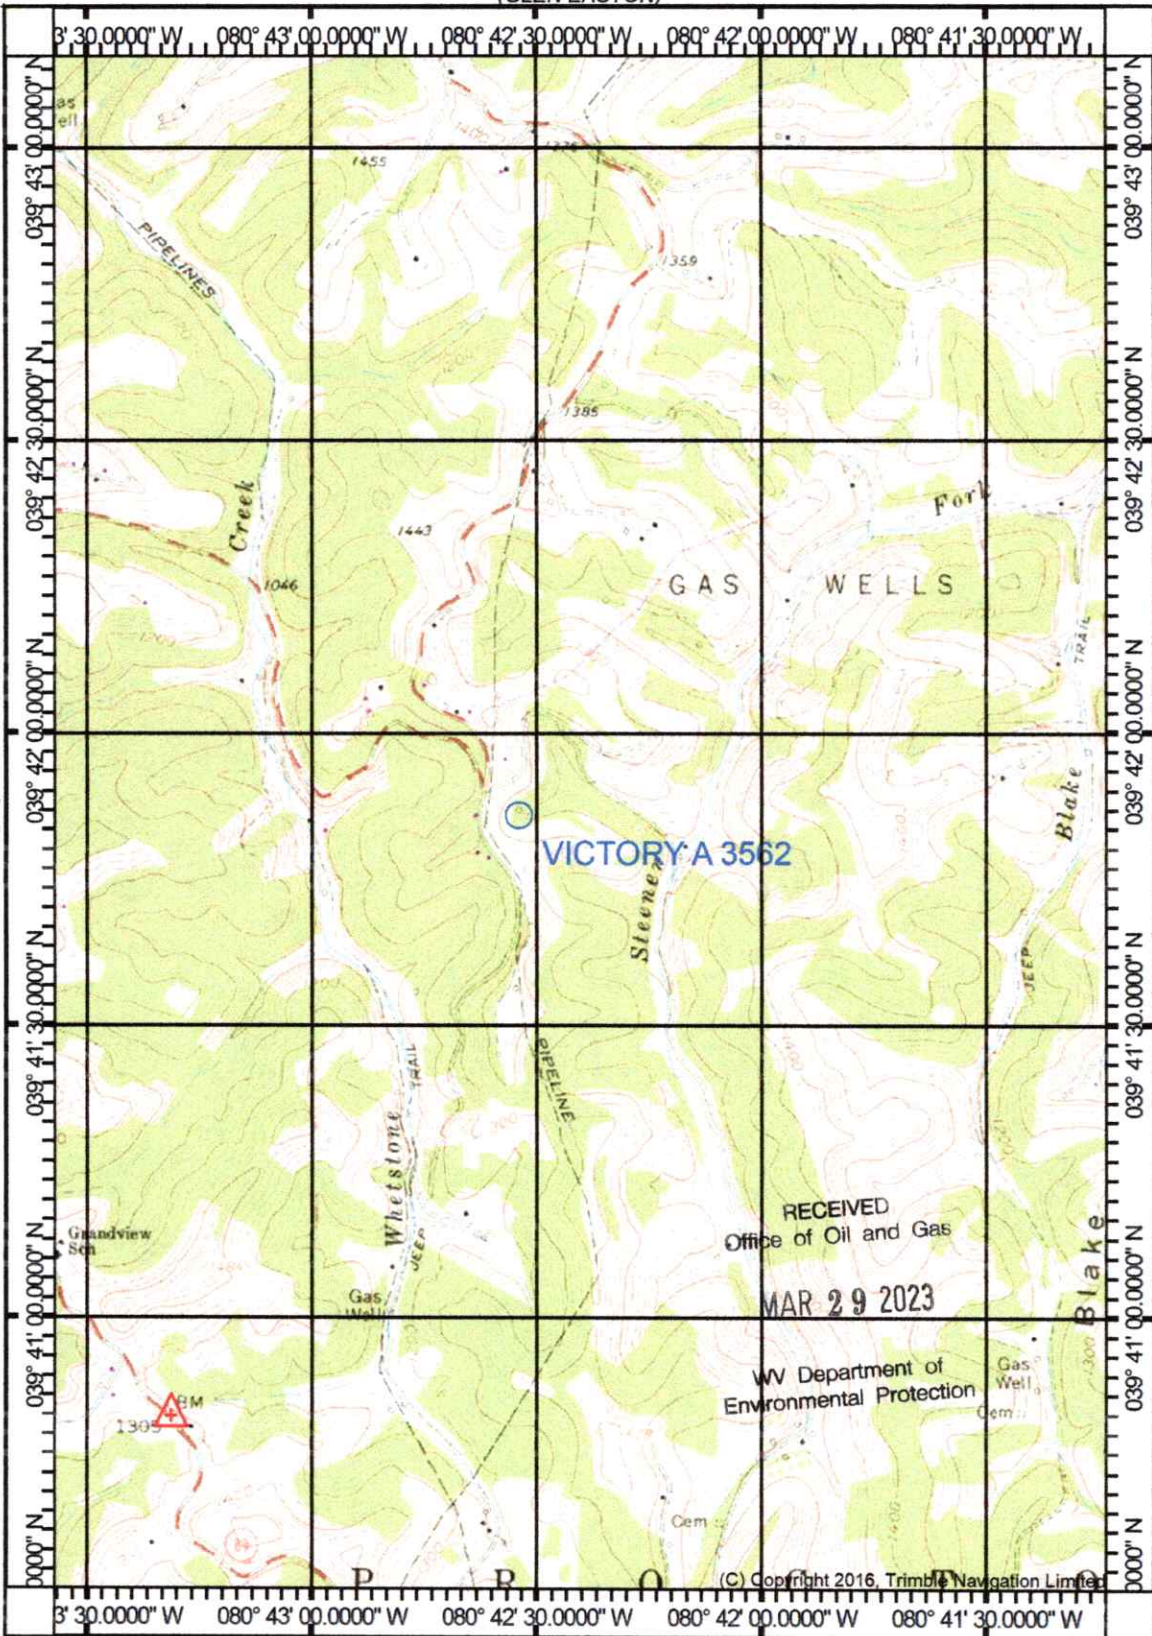

039° 40' 31.6039" N
080° 43' 34.3953" W

(PORTERS FALLS)

Declination



(PINE GROVE)
SCALE 1:24000


Printed: Tue May 24, 2022
080° 41' 13.3905" W
039° 40' 31.6039" N

(BIG RUN)

Produced by Trimble Terrain Navigator Pro
Topography based on USGS 1:24,000
Maps

North American 1983 Datum (NAD83)

To place on the predicted North American
1927 move the projection lines 9M N and
16M E

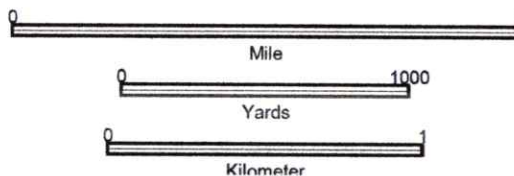

CONTOUR INTERVAL 20 FT

39080-F5-TM-024
WILEYVILLE, WV
JAN 1 1976
04/28/2023

SM