
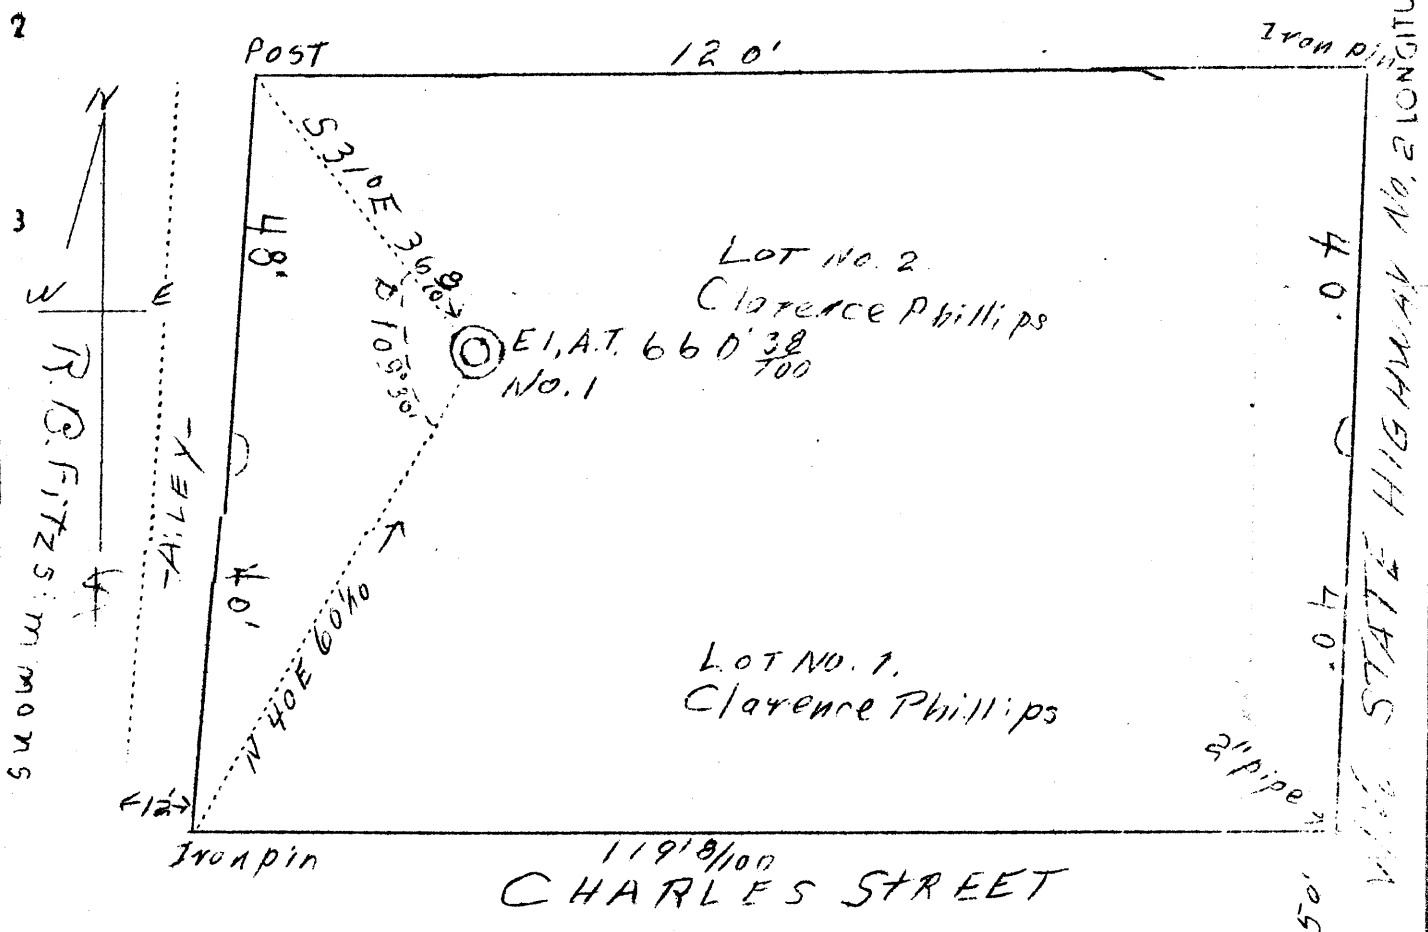


LOT No 3  
Harold Powell

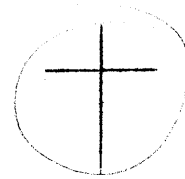

LOT No. 6  
Robert Chance

1.4 S  
1.7 W

New location

Actual lat. & long. of well  
Given

Company Dan Henthorn  
Address Middlebourn, W. Va.  
Name Clarence Phillips  
Address 2 lots, Proctor, W. Va.  
Farm (Farm) No. One  
Elevation (S.P.) 660.38  
Quadrangle New Martinsville  
County Wetzel  
District Proctor  
Engineer F. W. Parsons  
Eng. Reg. No. 203  
File No. W.  
Date July 9, 1938  
Scale 1" = 20'

STATE OF WEST VIRGINIA  
Department of Mines  
OIL & GAS DIVISION  
Charleston

WELL LOCATION MAP

File No. Wet-187

x Denotes location of well on U. S. Topographic Maps, scale 1 to 62,500, latitude and longitude lines being represented by border lines as shown.

- Denotes one inch spaces on border line of original tracing.

WEST VIRGINIA DEPARTMENT OF MINES

OIL & GAS DIVISION

WELL RECORD

Permit No. Wgt-187

Gas Well

New Martinsville Quad.

CASING & TUBING

Company	Dan Menthorn	8-1/4	40	40
Address	New Martinsville, W. Va.	6-5/8	120	120
Farm	Clarence Philips ACRES lot	5-3/16	520	520
Location	Proctor	2	565	565
Well No.	One ELEV. <del>560.34</del> 660.38			
District	Proctor - Wetzel County			Packer - Anchor
Surface	Clarence Philips, Proctor, W. Va.			Size - 5-3/16
Mineral	-			Depth set - 550'
Drilling commenced	July 10, 1938			
Drilling completed	July 22 1938			
Open Flow	38/10ths Merc. in 2-inch			
Volume	One million c.f.			
Rock Pressure	150 lbs. 12 hrs.			
Fresh Water	80			

Formation Color <sup>Har</sup> s TOP Base Result Formation Color <sup>Har</sup> s TOP Base Result

Formation	Color	<sup>Har</sup> s	TOP	Base	Result	Formation	Color	<sup>Har</sup> s	TOP	Base	Result
Soil	brn.	s	0	10							
Shale	blue	s	10	30							
Lime	wh.	h	80	110							
Slate	wh.	s	110	160							
← Coal ANT	blk.	s	160	162							
Lime	wh.	h	162	200							
Slate	wh.	s	200	220							
Slate	blk.	s	220	230							
← Coal PLY	blk.	s	230	232							
Lime	wh.	h	232	250							
Slate	wh.	s	250	285							
Sand	wh.	h	285	315							
Lime	wh.	h	315	340							
Slate	blue	s	340	360							
Lime	wh.	h	360	400							
Red Rock	red	s	400	494							
← Sand MOUNTAIN	wh.	s	494	520							
Slate	blue	s	520	550							
← Sand WETZEL	wh.	s	550	565							