

3.19 S  
0.21 W

COAL OWNED BY \_\_\_\_\_  
*Cleaned Out*  
 NEW LOCATION.....   
 DRILL DEEPER.....   
 ABANDONMENT.....

COMPANY The Manufacturers Light & Heat Co.  
 ADDRESS 800 Union Trust Bldg. Pittsburgh Pa.  
 FARM Clarence Blatt et al  
 TRACT \_\_\_\_\_ ACRES 45 LEASE No. 26470  
 WELL (FARM) No. 2 SERIAL No. F15652  
 ELEVATION (SPIRIT LEVEL) 1254.4'  
 QUADRANGLE Littleton  
 COUNTY Wetzel DISTRICT Proctor  
 ENGINEER Thom. E. Virgin E.L.  
 ENGINEER'S REGISTRATION No. 1503  
 FILE No. \_\_\_\_\_ DRAWING No. Y-13-869  
 DATE Aug. 17, 1953 SCALE 1" = 400'

STATE OF WEST VIRGINIA  
 DEPARTMENT OF MINES  
 OIL AND GAS DIVISION  
 CHARLESTON

**WELL LOCATION MAP**

FILE No. Wet-208-REDRILL

+ DENOTES LOCATION OF WELL ON UNITED STATES TOPOGRAPHIC MAPS. SCALE 1 TO 62,500. LATITUDE AND LONGITUDE LINES BEING REPRESENTED BY BORDER LINES AS SHOWN.  
 - DENOTES ONE INCH SPACES ON BORDER LINE OF ORIGINAL TRACING.



STATE OF WEST VIRGINIA  
DEPARTMENT OF MINES  
OIL AND GAS DIVISION

WELL RECORD

Permit No. WET-208-Redrill


Oil or Gas Well Stor.  
(KIND)

Company THE MANUFACTURERS LIGHT AND HEAT CO.  
Address 800 Union Trust Bldg., Pgh., Penna.  
Farm Clarence Blatt Acres 45  
Location (waters) \_\_\_\_\_  
Well No. 2-4261 Elev. 1254.4'  
District Proctor County Wetzel  
The surface of tract is owned in fee by \_\_\_\_\_  
Address \_\_\_\_\_  
Mineral rights are owned by \_\_\_\_\_  
Address \_\_\_\_\_  
Drilling commenced June 2, 1953  
Drilling completed March 12, 1954  
Date Shot \_\_\_\_\_ From \_\_\_\_\_ To \_\_\_\_\_  
With \_\_\_\_\_  
Open Flow 0 /10ths Water in 3/8 Inch  
\_\_\_\_\_ /10ths Merc. in \_\_\_\_\_ Inch  
Volume 0000 Cu. Ft.  
Rock Pressure 0 lbs. \_\_\_\_\_ hrs.  
Oil \_\_\_\_\_ bbls., 1st 24 hrs.  
Fresh water \_\_\_\_\_ feet \_\_\_\_\_ feet  
Salt water \_\_\_\_\_ feet \_\_\_\_\_ feet

Casing and Tubing	Used in Drilling	Left in Well	Packers
Size			Kind of Packer
16			
13			
10		306'1"	Size of
8 1/4		1396'7"	
7"		1579'9"	Depth set
5 3/16			
4"		2099'9"	Perf. top
2			Perf. bottom
Liners Used			Perf. top
			Perf. bottom

CASING CEMENTED	SIZE	No. Ft.	Date
COAL WAS ENCOUNTERED AT		FEET	INCHES
	FEET	INCHES	FEET
	FEET	INCHES	FEET

Formation	Color	Hard or Soft	Top	Bottom	Oil, Gas or Water	Depth Found	Remarks
Top of Maxon Sand			2083		Schlumberger	Measurement	
Bottom of Maxon Sand				2125			
Lead Plug Set			2125	2128			
Total Depth				2125			
					489'4" of old 8 1/4" casing fished out of well		
					10" casing point 303' cemented 175 bags		
					8" casing point 1385' cemented 250 bags		
					7" casing point 1566' cemented 225 bags		
					4" tubing point 2083' cemented 300 bags		
					Centralizers set at the following depths		
					1 - 162'		
					2 - 679'		
					3 - 1092'		
					4 - 1670'		
					5 - 1885'		
					6 - 1980'		
					7 - 2073'		

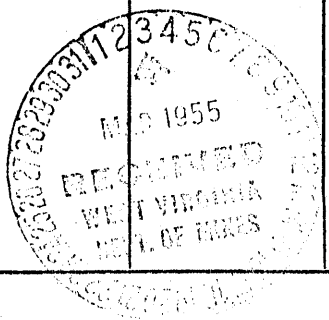

WEST VIRGINIA DEPARTMENT OF MINES

OIL & GAS DIVISION

WELL RECORD

Permit No. Wet-208

Dry Hole

Littleton Quad.

CASING & TUBING

Company	J. H. Ferrell	10	290	290
Address	Grantsville, W. Va.	8-1/4	1107	1107
Farm	Clarence Blatt ACRES 45	6-5/8	1530	1580
Well No.	One ELEV. 1265	5-3/16	2235	2235
District	Proctor - Wetzel County			
Mineral	Clarence Blatt, Belee, W. Va.			
Drilling commenced	Oct. 14, 1938			
Drilling completed	Nov. 5, 1938			
Shot	-			
Open Flow	-			
Volume	-			
Rock Pressure	-			
Water	-			

Formation Color					Hor	TOP	Base	Result	Formation Color					
					S									
Clay	yel.	s	0	14					Berea Grit			2725	2775	
Sand	yel.	s	14	35					Slate & Shells			2775	2828	
Slate	wh.	s	35	90					Sand			2828	2832	
Red Rock	red	s	90	110					Lime shells			2832	2880	
Sand	yel.	s	110	150					Slate			2880	2910	
Slate & Lime	wh.	s	150	190					Red Rock			2910	2990	
Lime	wh.	h	190	220			W-220		Slate & shells			2990	3000	
Slate			220	255					Sand			3000	3020	
Lime	wh.	h	255	265					Slate			3020	3030	
Red Rock	red	s	265	275					Shell			3030	3060	
Slate	wh.	s	275	370					Gordon			3085		
Red Rock	red	s	370	380					Fourth			3112	3125	
Slate	wh.	s	380	495					Shells			3125	3140	
Red Rock	red	s	495	500										
Slate shells			500	715					Total depth					3235
Sand	wh.	h	715	735										
Slate	wh.	s	735	780										
Lime	wh.	h	780	790										
Red Rock	red	s	790	810										
Slate & Lime	wh.	h	810	840										
Lime	wh.	h	840	955										
Mapletown Coal		s	955	960										
Lime	wh.	h	960	1076										
Pittsburgh Coal		s	1076	1084			Water							
Slate	wh.	s	1084	1110										
Red Rock	red	s	1110	1145										
Sand	wh.	h	1145	1160										
Slate	wh.	h	1160	1185										
Red Rock	red	s	1185	1285										
Slate	wh.	s	1285	1350										
Red Rock	red	s	1350	1360										
Slate			1360	1425										
Little Dunkard		h	1425	1460										
Slate			1460	1548										
Red Rock	red	s	1548	1560										
Slate	wh.	s	1560	1580										
Lime	wh.	h	1580	1610										
Slate	wh.	s	1610	1640										
Sand		h	1640	1675										
Slate & Shells		s	1675	2070										
Lime	drk	h	2070	2082			W 2090							
Sand	wh.	s	2082	2122										
Slate	blk.	s	2122	2130										
Maxon			2170	2202										
Slate			2202	2212										
Big Lime			2212	2230										
Big Injun			2230	2480										
Slate			2480	2625										

1265  
1265  
1265  
1265

C

2269  
1265  
1004  
2269

2212  
1265  
947

2170  
1265  
905