


LATITUDE 39° 45'

LONGITUDE 80° 45'

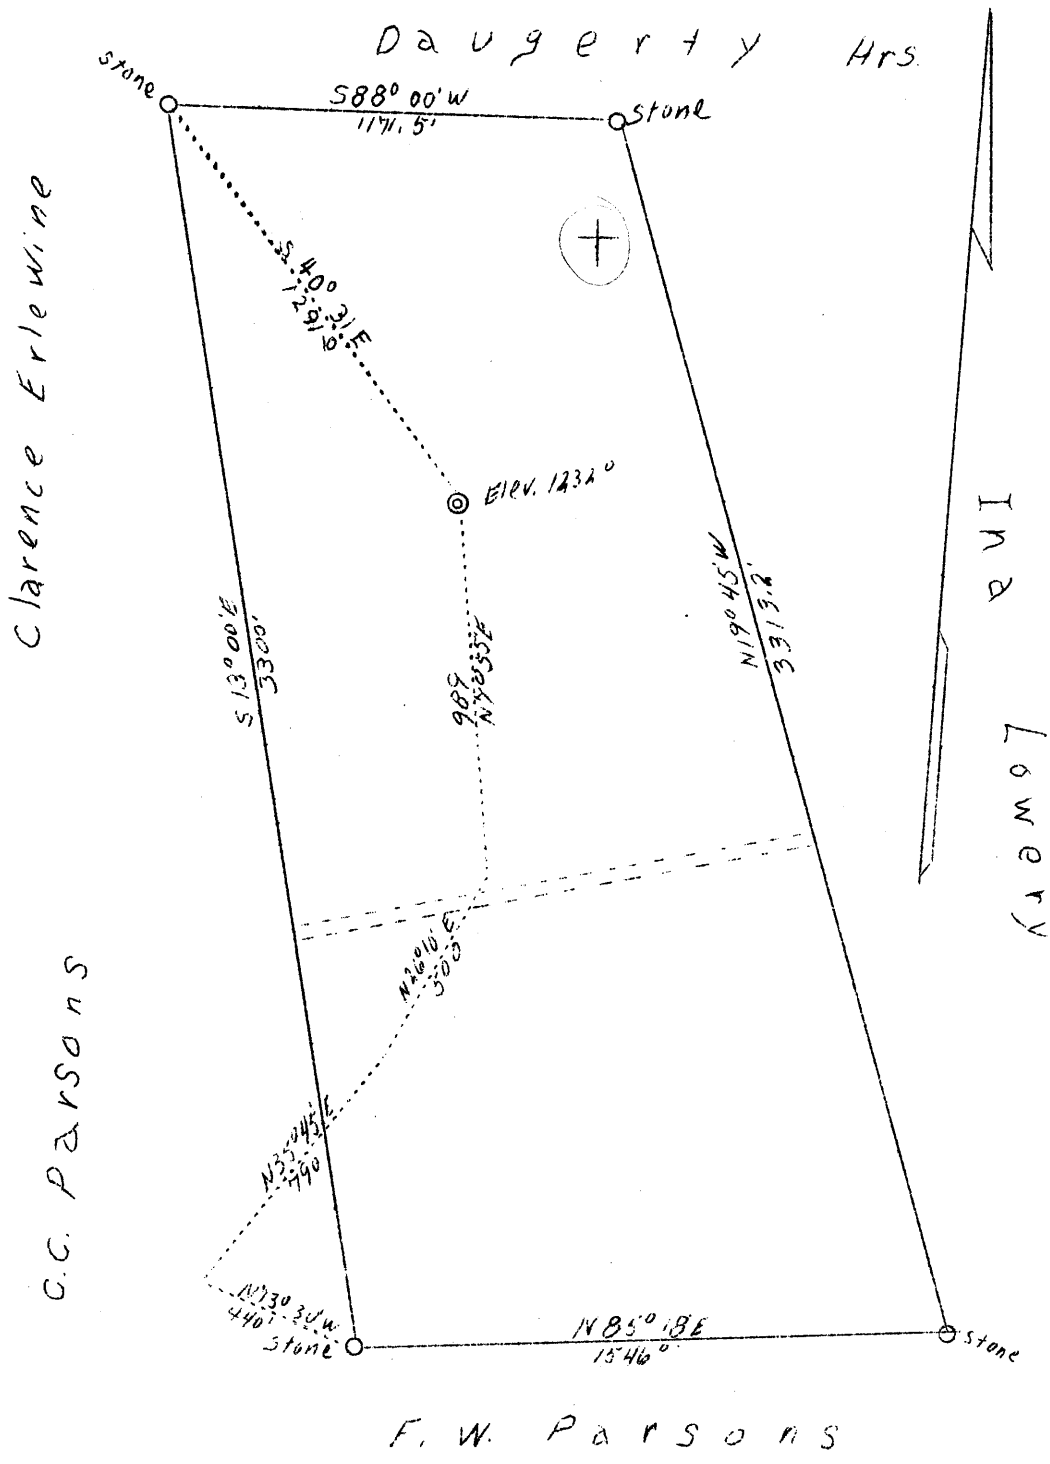

abd aug 41

Company W. K. Mason
 Address Waynesburg, Pa.
 Farm Martha Wayman
 Tract One
 Acres 101
 Well (Farm) No. One
 Quadrangle New Martinsville N.E.
 County Wetzel
 District Proctor
 Engineer Geo. L. McIntire
 Eng. Reg. No. -
 Date Nov. 4, 1938
 Scale 500' - 1"

el-1232

STATE OF WEST VIRGINIA
 Department of Mines
 OIL & GAS DIVISION
 Charleston

WELL LOCATION MAP

File No. WEE-206 209

x Denotes location of well on U. S. Topographic Maps, scale 1 to 62,500, latitude and longitude lines being represented by border lines as shown.

- Denotes one inch spaces on border line of original tracing.

WEST VIRGINIA DEPARTMENT OF MINES

OIL & GAS DIVISION

WELL RECORD

Permit No. Wet-209

Gas Well

New Martinsville Quad.

CASING & TUBING

Company	W. K. Mason, et al	6-5/8	875
Address	293 W. High St., Waynesburg, Pa.	5-3/16	1102 1102
Farm	Martha Wayman ACRES 101	2	1224
Location	Ohio River		
Well No.	One ELEV. 1232	Packer - Anchor	
District	Proctor - Wetzel County	Size - 2x5-3/16	
Surface	Martha Wayman, Proctor, W. Va.	Depth set - 1152	
Drilling commenced	Nov. 23, 1938	Perf. top - 1173	
Drilling completed	Dec. 10, 1938	Perf. bot. - 1178	
Shot	-		
Open Flow	10/10ths Water in 2 inch	Coal Encountered:	
Volume	149,200 c.f.	Feet Inches	
Rock Pressure	145 lbs. - hrs.	427	
Water	-	745	
		829	

FORMATION COLOR ^{H₂} TOP Base RESULT FORMATION COLOR ^{H₂} TOP Base RESULT

FORMATION	COLOR	^{H₂}	TOP	Base	RESULT	FORMATION	COLOR	^{H₂}	TOP	Base	RESULT
Clay		s	0	10							
Sand		s	10	30							
Red Rock		s	30	40							
Sand		s	40	70							
Red Rock		e	70	120							
White Slate		s	120	150							
Red Rock		s	150	200							
White slate		s	200	230							
Red Rock		s	230	248							
Sand		s	248	298							
Slate		s	298	305							
Red Rock		s	305	320							
Blue Slate		s	320	377							
Sand		h	377	392							
Sandy Shale		s	392	421							
Slate		s	421	427							
Washington Coal		s	427	432							
Sandy Shale		s	432	494							
Coal Blossom		s	494	495							
Slate		s	495	576							
Lime		h	576	594							
Red Rock		s	594	604							
Sand		s	604	626							
Slate		s	626	745							
Coal Blossom		s	745	747							
Lime		s	747	777							
Slate		s	777	796							
Black Shale		s	796	801							
Slate		s	801	806							
Lime		s	806	824							
Slate		s	824	829							
Pgh. Coal		s	829	831							
Slate		s	831	875							
Lime		s	875	878							
Slate		s	878	922							
Lime		s	922	980							
Red Rock		s	980	1013							
Slate		h	1013	1025							
Red Rock		s	1025	1093							
Sand		s	1093	1113							
Slate		s	1113	1145							
White Lime		h	1145	1164							
Sand		s	1164	1189	Gas 1165-1169						
Slate		s	1189	1200							
Sand		s	1200	1219							
Slate		s	1219	1224							
Total Depth				1224							