


LATITUDE 39°45'

LONGITUDE 80°45'

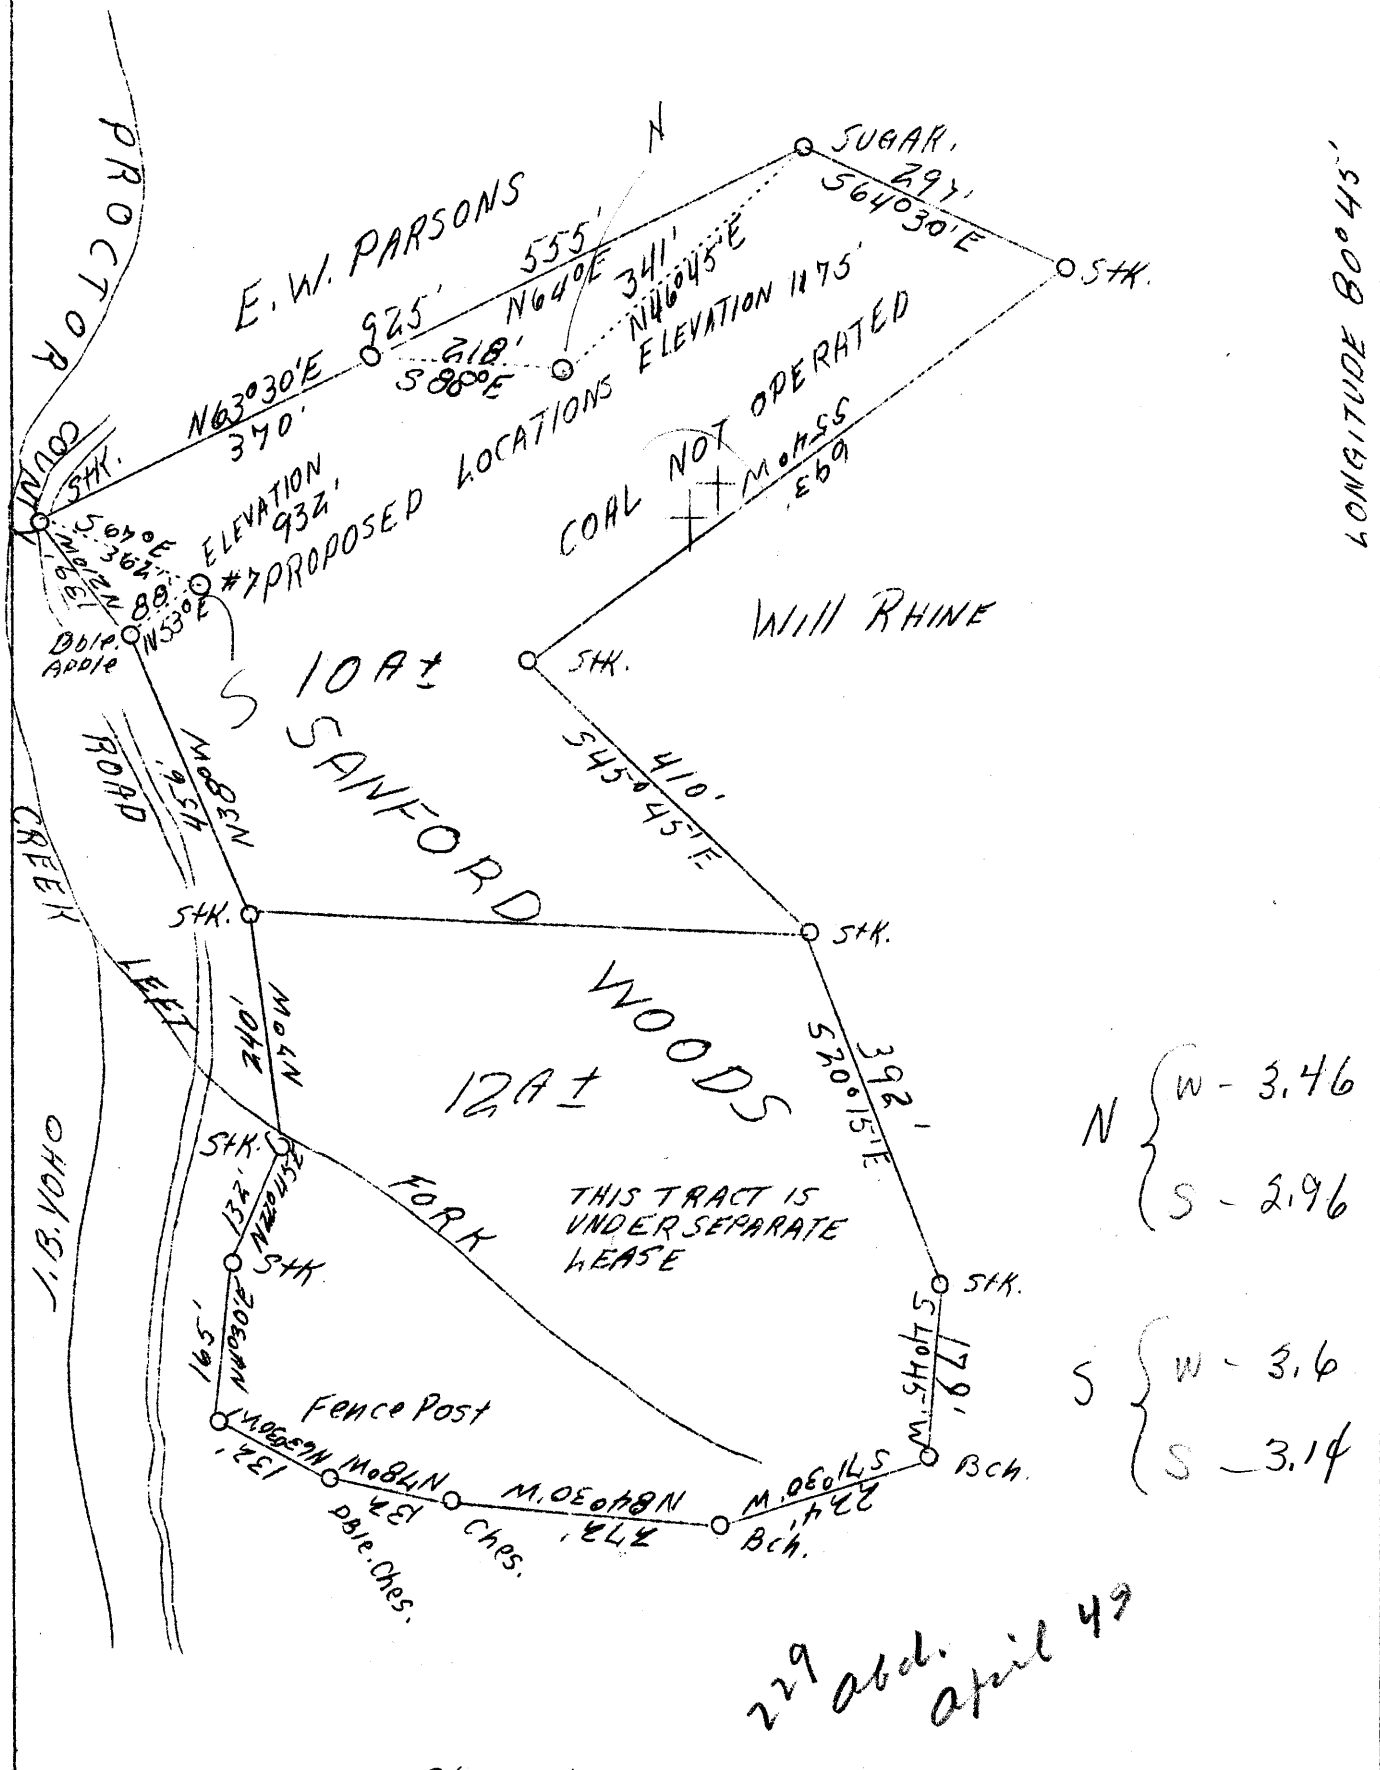

Sheet No. 2

| | |
|---------------|----------------------|
| Company | A.J.Klug |
| Address | Proctor, W.Va. |
| Farm | Sanford Woods |
| Tract | 1 |
| Acres | 10 |
| Well(Farm)No. | 1 & 2 |
| Quadrangle | New Martinsville N.E |
| County | Wetzel |
| District | Proctor |
| Eng. | I.G.Klug |
| Date | 11/25/38 |
| Scale | 1" = 200' |

STATE OF WEST VIRGINIA
 Department of Mines
 OIL AND GAS DIVISION
 Charleston

WELL LOCATION MAP

File No. Wet 229-230
 # 1 & 2

x Denotes location of well on U.S. Topographic Maps, scale 1 to 62,500.

- Denotes one inch spaces on border line of original tracing.