


Lat 39 45

80 40

Longitude

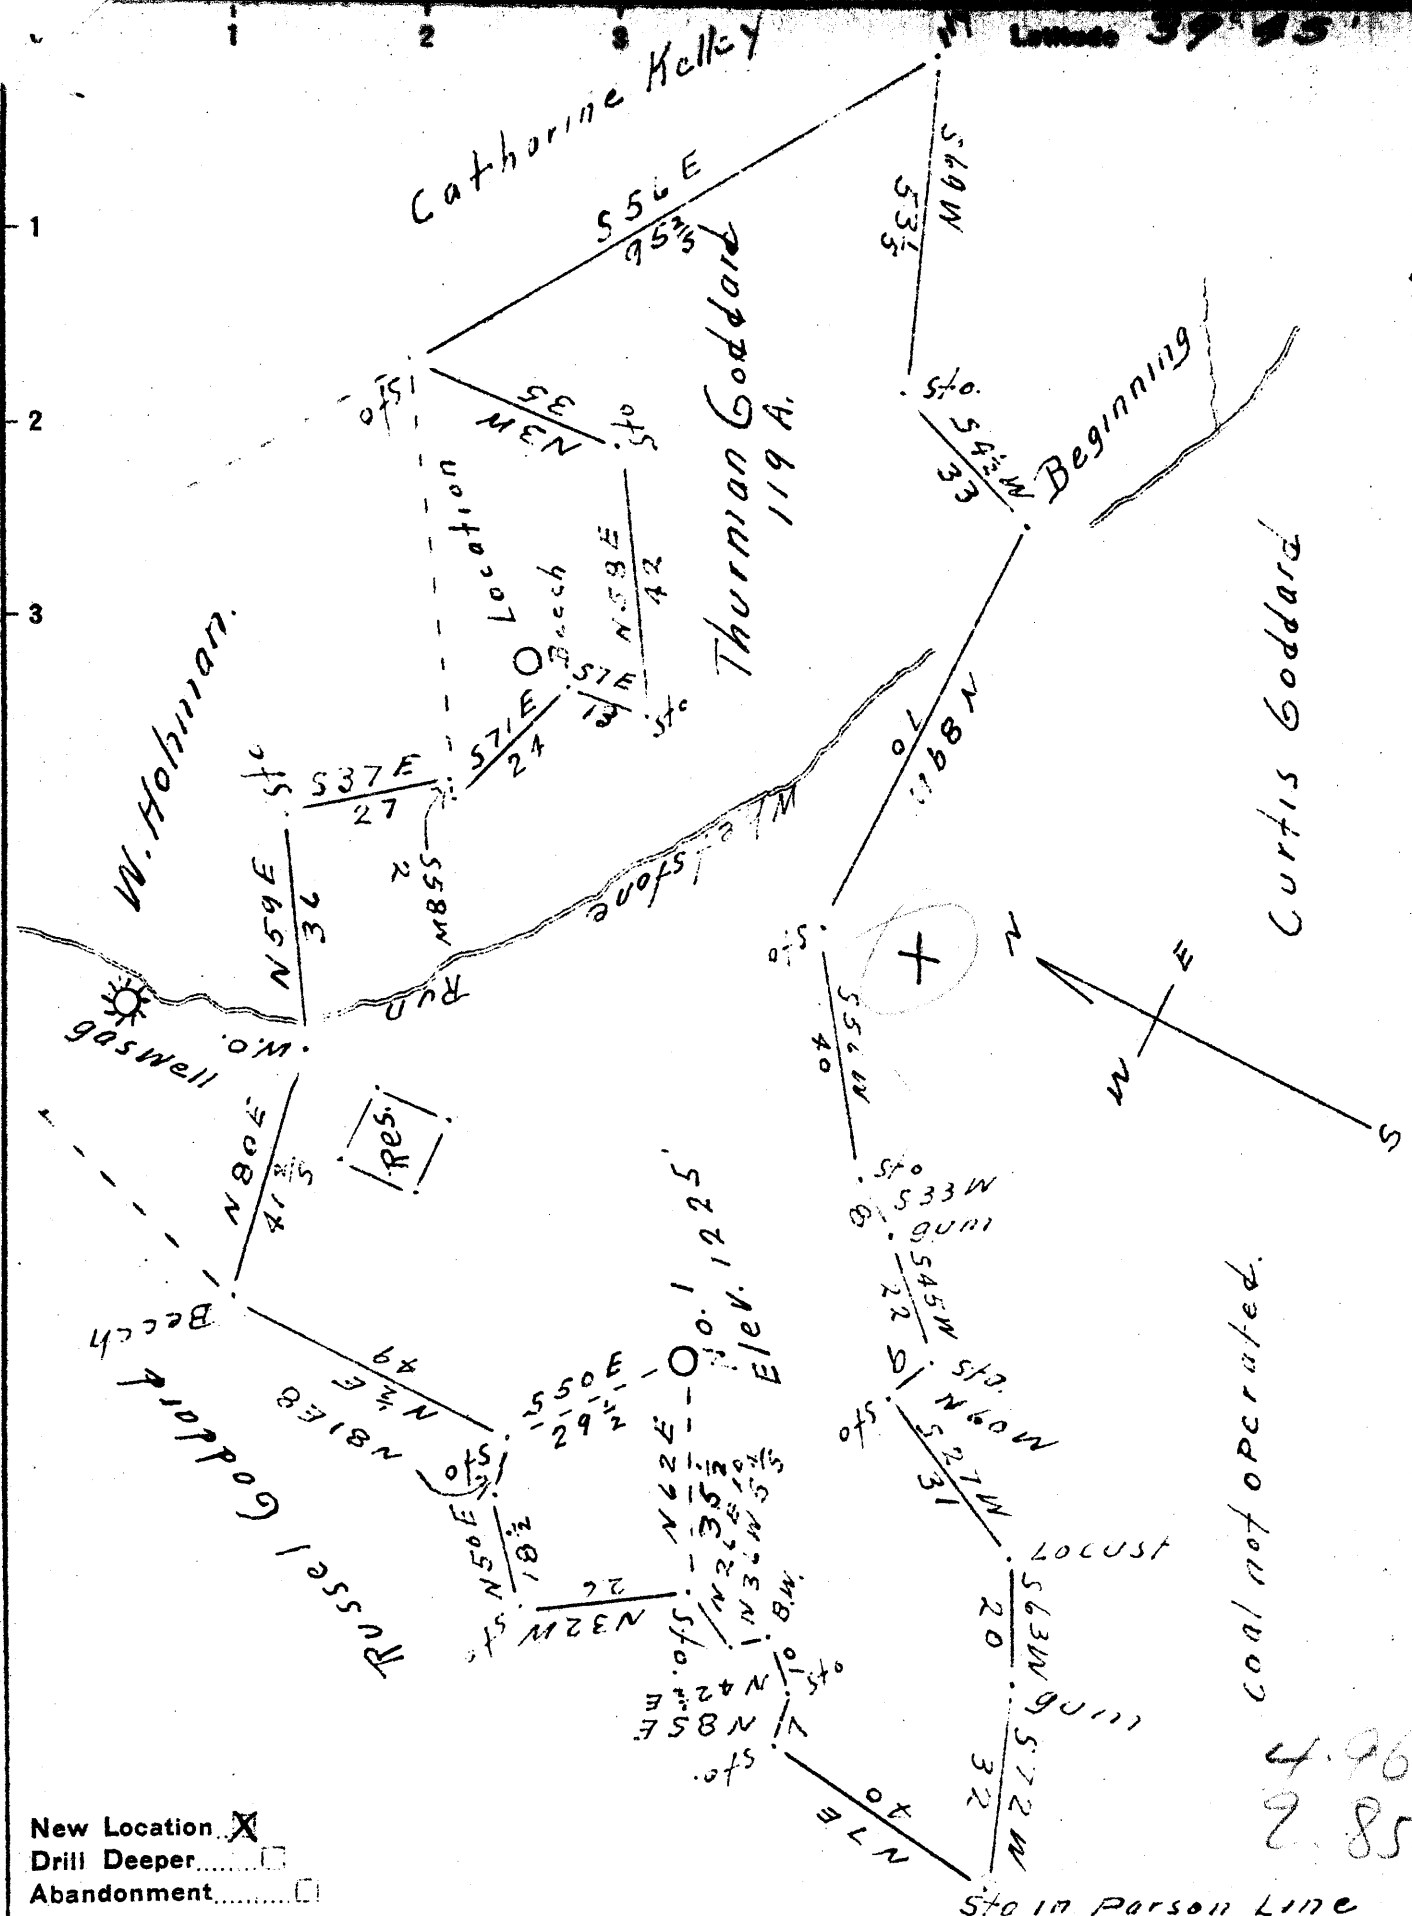

New Location X
 Drill Deeper
 Abandonment

coal not operated.

4.965
2.856

Sto in Parson Line

Company S. J. Brendel
 Address Pittsburgh Pa.
 Farm Thurnian Goddard
 Tract One Acres 119 Lease No. _____
 Well (Farm) No. One Serial No. _____
 Elevation (Spirit Level) 1225 Feet
 Quadrangle Littleton
 County Wetzel District Proctor
 Engineer J. M. Cochran
 Engineer's Registration No. Lee Durmyer
 File No. _____ Drawing No. _____
 Date 12-5-1901 Scale 1 in. = 30 Rods

STATE OF WEST VIRGINIA
 DEPARTMENT OF MINES
 OIL AND GAS DIVISION
 CHARLESTON

WELL LOCATION MAP
 FILE NO. Net - 271

+ Denotes location of well on United States Topographic Maps, scale 1 to 62,500, latitude and longitude lines being represented by border lines as shown.

- Denotes one inch spaces on border line of original tracing.

WEST VIRGINIA DEPARTMENT OF MINES
OIL & GAS DIVISION
W E L L R E C O R D

Permit No. Wet-271

Company

Address

Farm

Well No

District

Surface

Mineral

Commenced

Completed

Shot

Volume

Rock Pressure

S.J.Brendel

565 Union Trust Bldg., Pitts., Pa.

Thurman Goddard 59 Acres

1 Elev. --- 2225

Proctor Wetzal County

Thurman Goddard et al., Debee, W.Va.

Same

Dec. 15, 1941

Feb. 4, 1942

Feb. 4, 1942 Depth 3059-3067'
with 20 qts.

357,000 Nat. (793,000 shut in) C.F.

1,000 lbs. 36 hrs.

Gas Well
CASING & TUBING

10 234 234

8 1377 1377

6 5/8 2130 -

5 3/16 2961 2961

Anchor Packer

5 3/16x 6 5/8

Depth 2961'

Casing not cemented

Shale	0	14	Red Rock	1330	1350
Grit	14	50	Lime	1350	1330
Red Rock	50	60	Slate	1380	1425
Shale	60	90	Lime Shells	1425	1435
Lime Gritty	90	110	Slate	1435	1455
Slate Dk	110	160	Sand	1455	1430
Red Rock	160	190	Slate	1480	1520
Lime	190	210	B. Dunkard Sand	1520	1550
Slate	210	225	Slate	1550	1610
Lime Gritty	225	240	Gas Sand	1610	1650
Red Rock	240	360	Slate	1650	1745
Lime	360	380	Sand	1745	1770
Slate	380	400	Slate	1770	1775
Lime Gritty	400	415	Sand 1st Salt	1775	1810
Coal Blossom	415	420	Slate	1810	1850
Lime	420	435	Sand Wh S	1850	1900
Red Rock	435	460	Slate	1900	1985
Lime Broken	460	950	3rd Salt Sand	1985	2035
Mapletown Coal	950	955	Slate & Shells	2035	2120
Lime	955	970	Blue Monday Sand	2120	2140
Sand	970	1000	Big Lime	2140	2130
Lime	1000	1040	B. Injun Sand	2130	2440
Slate	1040	1050	Slate	2440	2500
Pitts. Coal	1050	1057	SLM Lime Shells	2500	2525
Slate	1057	1065	Slate	2525	2560
Lime	1065	1075	Lime Shells	2560	2600
Slate	1075	1090	Slate	2600	2635
Red Rock	1090	1100	Lime Shells	2635	2650
Lime	1100	1120	Slate	2650	2690
Red Rock	1120	1125	Lime Shells	2690	2725
Lime	1125	1135	Slate Dk S	2725	2775
Slate Dark	1135	1150	Lime	2775	2785
Lime	1150	1175	Slate	2785	2825
Sand	1175	1185	30' Shell	2825	2865
Slate	1185	1200	Slate	2865	2900
Lime Shells	1200	1230	Pink Rock	2900	2925
Red Rock	1230	1245	Lime & Slate Shells	2925	3003
Lime	1245	1250	50' Shell	3003	3019
Slate Wh.	1250	1285	Slate	3019	3049
Lime	1285	1300	Sand Gordon	3049	3067
Slate	1300	1330	Slate	3067	3090
			TOTAL DEPTH		3090
			Filled back to		3077

Gas 3061-3065 --357,000 C.F.

Gas blew down to 94,000 before well was shot. 10 Min. After shot-873,000 C.F. Shut in -793,000 C.F. Rock

Pressure-1 hr., 600#-36 hrs., 1000#

Steel Line Measurement run at 3019' and 3090

3120
1225
893