


Latitude 39° 35'

Longitude 80° 30'

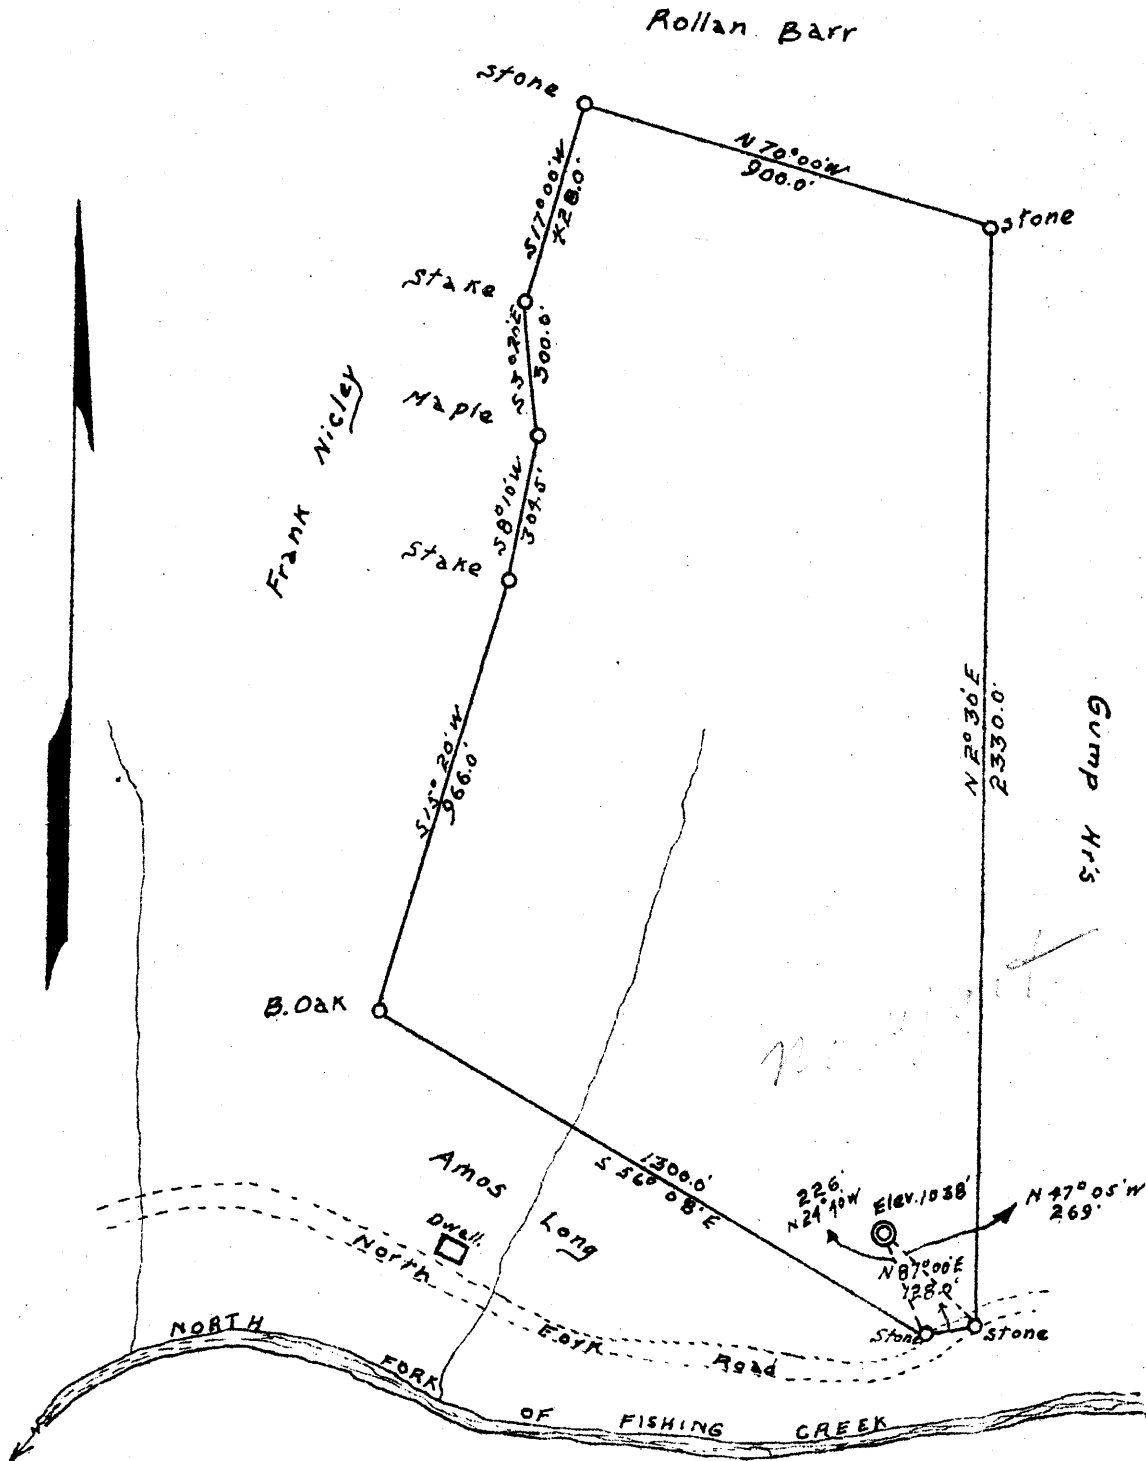

1.44  
4.316

Company J. T. MCINTIRE Co.  
 Address TRAINING SCHOOL VINELAND N.J.  
 Farm AC. BALLOUZ  
 Tract ONE Acres 55± Lease No. 6 N  
 Well (Farm) No. ONE Serial No. ONE-N  
 Quadrangle LITTLETON  
 County WRTZEL  
 District GRANT  
 Engineer J. T. McIntire  
 Engineer's Registration No. 1187

STATE OF WEST VIRGINIA  
 DEPARTMENT OF MINES  
 OIL AND GAS DIVISION  
 CHARLESTON

WELL LOCATION MAP  
 FILE NO. WET-273

+ Denotes location of well on United States Topographic Maps, scale 1 to 62,500, latitude and longitude lines being represented by border lines as shown.

Date FEB. 26, 1942 Scale 1" = 400'