

WW-7
8-30-06



West Virginia Department of Environmental Protection
Office of Oil and Gas

WELL LOCATION FORM: GPS

API: 47-103-00275 WELL NO.: 8273

FARM NAME: S. M. SHRIVER

RESPONSIBLE PARTY NAME: WEST VIRGINIA LAND RESOURCES INC.

COUNTY: WETZEL DISTRICT: CHURCH

QUADRANGLE: HUNDRED W.VA,PA

SURFACE OWNER: ALBERT E. & BRENDA S. REYNOLDS

ROYALTY OWNER: _____

UTM GPS NORTHING: 4,389,875 m

UTM GPS EASTING: 550,255 m GPS ELEVATION: 453 m (1486')

The Responsible Party named above has chosen to submit GPS coordinates in lieu of preparing a new well location plat for a plugging permit or assigned API number on the above well. The Office of Oil and Gas will not accept GPS coordinates that do not meet the following requirements:

1. Datum: NAD 1983, Zone: 17 North, Coordinate Units: meters, Altitude: height above mean sea level (MSL) – meters.
2. Accuracy to Datum – 3.05 meters
3. Data Collection Method:

Survey grade GPS _____: Post Processed Differential _____


Real-Time Differential _____

Mapping Grade GPS X: Post Processed Differential X

Real-Time Differential _____

4. Letter size copy of the topography map showing the well location.

I the undersigned, hereby certify this data is correct to the best of my knowledge and belief and shows all the information required by law and the regulations issued and prescribed by the Office of Oil and Gas.

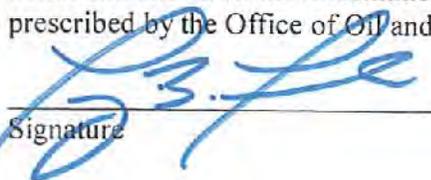
Signature

Professional Surveyor

Title

JANUARY 30, 2022


Date

RECEIVED
Office of Oil and Gas

FEB 7 2022

WV Department of
Environmental Protection

4710300275P

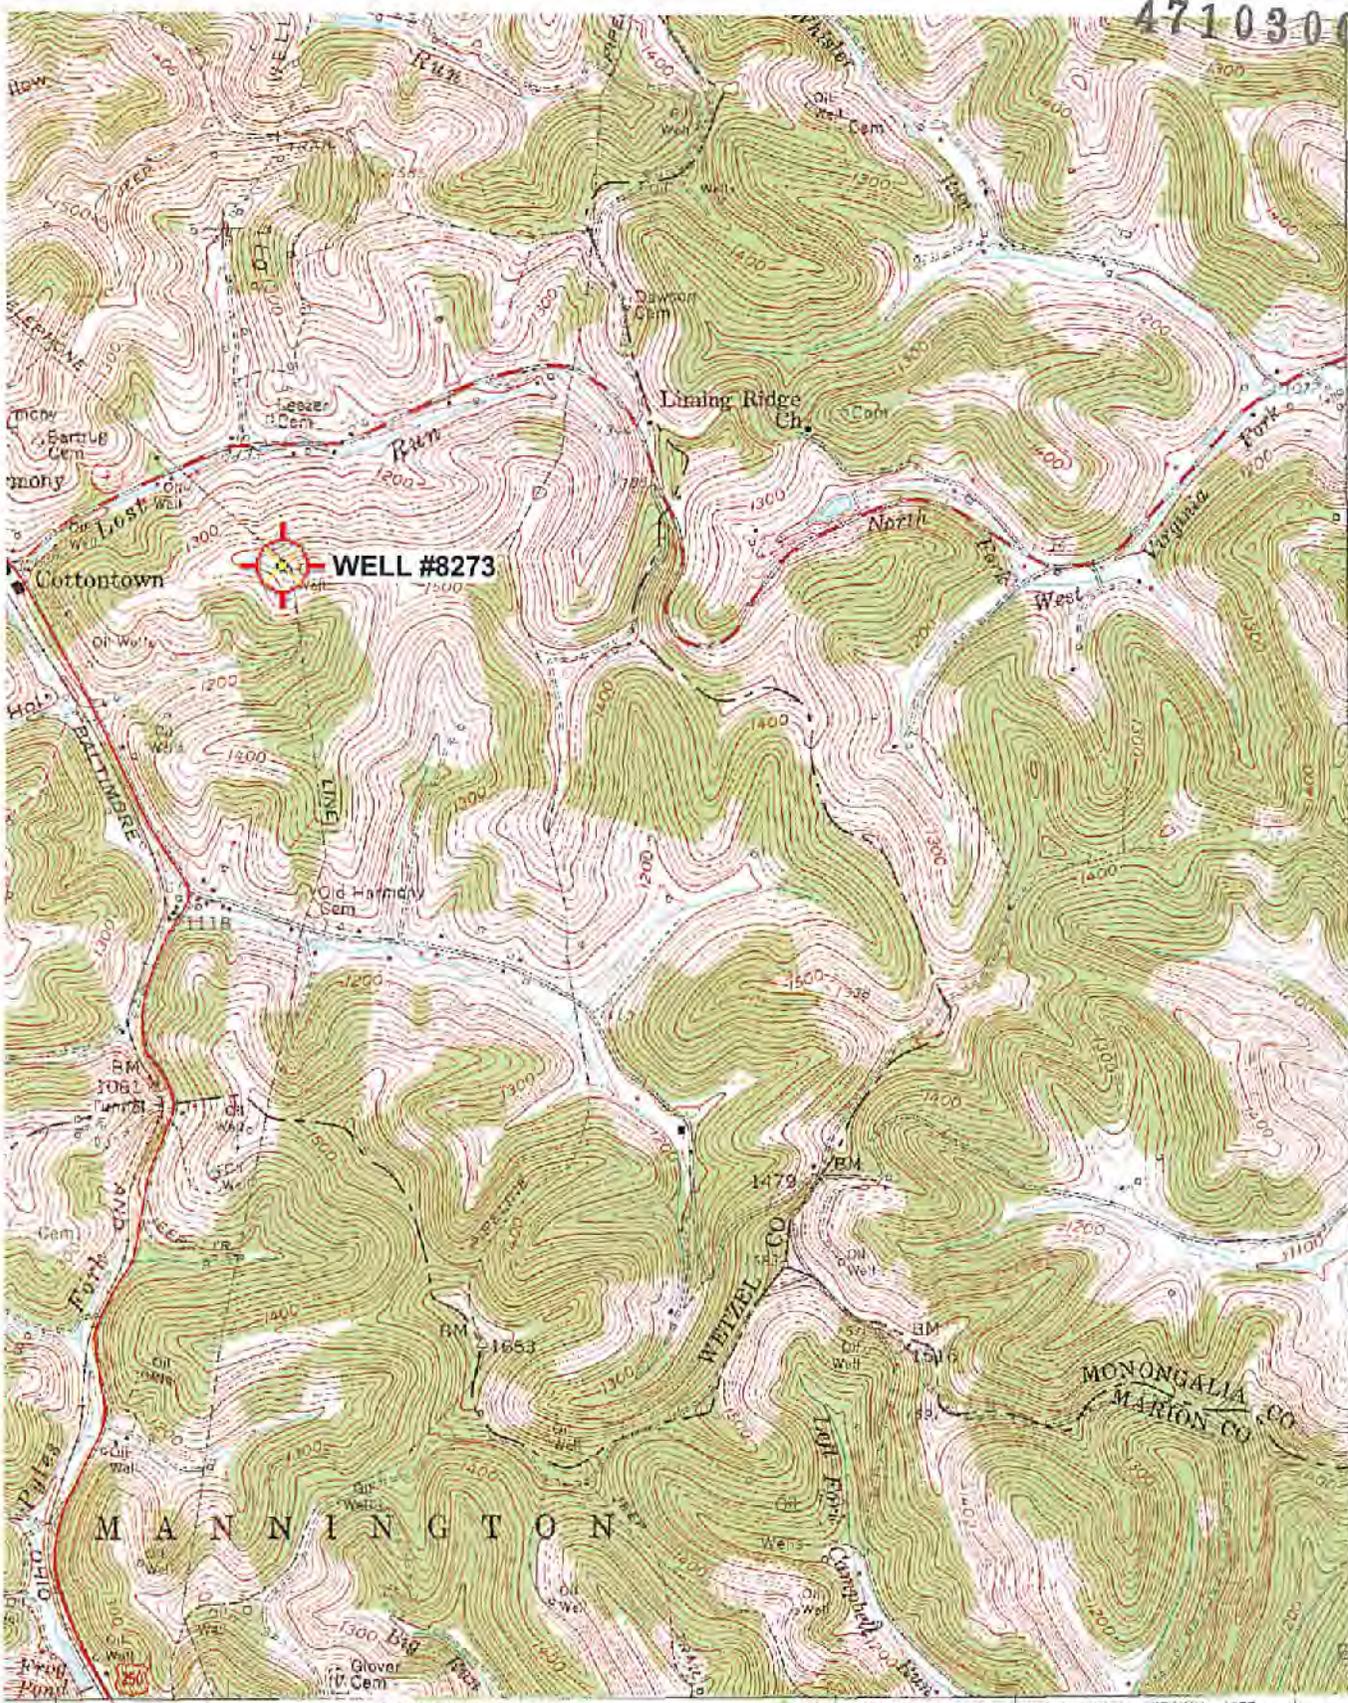

4391
40'
4389
4388
N
20 000 FEET (PA.)



20 000 FEET (PA.)

RECEIVED
Office of Oil and Gas


FEB 7 2022

WV Department of
Environmental Protection

39°37'30"
80°22'30"

GAP 1.5 MI. ONT 2.3 MI. 25' 1:250 000 FEET (PA.)#51

INTERIOR—(CLO) DIGITAL SURVEY, RESTON, VIRGINIA—1977 #52 #53000NE

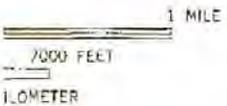

ROAD CLASSIFICATION

- Heavy-duty (thick red line)
- Medium-duty (dashed red line)
- Light-duty (thin red line)
- Unimproved dirt (dotted line)
- U.S. Route (dashed black line)
- State Route (solid black line)



QUADRANGLE LOCATION

(MANNINGTON)
#52 #53

HUNDRED, W. VA.—P04/08/2022

NW/4 MANNINGTON 15' QUADRANGLE
N3937.5—W8022.5/7.5