



West Virginia Department of Environmental Protection  
Office of Oil and Gas  
**WELL LOCATION FORM: GPS**

API: 47-103-00303f WELL NO.: WV 656276 (Fisher #1596)

FARM NAME: Fisher

RESPONSIBLE PARTY NAME: EQT Production Company

COUNTY: Wetzel DISTRICT: Grant

QUADRANGLE: Big Run 7.5'

SURFACE OWNER: Coastal Lumber Company

ROYALTY OWNER: Sharon Bokey et. al.

UTM GPS NORTHING: 4,376,423

UTM GPS EASTING: 540,248 GPS ELEVATION: 347 m ( 1138 ft)

The Responsible Party named above has chosen to submit GPS coordinates in lieu of preparing a new well location plat for a plugging permit or assigned API number on the above well. The Office of Oil and Gas will not accept GPS coordinates that do not meet the following requirements:

1. Datum: NAD 1983, Zone: 17 North, Coordinate Units: meters, Altitude: height above mean sea level (MSL) – meters.
2. Accuracy to Datum – 3.05 meters
3. Data Collection Method:

Survey grade GPS \_\_\_\_\_: Post Processed Differential \_\_\_\_\_  
Real-Time Differential \_\_\_\_\_

Mapping Grade GPS X: Post Processed Differential X  
Real-Time Differential \_\_\_\_\_

4. Letter size copy of the topography map showing the well location.

I the undersigned, hereby certify this data is correct to the best of my knowledge and belief and shows all the information required by law and the regulations issued and prescribed by the Office of Oil and Gas.

Ben R. Siefert  
Signature

P.S. 2092  
Title

8-11-11  
Date

RECEIVED  
Office of Oil & Gas  
AUG 23 2011  
WV Department of  
Environmental Protection


Topo Quad: Big Run Scale: 1" = 2000' *103-00303 P*  
 County: Wetzel Date: July 20, 2011  
 District: Grant Project No: 40-34-00-09

47-103-00303 (WV 656276)

Topo

RECEIVED  
 Office of Oil & Gas  
 SEP-07 2011

WV Department of  
 Environmental Protection

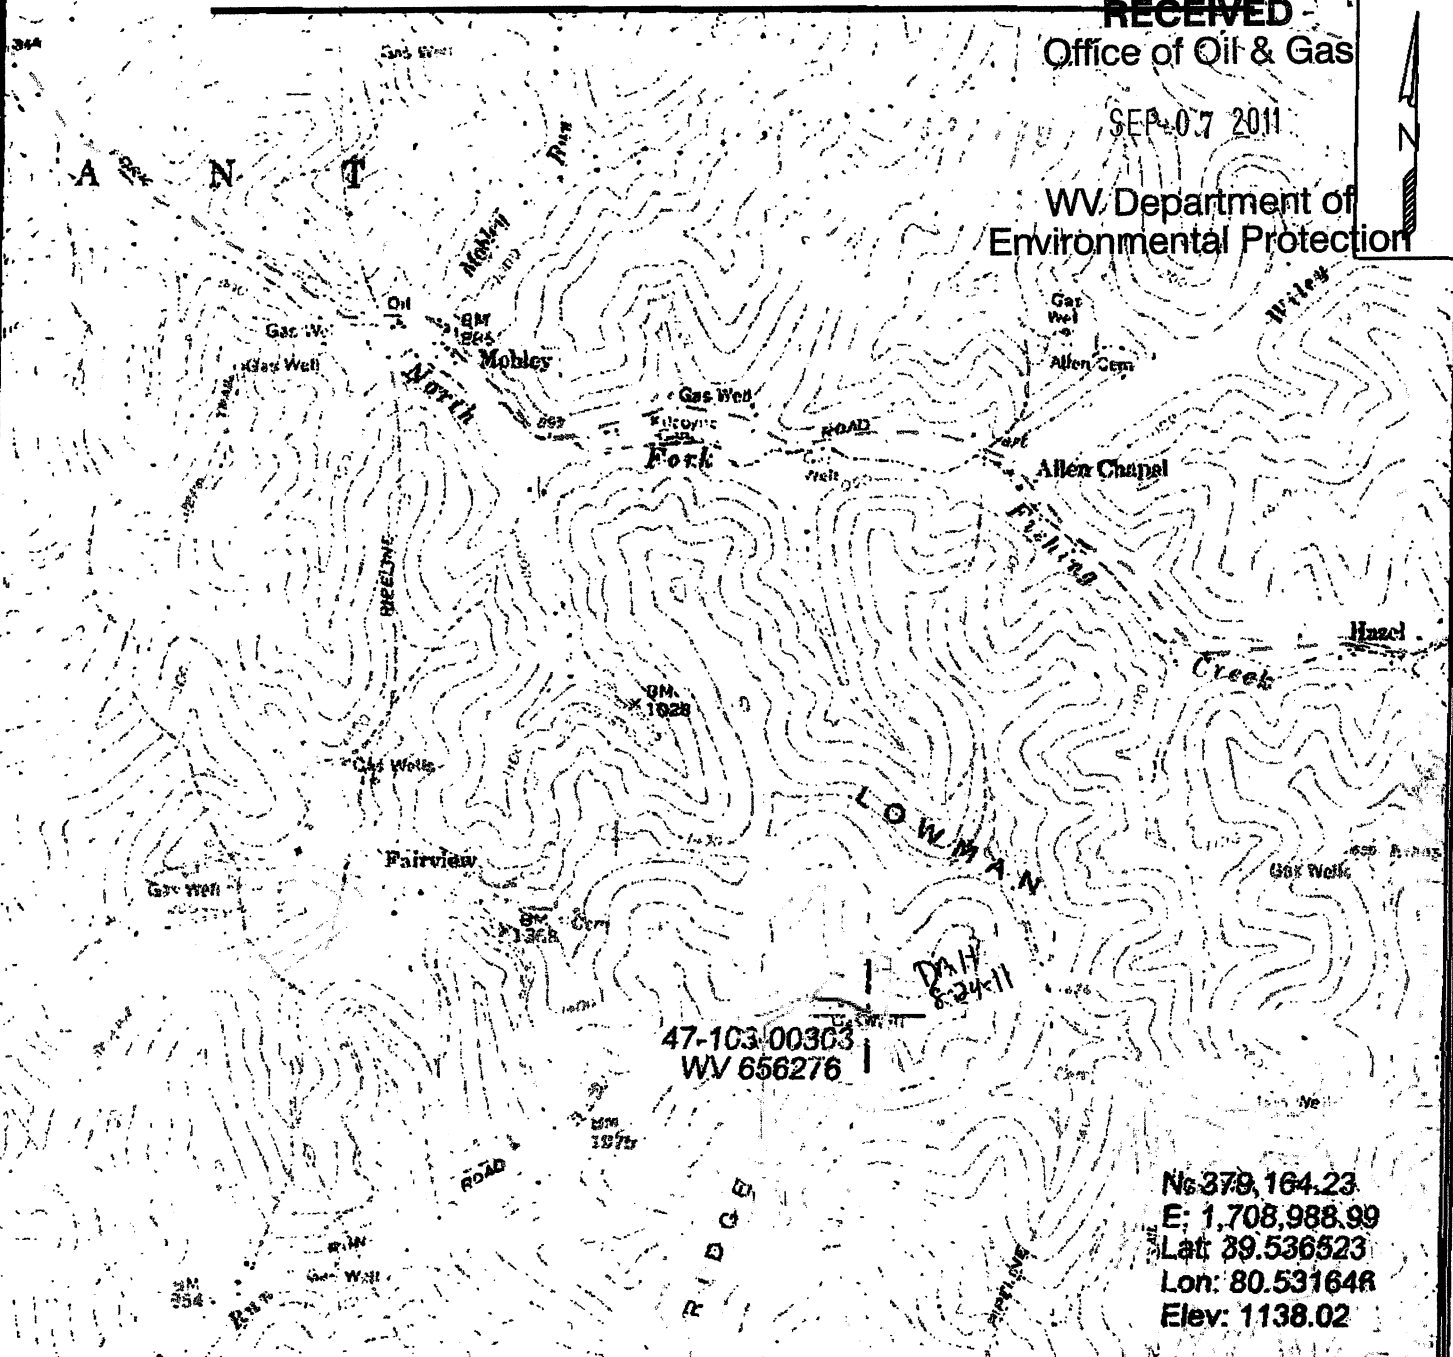

N: 379,164.23  
 E: 1,708,988.99  
 Lat: 39.536523  
 Lon: 80.531648  
 Elev: 1138.02



SURVEYING AND MAPPING SERVICES PERFORMED BY:  
**ALLEGHENY SURVEYS, INC.**  
 1-800-482-8606  
 P.O. BOX 438  
 BIRCH RIVER, WV 26610  
 PH: (304) 649-8606  
 FAX: (304) 649-8608

PREPARED FOR:  
**EQT Production Company**  
 1710 Pennsylvania Ave.  
 Charleston, WV 25302