

#BD.

JUN 13 1938

Company	I. H. Beren
Address	Marietta, Ohio
Farm	Dressler Sellers
Acres	132
Well (Farm) No.	1
Serial	5346 (Formerly Pgh. & W. Va.)
Elevation	1508.71 (Spirit Level)
Quadrangle	Littleton
County	Wetzel
District	Clay
Engineer	Hornor Bros. Eng'rs. Paul Allen Hornor
Eng. Reg. No.	602
Date	6-4-38
Scale	1" = 500'

(Handwritten initials)

STATE OF WEST VIRGINIA
 Department of Mines
 OIL & GAS DIVISION
 Charleston

WELL LOCATION MAP
 File No. Wet-268-A
 103-332

Denotes location of well on U. S. Topographic Maps, scale 1 to 62,500, latitude and longitude lines being represented by border lines as shown.

Denotes one inch spaces on border line of original tracing.

WEST VIRGINIA DEPARTMENT OF MINES
OIL AND GAS DIVISION

606

WELL RECORD

Permit No. **Wet-268-A**


Oil or Gas Well **Gas**
(Kind)

Company **I. H. Boren**
 Address **Marietta, Ohio**
 Farm **Dressie Sellers** Acres **1.32**
 Location (waters) **Wolf Run**
 Well No. **1** Elev. _____
 District **Clay** County **Wetzel**
 The surface of tract is owned in fee by **Dressie Sellers**
 Address **Garrison, Pa., R.D.1**
 Mineral rights are owned by **Dressie Sellers**
 Address **Garrison, Pa., R.D.1**
 Drilling commenced **1933**
 Drilling completed **1933**
 Date shot _____ Depth of shot _____
 Open Flow /10ths Water in _____ Inch
 /10ths Merc. in _____ Inch
 Volume _____ Cu. Ft.
 Rock Pressure _____ lbs. _____ hrs.
 Oil _____ bbls., 1st 24 hrs.
 Fresh water _____ feet _____ feet
 Salt water _____ feet _____ feet

Casing and Tubing	Used in Drilling	Left in Well	Packers
Size			
16			Kind of Packer
13			Anchor
10	301	301	Size of 6-5/8 x 3
8 1/4	1742	1742	
6 5/8	2474	2474	Depth set
5 3/16			
3	3256	3256	Perf. top
2			Perf. bottom
Liners Used			Perf. top
			Perf. bottom

CASING CEMENTED _____ SIZE _____ No. FT. _____ Date _____
 COAL WAS ENCOUNTERED AT **925** FEET _____ INCHES
1140 FEET _____ INCHES **1255** FEET _____ INCHES
 _____ FEET _____ INCHES _____ FEET _____ INCHES

Formation	Color	Hard or Soft	Top	Bottom	Oil Gas or Water	Depth Found	Remarks
Soil			0	30			
Red Rock			30	60			
Slate & Lime			60	325	Water - 170		
Red Rock			325	350			
Slate & Lime			350	600			
Red Rock			600	620			
Slate & Lime			620	763			
Sand			763	790			
Slate & Lime			790	925			
Fairview Coal			925	928			
Lime & Slate			928	1140			
Mapletown Coal			1140	1145			
Slate & Lime			1145	1255			
Pittsburgh Coal			1255	1263			
Slate & Lime			1263	1490			
Red Rock			1490	1490			
Slate			1490	1508			
Red Rock			1508	1550			
Lime			1550	1585			
Sand			1585	1610			
Red Rock			1610	1640			
Lime & Slate			1640	1725			
Big Dunkard			1725	1735			
Slate & Lime			1735	1990			
First Salt Sand			1990	2070	Gas and Water - 2040		
Slate			2070	2072			
Second Salt Sand			2072	2190	Gas at 2170 - 2175		
Slate			2190	2192			
Lime			2192	2255			
Third Salt Sand			2255	2300			
Slate			2300	2325			
Merton			2325	2355			
Slate			2355	2442			
Little Lime			2442	2496			
Big Lime			2496	2696			
Big Injun			2696	2715			
Slate & Shells			2715	2822			
Top of Thirty Foot Sand			2822		Gas 2827 - 2859		
Total Depth			2861				

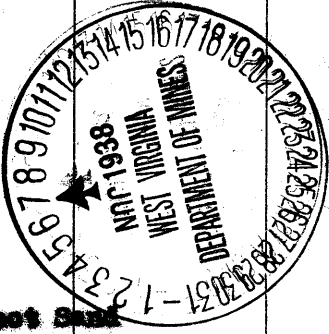

Formation	Color	Hard or Soft	Top	Bottom	Oil, Gas or Water	Depth Found	Remarks

Date June 4, 1958

APPROVED J. H. Berew, Owner

By.....
(Title)