



STATE OF WEST VIRGINIA  
DEPARTMENT OF MINES  
OIL AND GAS DIVISION

NOTICE OF PROPOSED LOCATION OF OIL AND GAS WELL

To THE DEPARTMENT OF MINES,  
Charleston, W. Va.

~~Burton Coal & Coke Co.~~  
COAL OPERATOR OR COAL OWNER

A. M. Snider  
NAME OF WELL OPERATOR

1914 Grant Bldg, Pittsburgh, Pa.

Hundred, W.Va.

ADDRESS

COMPLETE ADDRESS

J. H. Hillman Coal Co.  
COAL OPERATOR OR COAL OWNER

June 24, 19 49

PROPOSED LOCATION

% Everett F. Moore

Church District

Moundsville, W.Va.  
ADDRESS

Wetzel County

OWNER OF MINERAL RIGHTS

Well No. 3 <sup>39° 40'</sup> <sub>80° 30'</sub>

ADDRESS

Z. T. Stewart Farm

GENTLEMEN:

The undersigned well operator is entitled to drill upon the above named farm or tract of land for oil and gas, having fee title thereto, (or as the case may be) under grant or lease dated 18th

June 1949, made by A. M. Snider, to A. M. Snider

, and recorded on the \_\_\_\_\_ day of \_\_\_\_\_, in the office of the County Clerk for said County in Book \_\_\_\_\_, page \_\_\_\_\_.

The enclosed plat was prepared by a competent engineer and shows the proposed location of a well to be drilled for oil and gas by the undersigned well operator on the farm and in the Magisterial District and County above named, determined by survey and courses and distances from two permanent points, or land marks.

The undersigned well operator is informed and believes there are no coal operators operating beds of coal beneath said farm or tract of land on which said well is located, or within 500 feet of the boundaries of the same, who have mapped their workings and filed their maps as required by law, excepting the coal operators or coal owners (if any) above named as addressees.

The above named coal operators or coal owners (if any) are notified that any objections they may desire to make to such proposed location, or which they are required to make by Section 3 of said Code, if the drilling of a well at said proposed location will cause a dangerous condition in or about their respective coal mines, must be received by, or filed with the Department of Mines within ten\* days from the receipt of a copy of this notice and accompanying plat by said Department. Said coal operators are further notified that forms for use in making such objections will be furnished to them by the Department of Mines promptly on request and that all such objections must set forth as definitely as is reasonably possible the ground or grounds on which such objections are based and indicate the direction and distance the proposed location should be moved to overcome same.

(The next paragraph is to be completed only in Department's copy.)

Copies of this notice and the enclosed plat were mailed by registered mail, or delivered to the above named coal operators or coal owners at their above shown respective address June 24, 1949 day before, or on the same day with the mailing or delivery of this copy to the Department of Mines at Charleston, West Virginia.

Very truly yours, A. M. Snider

A. M. Snider  
WELL OPERATOR

Address of Well Operator }

STREET


Hundred

CITY OR TOWN

10/06/2023

West Virginia

STATE

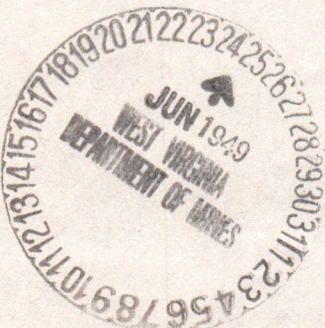

\*Section 3 . . . . If no such objections be filed or be found by the department of mines, within said period of ten days from the receipt of said notice and plat by the department of mines, to said proposed location, the department shall forthwith issue to the well operator a drilling permit reciting the filing of such plat, that no objections have been made by the coal operators to the location, or found thereto by the department, and that the same is approved and the well operator authorized to proceed to drill at said location.

See West 353 for drawings

A-10

July 7, 1949

Mr. A. M. Snider  
Hundred, West Virginia

Dear Sir:

Enclosed is permit WET-355 to drill Well  
No. 3 on the Z. T. Stewart Farm, Church District,  
Wetzel County.

Very truly yours,

Administrative Assistant  
OIL AND GAS DIVISION

GNH:K  
Encl-2

CC: Inspector Oliver W. Lineberg

10/06/2023

B-3

February 23, 1950

Mr. A. M. Snider  
Waynesburg, Pennsylvania

Dear Mr. Snider:

Please send us two copies of the well log for  
the following locations:-

PERMIT NO.	FARM	WELL NO.	DISTRICT	ISSUED
WET-354	Z. T. Stewart	No. 2	Church	7/7/49
WET-355	Z. T. Stewart	No. 3	Church	7/7/49


Blanks are enclosed and we would appreciate a  
prompt reply so that this information can be included in the 1949  
Annual Report.

Very truly yours,

Administrative Assistant  
OIL AND GAS DIVISION

MG:g  
encl

cc: Oliver W. Lineberg, Inspector

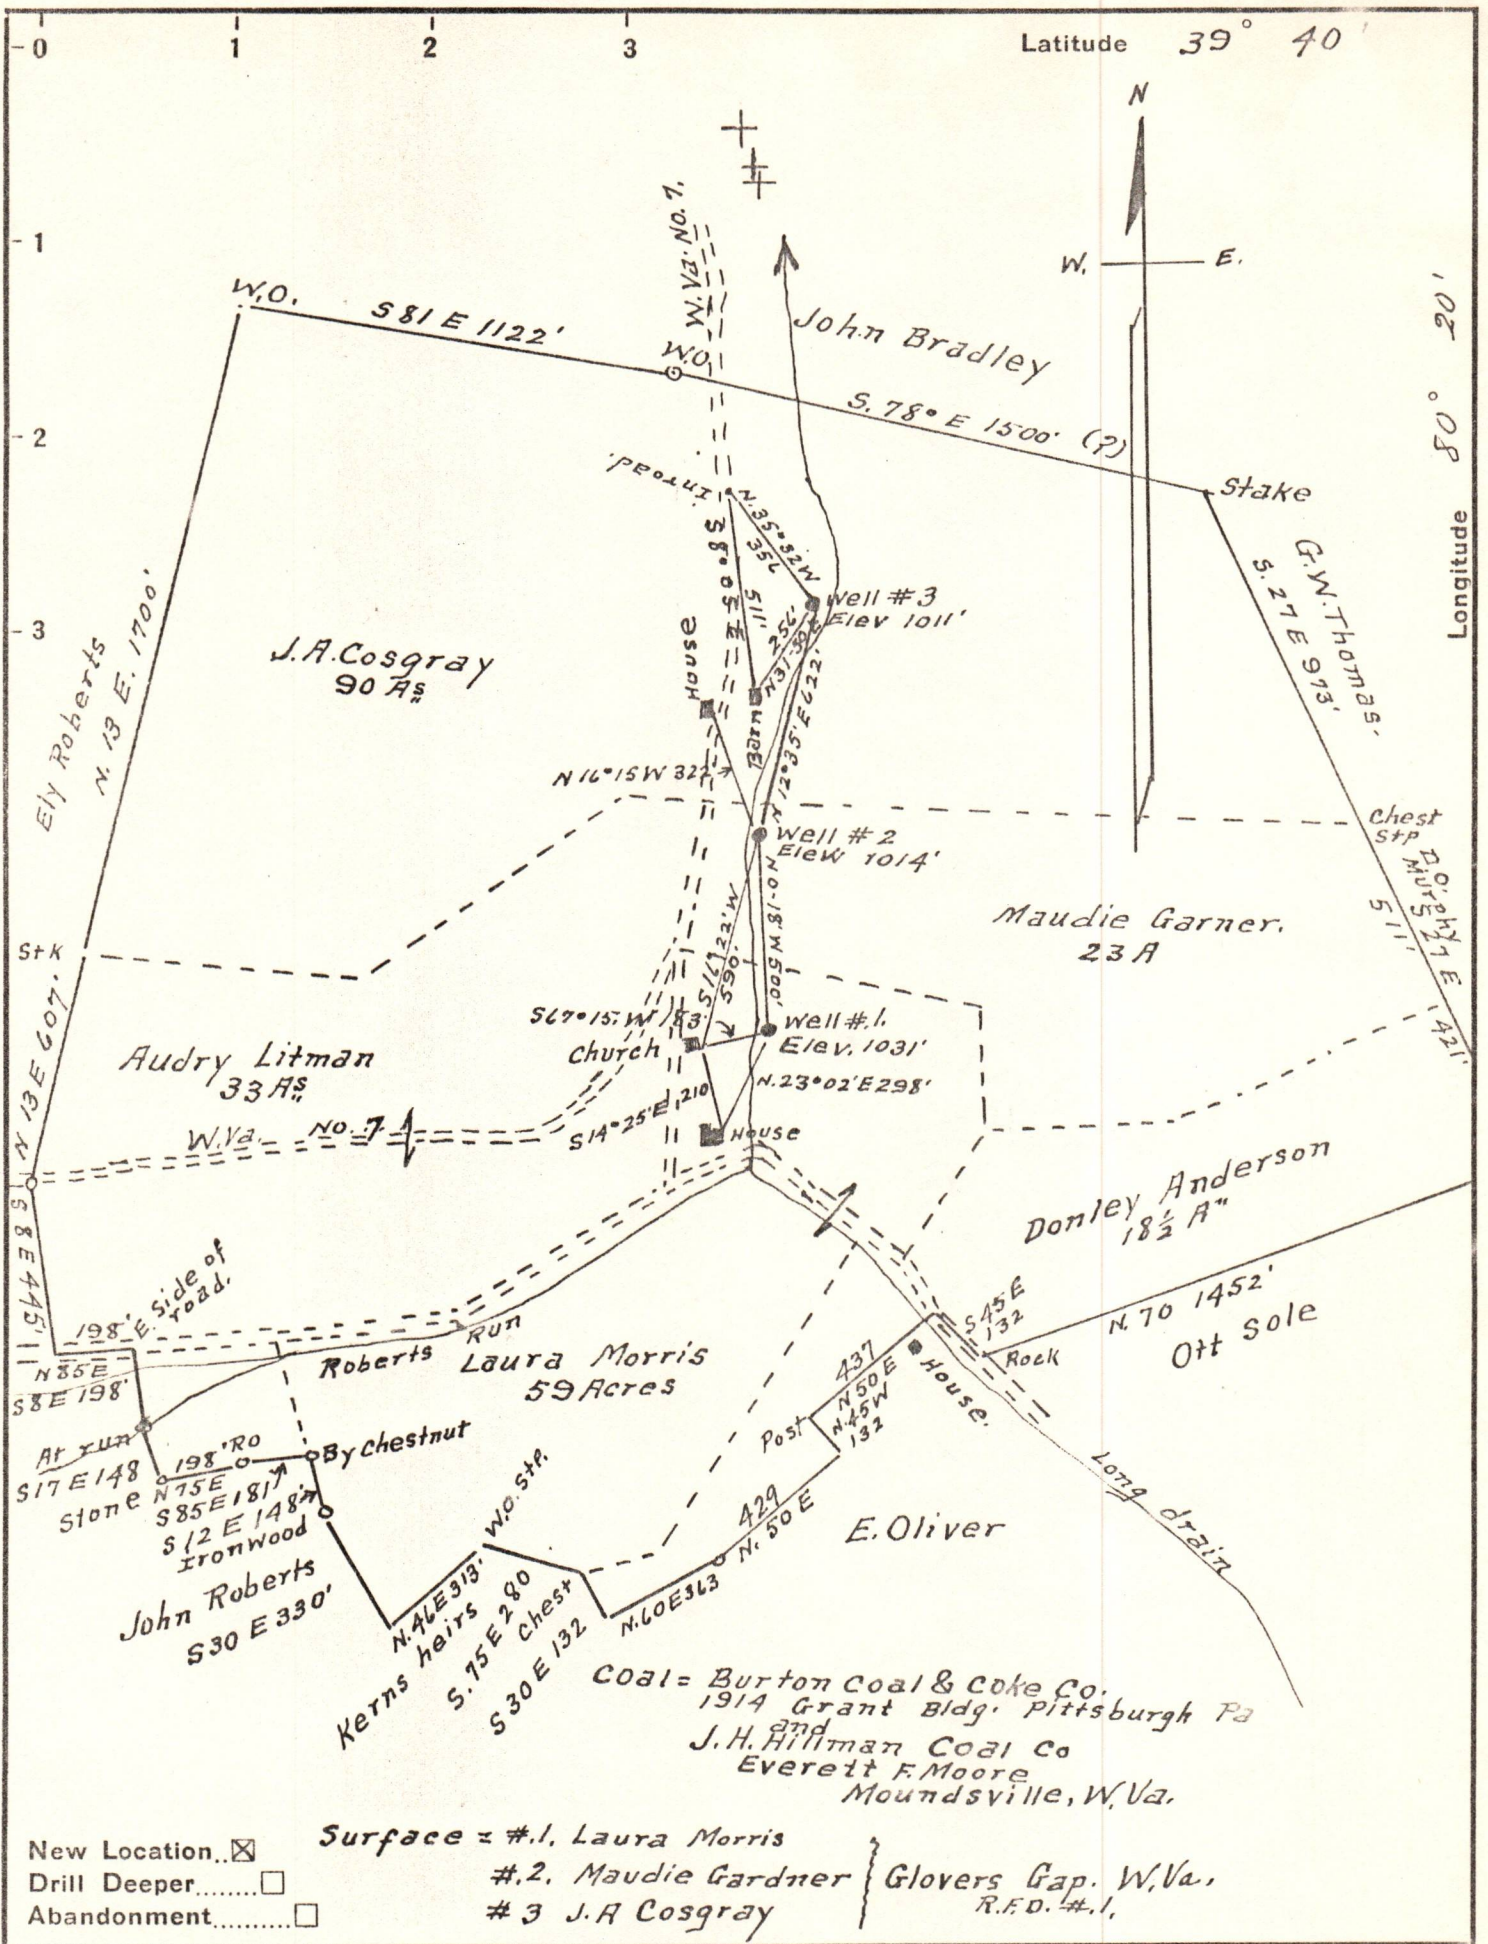

New Location...   
 Drill Deeper.....   
 Abandonment.....

Surface = #1, Laura Morris  
 #2, Maudie Gardner } Grovers Gap, W.Va.  
 #3 J.A. Cosgray } R.F.D. #1,

Company A.M. Snider  
 Address Hundred W.Va.  
 Farm Z.T. Stewart  
 Tract 1 Acres 225 Lease No. \_\_\_\_\_  
 Well (Farm) No. 1-2-3 Serial No. \_\_\_\_\_  
 Elevation (Spirit Level) #1 = 1031' #2 = 1014' #3 = 1011'  
 Quadrangle Mannington  
 County Wetzel District Church  
 Engineer A.L. Headley  
 Engineer's Registration No. 2021  
 File No. \_\_\_\_\_ Drawing No. \_\_\_\_\_  
 Date 6-23-1949 Scale 1" = 500'

STATE OF WEST VIRGINIA  
 DEPARTMENT OF MINES  
 OIL AND GAS DIVISION  
 CHARLESTON

WELL LOCATION MAP  
 wet-353 10/06/2023  
 FILE NO. wet-354-#2  
 wet-355-#3

+ Denotes location of well on United States Topographic Maps, scale 1 to 62,500, latitude and longitude lines being represented by border lines as shown.

- Denotes one inch spaces on border line of original tracing.