


*Janice*  
4/25/94

LATITUDE 39° 32' 30"  
(9200' 5)

LONGITUDE 80° 37' 30"  
(M. 002E)

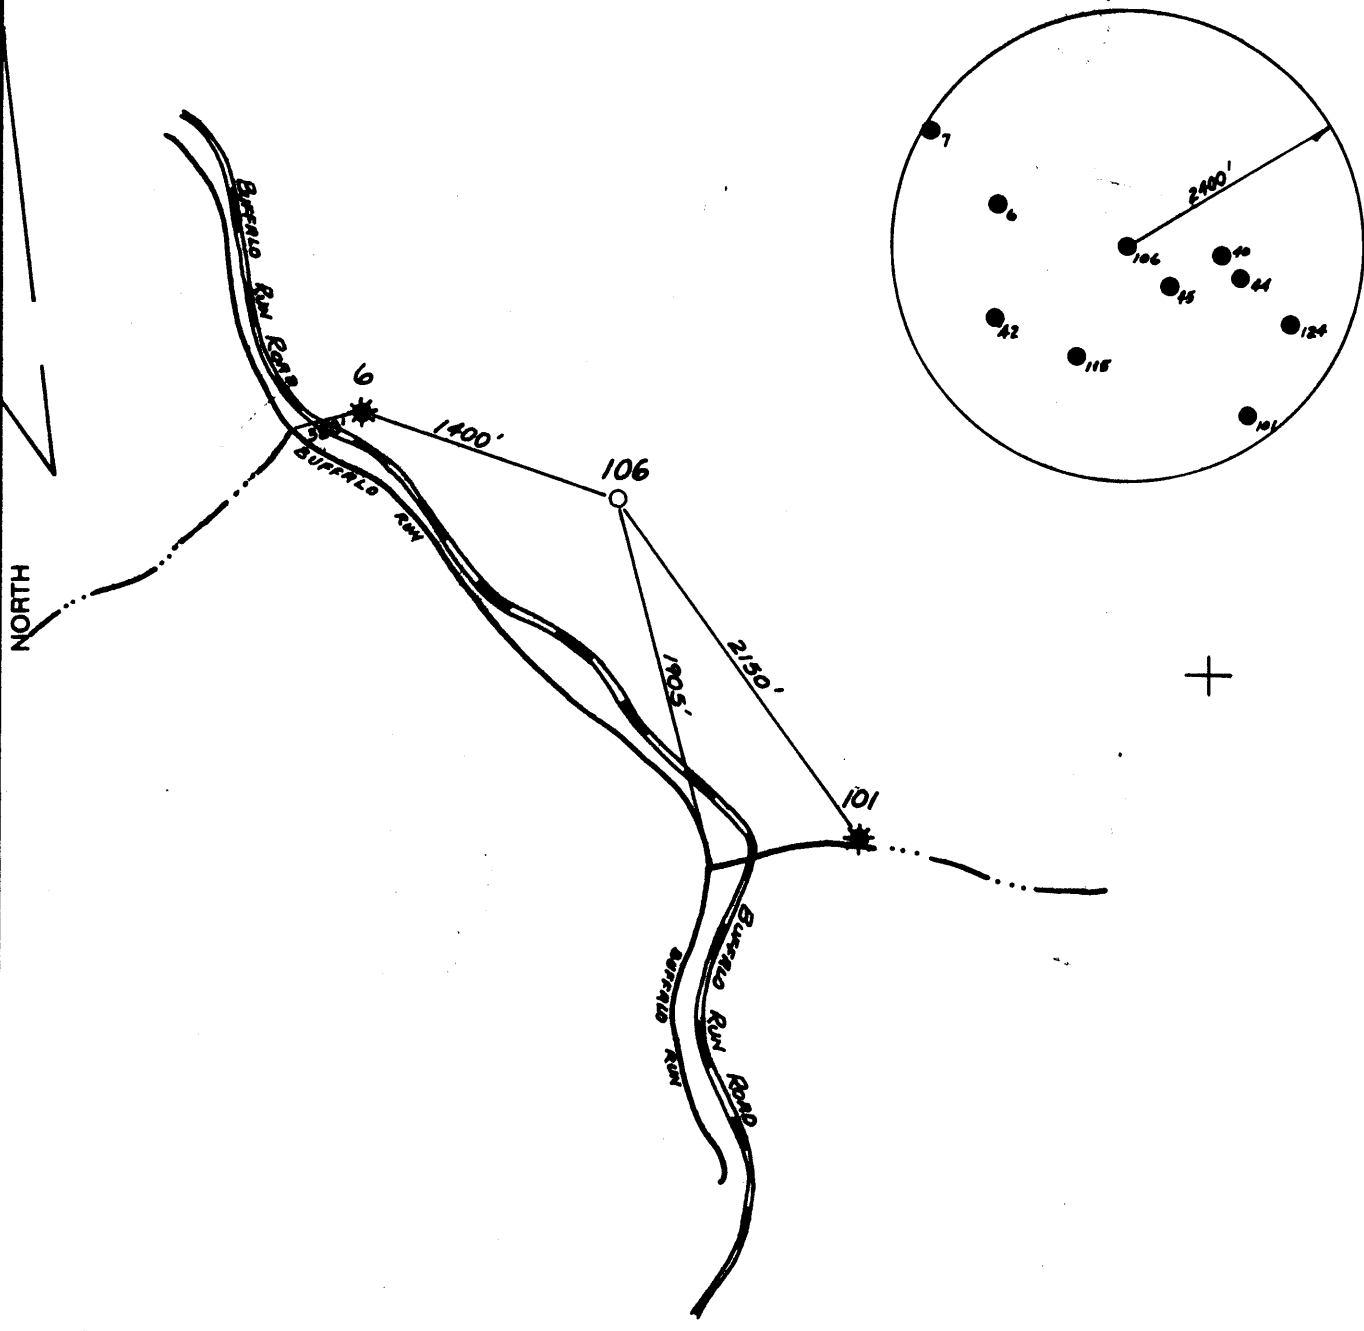

(+) DENOTES LOCATION OF WELL ON UNITED STATES TOPOGRAPHIC MAPS

FILE NO. \_\_\_\_\_  
DRAWING NO. \_\_\_\_\_  
SCALE 1" = ±1000'  
MINIMUM DEGREE OF ACCURACY \_\_\_\_\_  
PROVEN SOURCE OF ELEVATION \_\_\_\_\_

I THE UNDERSIGNED, HEREBY CERTIFY THAT THIS PLAT IS CORRECT TO THE BEST OF MY KNOWLEDGE AND BELIEF AND SHOWS ALL THE INFORMATION REQUIRED BY LAW AND THE REGULATIONS ISSUED AND PRESCRIBED BY THE DEPARTMENT OF ENERGY.  
(SIGNED) T.J. RUSSELL  
R.P.E. \_\_\_\_\_ L.L.S. \_\_\_\_\_

PLACE SEAL HERE

**STATE OF WEST VIRGINIA**  
DEPARTMENT OF ENERGY  
OIL AND GAS DIVISION



DATE 2/17, 19 94  
OPERATOR'S WELL NO. MILLS # 106  
API WELL NO. 47-103-00370-P

WELL TYPE: OIL  GAS \_\_\_\_\_ LIQUID INJECTION \_\_\_\_\_ WASTE DISPOSAL \_\_\_\_\_  
(IF "GAS,") PRODUCTION \_\_\_\_\_ STORAGE \_\_\_\_\_ DEEP \_\_\_\_\_ SHALLOW \_\_\_\_\_  
LOCATION: ELEVATION 1050' WATERSHED BUFFALO RUN  
DISTRICT GRANT COUNTY WETZEL  
QUADRANGLE PINE GROVE 7.5  
SURFACE OWNER LEWIS WETZEL PUBLIC LANDS ACREAGE 5265  
OIL & GAS ROYALTY OWNER LEWIS WETZEL PUBLIC LANDS LEASE ACREAGE 5228.5  
LEASE NO. \_\_\_\_\_

PROPOSED WORK: DRILL \_\_\_\_\_ CONVERT \_\_\_\_\_ DRILL DEEPER \_\_\_\_\_ REDRILL \_\_\_\_\_ FRACTURE OR STIMULATE \_\_\_\_\_ PLUG OFF OLD FORMATION \_\_\_\_\_ PERFORATE NEW FORMATION \_\_\_\_\_ OTHER PHYSICAL CHANGE IN WELL (SPECIFY) \_\_\_\_\_

PLUG AND ABANDON  CLEAN OUT AND REPLUG \_\_\_\_\_  
TARGET FORMATION GORDON ESTIMATED DEPTH 2948'  
WELL OPERATOR QUAKER STATE CORPORATION DESIGNATED AGENT FRANK ROTUNDA  
ADDRESS 1226 PUTNAM HOME DR. BELPRE, OH ADDRESS P.O. Box 823 PARKERSBURG, W.VA.  
45714 26102

FORM WW-6  
H.T. HALL 48673

COUNTY NAME  
PERMIT



WEST VIRGINIA DEPARTMENT OF MINES  
OIL & GAS DIVISION  
W E L L R E C O R D

Permit No. Wet 370 D  
Littleton Quad.

Pressure Well  
CASING & TUBING

Company	Quaker State Oil Refining Corp.			
Address	Box 1789, Parkersburg, W.Va.	10	356	300
Farm	John Mills Est. Acres 5451	8 $\frac{1}{2}$	1335	
Location	Buffalo	6 5/8	2119	2119
Well No.	106 Elev. 1066	5 3/16	2242	2242
District	Grant Wetzel County			
Surface	Mills-Wetzel Lands, Inc. Marietta, Ohio			Larkin Packer Anchor Size 5 $\frac{1}{2}$ x 7" OD Depth 2133'
Mineral	Same			
Commenced	4-4-50			
Completed	5-28-50			
Oil	1 bbls. 1st 24 hrs.			

DRILLED DEEPER

Big Injun	Lt	H		2340
Slate & Shells	Gr	H&S	2340	2440
Lime	Gritty		2440	2495
Sand			2495	2505
Slate			2505	2506
Slate & Shells		H&S	2506	2535
Slate			2535	2580
Slate & Shells		H&S	2580	2675
Lime	Gritty		2675	2695
Slate & Shells		H&S	2695	2764
Pink Rock	Red	S	2764	2787
Lime		H	2787	2795
Slate & Shells		H&S	2795	2834
Slate	Gr	Sandy	2834	2859
Slate & Shells		H&S	2859	2893
Sand	Gordon	Stray	H	2893
Shale			2901	2907
Gordon			2907	2938
Shale			2938	2960
Total depth				2960

Oil and gas 2926

2960  
2340  
-----  
620

