


WILLIAM SWISHER

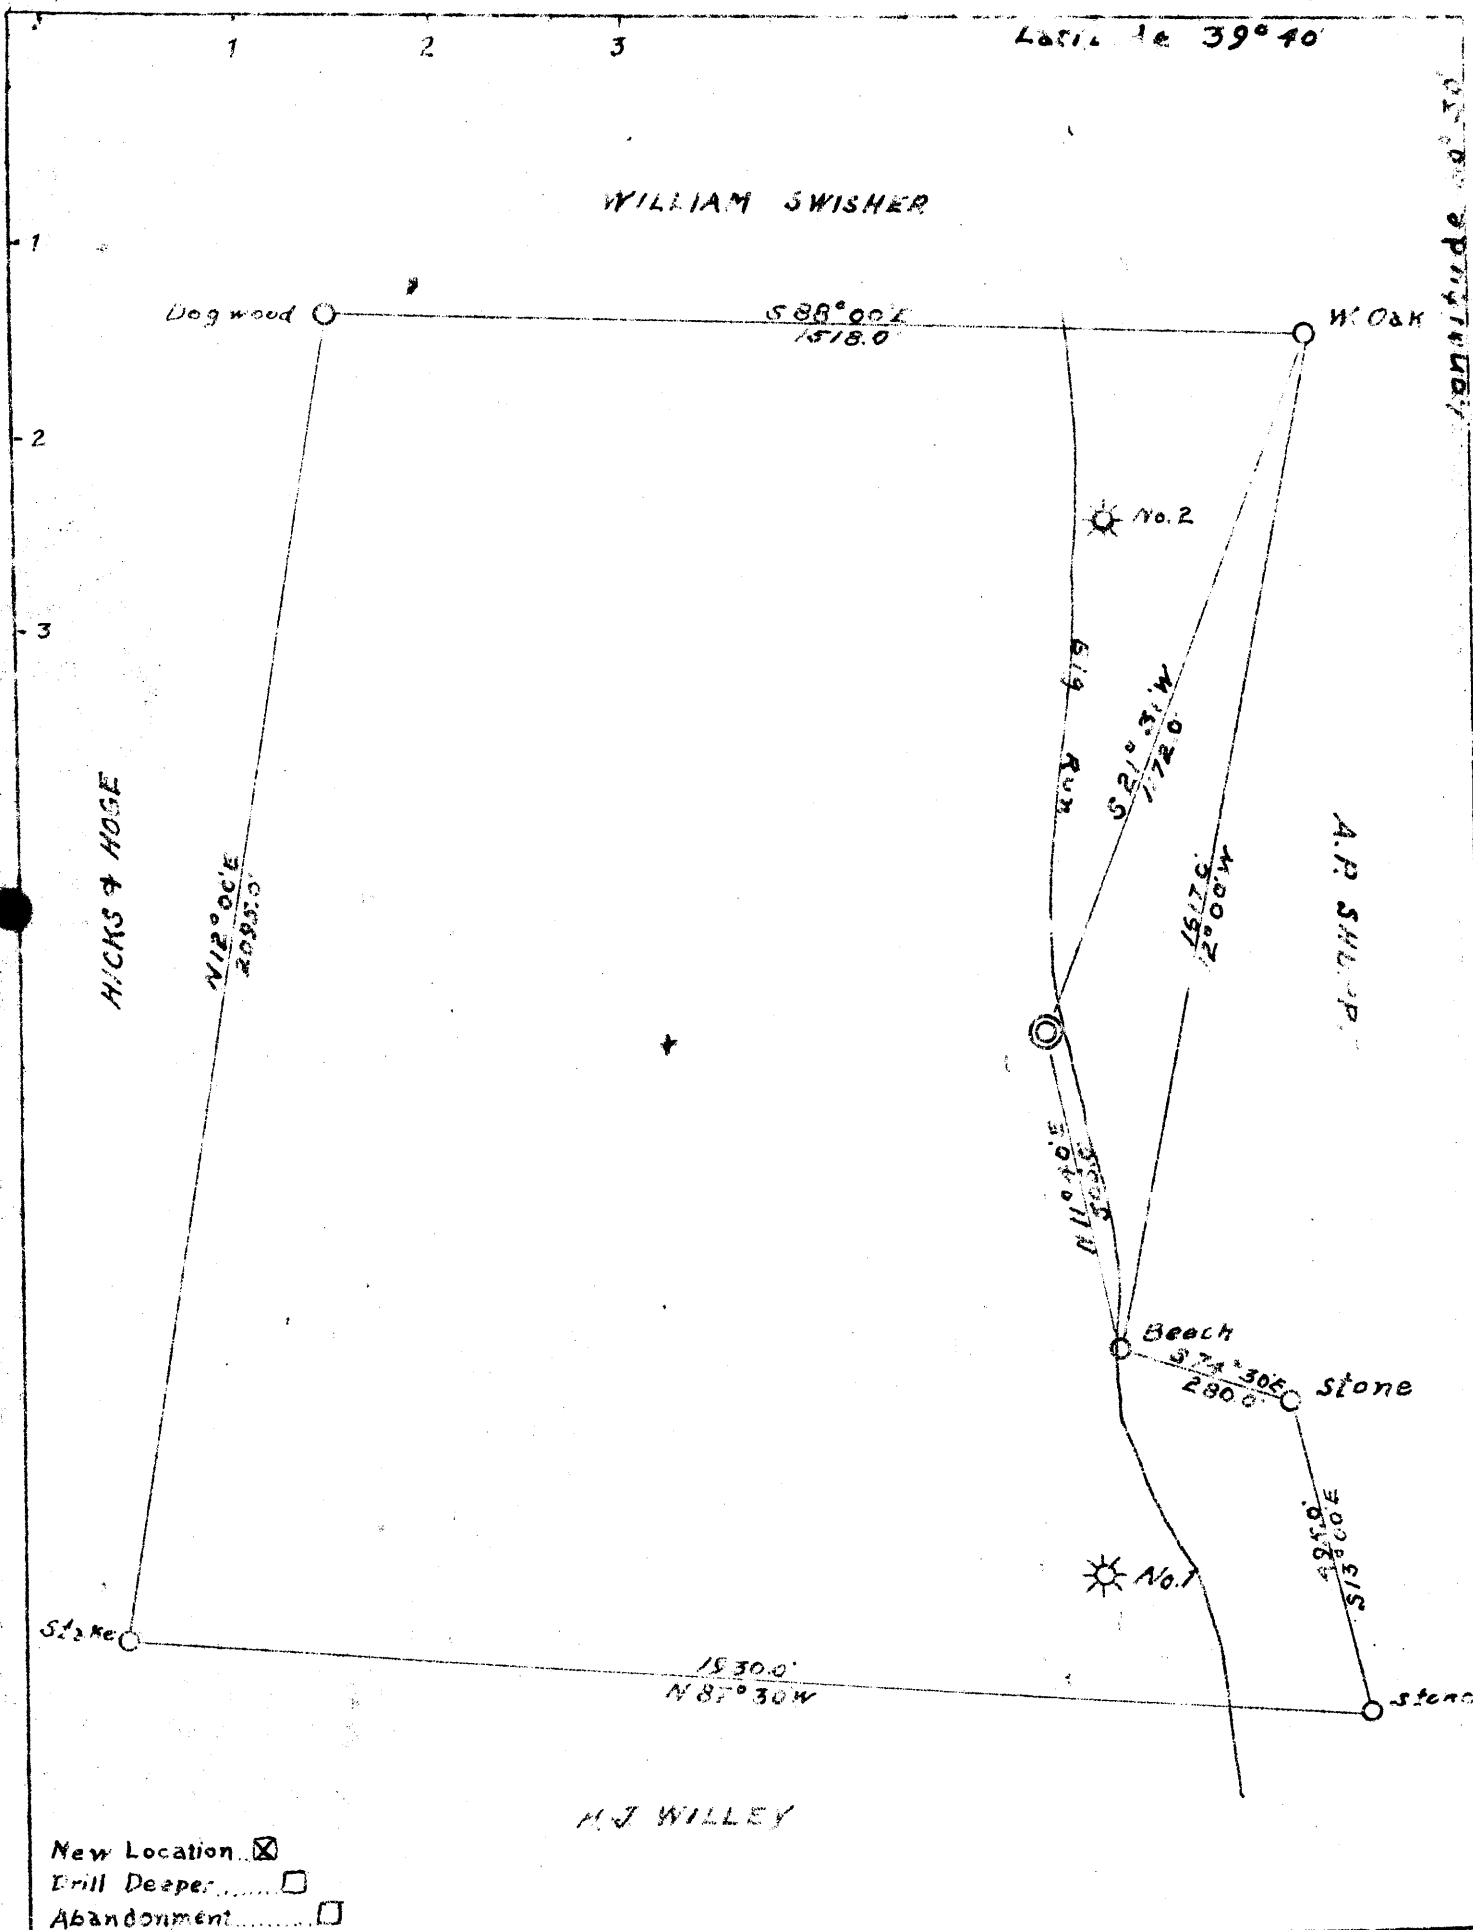

- New Location
- Drill Deeper
- Abandonment

Company FOSTER & MCKENZIE
 Address PITTSBURGH PA.
 Farm S.B. HIGGINBOTHAM
 Tract _____ Acres 74 Lease No. _____
 Well (Farm) No. 3 Serial No. _____
 Elevation (Spirit Level) 670
 Quadrangle LITTLETON
 County WETZEL District GRANT
 Engineer G. L. MCINTIRE
 Engineer's Registration No. 1187
 File No. _____ Drawing No. _____
 Date 4/21/51 Scale 1" = 300'

STATE OF WEST VIRGINIA
 DEPARTMENT OF MINES
 OIL AND GAS DIVISION
 CHARLESTON

WELL LOCATION MAP
 FILE NO. WET-373-REDRILL

+ Denotes location of well on United States Topographic Maps scale 1 to 62,500, latitude and longitude lines being represented by border lines as shown.

-- Denotes one inch spaces on border line of original tracing.