

Now LOCATION  
Drift Deeper...

Company	Quaker State Oil Refining Corp
Address	Parkersburg, West Virginia;
Farm	Rymer Davis,
Tract	One Acres 58-1/2
Lease No.	
Well (Farm) No.	1, Serial No.
Elevation (Spirit Level)	836 Feet,
Quadrangle	Littleton, S
County	Wetzel District Grant
Engineer	J. M. Buchanan.
Engineer's Registration No.	50; Surveyor,
File No.	Drawing No
Date	July 24 <sup>th</sup> 1951 Scale 1" = 400 Feet.

STATE OF WEST VIRGINIA  
DEPARTMENT OF MINES  
OIL AND GAS DIVISION  
CHARLESTON

WELL LOCATION MAP  
FILE NO. Wet-379-D

+ Denotes location of well on United States Topographic Maps, scale 1 to 62,500, latitude and longitude lines being represented by border lines as shown.

- Denotes one inch spaces on border line of original tracing.

WEST VIRGINIA DEPARTMENT OF MINES  
OIL & GAS DIVISION  
W E L L R E C O R D

Permit No. Wet-379-D  
Littleton Quad.

Oil

Company	Quaker State Oil Refining Corp.		CASING & TUBING	
Address	Box 1709, Parkersburg, W. Va.			
Farm	J.R. Davis	Acres 58 1/2	10	386
Location	Fishing Creek		3 1/4	1080
Well No.	1	Elev. 836'	6 5/8	1860
District	Grant	County -- Wetzol	5 3/16	2024
Surface	Mrs. MESSIE TAYLOR, Box 72, Bridgeport, W. Va.		2	2731
Commenced	5/1/52			
Completed	6/18/52			
Date Shot	6/25/52 from 2673 to 2705			
With	60 Qts.			
Oil	4 bbls.			

DRILLED DEEPER

✓ Sand Big Injun	1900	2120
Slate Dark	2120	2145
Sand	2145	2155
Slate	2155	2190
Sand	2190	2255
Slate	2255	2260
Sand	2260	2290
Slate	2290	2300
Slate & Shells	2300	2340
Slate	2340	2430
Lime	2430	2475
Slate & Sand	2475	2515
Red Rock and Slate	2515	2545
Sand	2545	2570
Slate & Lime	2570	2650
✓ Sand-Gordon Stray	2650	2668
Shale	2668	2669
✓ Sand-Gordon	2669	2706
Shale	2706	2731
TOTAL DEPTH		2731

Oil 1932  
Water 1985  
Oil 2706 Baker Core

Parmaco Screw Packer 6 5/8 x 5 3/16 set at 1876'  
Parmaco Anchor Packer 6 5/8 x 5 3/16 set at 1974'

2731  
1900  
-----  
831

WR-38  
DATE:

API# 47-103-0379

STATE OF WEST VIRGINIA  
DIVISION OF ENVIRONMENTAL PROTECTION  
OFFICE OF OIL AND GAS

AFFIDAVIT OF PLUGGING AND FILLING WELL

AFFIDAVIT SHOULD BE IN TRIPLICATE, one copy mailed to the Division, one copy to be retained by the Well Operator and the third copy (and extra copies if required) should be mailed to each coal operator at their respective addresses.

Farm name: Davis Operator Well No.: #1

LOCATION: Elevation: 850' Quadrangle: Fishing Creek  
District: Grant County: Wetzel  
Latitude: 39° Feet South of 32 Deg. 30 Min.      Sec.  
Longitude: 80° Feet West of 37 Deg. 30 Min.      Sec.


Well Type: OIL      GAS x

Company: Ross & Wharton for  
Quaker State  
Rt. 6, Box 123  
Buckhannon, WV 26201  
Agent: Mike Ross

Coal Operator                       
or Owner                     

Coal Operator                       
or Owner                     

Permit Issued Date: 1/18/01

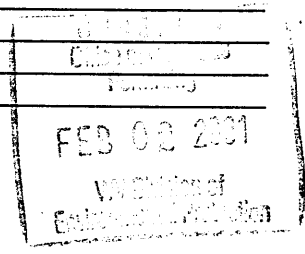

AFFIDAVIT

STATE OF WEST VIRGINIA,  
County of Upshur ss:

Robert Wharton and Don Elmer being first duly sworn according to law depose and say that they are experienced in the work of plugging and filling oil and gas wells and were employed by the above named well operator, and participated in the work of plugging and filling the above well, and Randy Mick Oil and Gas Inspector representing the Director, say that said work was commenced on the 22 day of Jan, 2001, and that the well was plugged and filled in the following manner:

TYPE	FROM	TO	PIPE REMOVED	LEFT
Gel	0	TD		
Cement	1900	1700	10'	
Cement	1150	1000	8'	
Cement	725	500	700' of 6"	
Cement	300	200	1400' of 5 3/16"	
Cement	100	0		

Description of monument: 6" pipe 54" high and that the work of plugging and filling said well was completed on the 22nd day of Jan., 2001, 19    .

And further deponents saith not.  
R. S. Wharton  
Don Elmer

FEB 09 2001

Sworn and subscribe before me this 22nd day of Jan., 2001 19    

My commission expires: Nov. 3, 2003

Steve Murray  
Notary Public

FEB 08 2001

Oil and Gas Inspector: Randy Mick

WEST 0319