

New Location
 Drill Bores
 Abandonment

Company Louis F. Sittel et al.
 Address 316 Broad Ave Pittsburg, 16 Pa PA,
 Farm MICHAEL BARR
 Tract _____ Acres 450 Lease No. 2876
 Well (Farm) No. 6 Serial No. _____
 Elevation (Spirit Level) 1133
 Quadrangle LITTLETON
 County WETZEL District GRANT
 Engineer J. M. Cochran
 Engineer's Registration No. CO. SURVEYOR
 P.M. No. _____ Drawing No. _____
 Date Aug 2, 1954 Scale 200' = 1"

STATE OF WEST VIRGINIA
 DEPARTMENT OF MINES
 OIL AND GAS DIVISION
 CHARLESTON

WELL LOCATION MAP
 FILE NO. WCT-407
P 11/29/1954

+ Denotes location of well on United States Topographic Maps, scale 1 to 62,500, latitude and longitude lines being represented by border lines as shown.

- Denotes one inch spaces on border line of original tracing.

6-0 48

STATE OF WEST VIRGINIA
DEPARTMENT OF MINES
OIL AND GAS DIVISION 6

Quadrangle Littleton

WELL RECORD

Permit No. WET-407

Oil or Gas Well Dry Hole
(KIND)

Company Louis F. Silhol, et al
Address 316 Agron Avenue, Pgh. 16, Pennsylvania
Farm Michael Barr Acres 450
Location (waters) Fishing Creek
Well No. 6 Elev. 1133 ft.
District Grant County Wetzel
The surface of tract is owned in fee by James A. Snider
2969 Elm St.
Attorney in fact Weirton, W. Va.
Mineral rights are owned by R. J. Hartman, Agent
5921 Walnut St.
Pittsburgh 32, Pa.
Drilling commenced August 16th, 1954
Drilling completed October 11th, 1954
Date Shot From 841 To 846
With 14 sticks dynamite


Casing and Tubing	Used in Drilling	Left in Well	Packers
Size			
16			Kind of Packer
13			
10			Size of
8 1/4			
6 5/8	346'	None	Depth set
5 3/16	752'	None	
3			Perf. top
2			Perf. bottom
Liners Used			Perf. top
			Perf. bottom

Open Flow /10ths Water in Inch
/10ths Merc. in Inch
Volume 25,000 Cu. Ft.
Rock Pressure lbs. hrs.
Oil bbls., 1st 24 hrs.
Fresh water 143 feet 208 feet
Salt water feet feet

CASING CEMENTED SIZE No. Ft. Date

COAL WAS ENCOUNTERED AT 438 FEET INCHES
591 FEET INCHES 740 FEET INCHES
FEET INCHES FEET INCHES

Formation	Color	Hard or Soft	Top	Bottom	Oil, Gas or Water	Depth Found	Remarks
Clay			0	23			
Rock			23	28			
Rock	Red		28	47			
Slate			47	68			
Rock			68	79			
Shale			79	92			
Slate			92	108			
Rock			108	115			
Slate			115	122			
Shale			122	154	Fresh water	143'	
Rock	Red		154	162			
Slate & Lime			162	196			
Shale	Blue		196	232	Fresh water	208'	
Rock	Red		232	247			
Slate			247	273			
Rock	Red		273	280			
Lime & Slate			280	302			
Shale	Blue		302	322			
Gritty Lime			322	328			
Slate			328	359			
Lime & Shell			359	428			
Slate			428	438			
Lime & Slate			438	475	Show coal	438'	
Sand			475	487			
Slate & Lime			487	605	Show coal	591'	
Lime		Hard	605	612			
Slate			612	620			
Lime	White	Hard	620	735			
Slate			735	740			

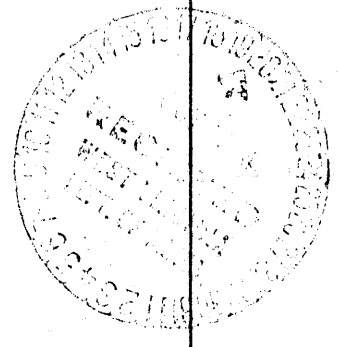

Formation	Color	Hard or Soft	Top 6	Bottom	Oil, Gas or Water	Depth Found	Remarks
Coal - Mapletown			740	741	Show gas	740'	
Slate			741	746			
Lime			746	787			
Slate			787	798			Steel line run at 787'
Gritty Lime			798	831			
Slate			831	836			
Slate	Black		836	840			
Shell			840	841	Little gas	842'	
Slate	Black)						
Horizon Pgh. Coal)			841	848			No Pgh. Coal
Slate &)							
Lime Shells)			848	890			Total depth

Date _____, 19____

APPROVED _____, Owner

By _____