


Latitude 39 40'

Pyles & Yeater

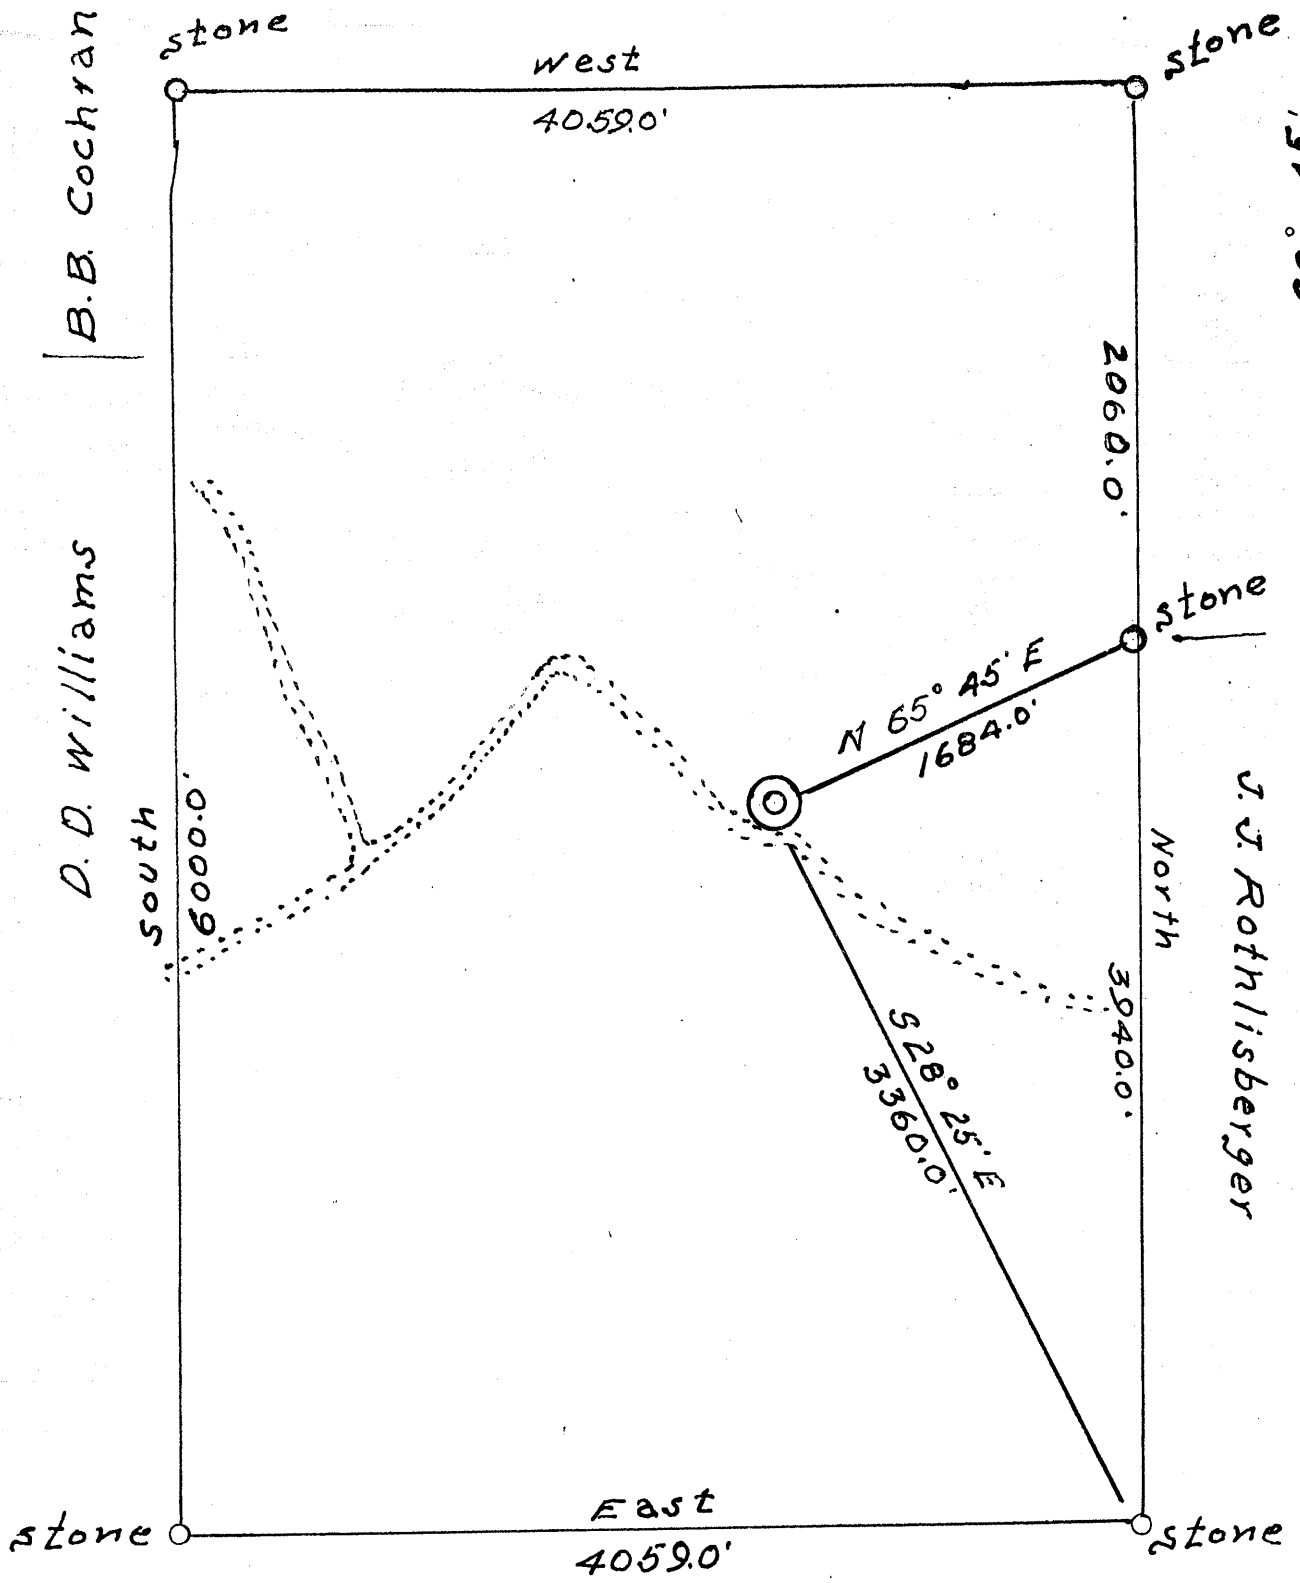

Lewis Hafley Hrs

New Location
 Drill Deeper
 Abandonment

Company Chas. J. Hughes & Munroe Lyeth
 Address Harry S. Peters Agt. Sistersville W.Va.
 Farm John Nice
 Tract _____ Acres 560 Lease No. _____
 Well (Farm) No. One Serial No. _____
 Elevation (Spirit Level) 1392
 Quadrangle New Martinsville
 County Wetzel District Magnolia
 Engineer George L. McArthur
 Engineer's Registration No. 1187
 File No. _____ Drawing No. _____
 Date 5/19/55 Scale 1" = 800'

STATE OF WEST VIRGINIA
 DEPARTMENT OF MINES
 OIL AND GAS DIVISION
 CHARLESTON

WELL LOCATION MAP
 FILE NO. Wet-413

+ Denotes location of well on United States Topographic Maps, scale 1 to 62,500, latitude and longitude lines being represented by border lines as shown.
 - Denotes one inch spaces on border line of original tracing.