


Latitude 39 ° 40 '

Longitude 80 ° 35 '

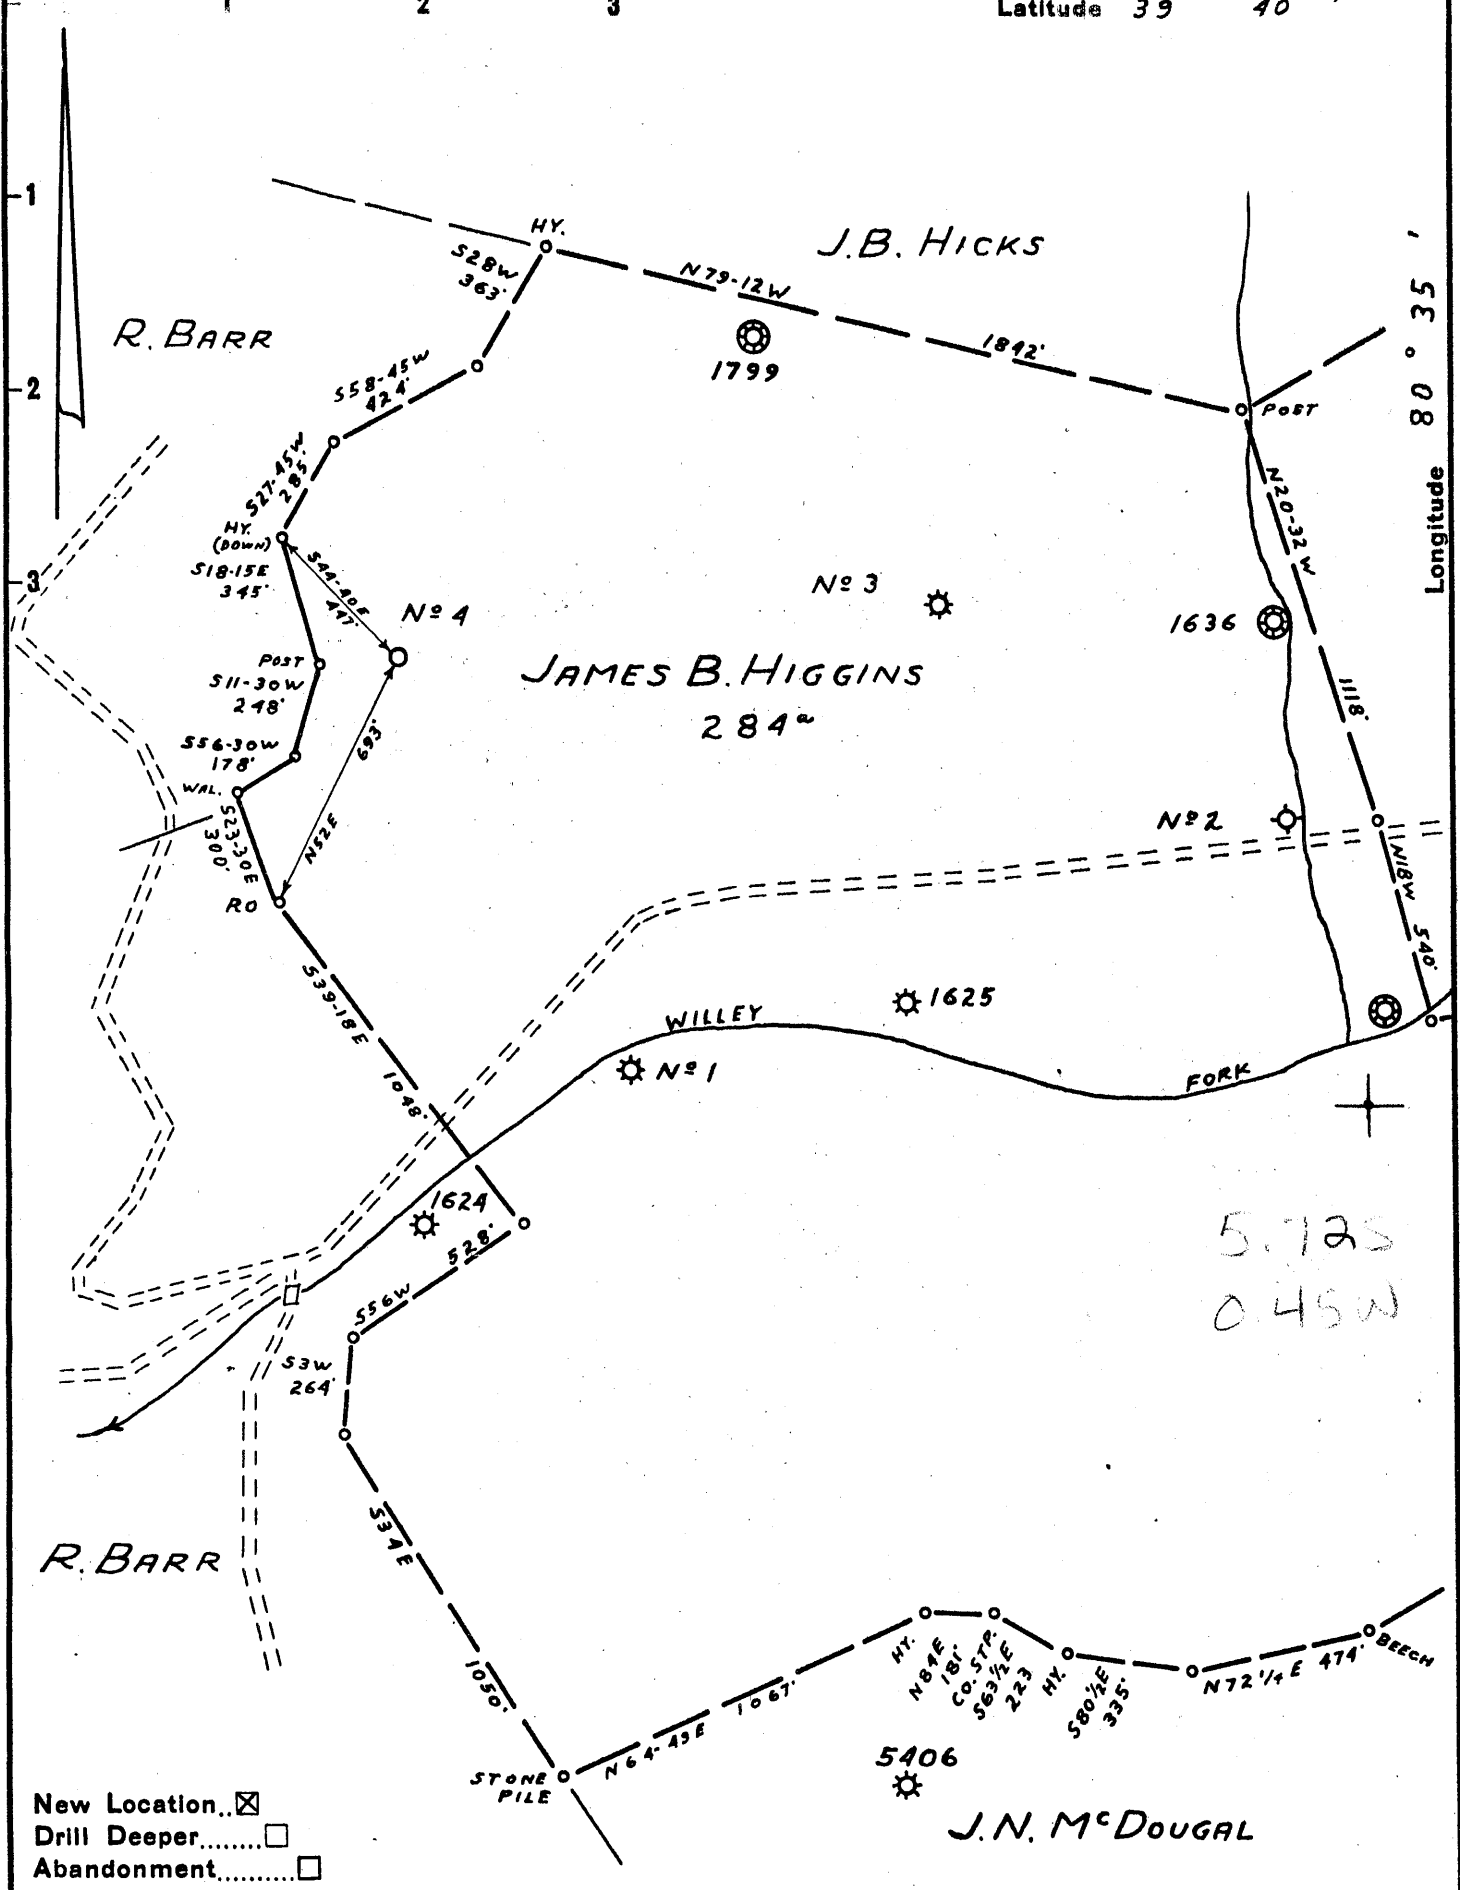

New Location...
 Drill Deeper.....
 Abandonment.....

Company P.C. McKENZIE Co.
 Address PITTSBURGH PA.
 Farm JAMES B. HIGGINS
 Tract _____ Acres 300 Lease No. _____
 Well (Farm) No. N^o 4 Serial No. _____
 Elevation (Spirit Level) 1153 VA
 Quadrangle LITTLETON SE 3-4 C
 County WETZEL District GRANT
 Engineer J. D. Jeffries
 Engineer's Registration No. 1084
 File No. 182 - 154 Drawing No. _____
 Date 2-15-56 Scale 1" = 500'

STATE OF WEST VIRGINIA
 DEPARTMENT OF MINES
 OIL AND GAS DIVISION
 CHARLESTON

WELL LOCATION MAP
 FILE NO. Wet-427

+ Denotes location of well on United States Topographic Maps, scale 1 to 62,500, latitude and longitude lines being represented by border lines as shown.

- Denotes one inch spaces on border line of original tracing.

WET-427

RDMC



STATE OF WEST VIRGINIA
DEPARTMENT OF MINES
OIL AND GAS DIVISION 10

Quadrangle Littleton

WELL RECORD

Permit No. WET-427

Oil or Gas Well Gas
(KIND)

Company P. C. McKenzie Co.
Address P.O. Box 10396, Pgh. 34, Pa.
James B. Higgins et al Acres 300
Farm _____
Location (waters) Fishing Creek
Well No. four (4) Elev. 1153'
District Grant County Wetzel
The surface of tract is owned in fee by James B. Higgins
Address Pine Grove, W. Va.

Mineral rights are owned by W. L. Higgins atty. in-fact
for Bessie W. Booth, et al Address Coburn, W. Va.

Drilling commenced April 12, 1956
Drilling completed April 23, 1956
Date Shot _____ From _____ To _____
With _____


Open Flow 22 /10ths Water in _____ Inch
/10ths Merc. in _____ Inch
Volume 35,000 Cu. Ft.
Rock Pressure 61 lbs. 30 mins. xxx
Oil _____ bbls., 1st 24 hrs.
Fresh water 120' feet _____ feet
Salt water _____ feet _____ feet

Casing and Tubing	Used in Drilling	Left in Well	Packers
Size			
16			Kind of Packer _____
13			
10			Size of _____
8 1/2			
8	<u>345'</u>	<u>pulled</u>	Depth set _____
6	<u>874'</u>	<u>874'</u>	
5 3/16			
3			Perf. top _____
2			Perf. bottom _____
Liners Used			Perf. top _____
			Perf. bottom _____

CASING CEMENTED _____ SIZE _____ No. Ft. _____ Date _____

COAL WAS ENCOUNTERED AT _____ FEET _____ INCHES
_____ FEET _____ INCHES _____ FEET _____ INCHES
_____ FEET _____ INCHES _____ FEET _____ INCHES

Formation	Color	Hard or Soft	Top	Bottom	Oil, Gas or Water	Depth Found	Remarks
Clay			0	10			
Sand			10	16			
Rock	Red		16	85			
Slate			85	100			
Rock	Red		100	150	Water @ 120'	2	bailers/hr.
Slate			150	195			
Rock	Red		195	205			
Slate			205	220			
Rock	Red		220	225			
Lime			225	257			
Slate			257	262			
Sand			262	272			
Lime	Black		272	280			
Rock	Red		280	295			
Lime			295	305			
Rock	Red		305	325			
Lime			325	335			
Slate			335	350			
Rock	Red		350	360			
Lime			360	380			
Slate			380	400			
Lime			400	420			
Slate			420	430			
Coal			430	431			
Lime			431	500			
Rock	Red		500	520			
Lime			520	540			
Sand			540	550			
Lime		Hard	550	590			
Slate	Black		590	600			
Rock	Red		600	625			
Lime			625	725			
Rock	Red		725	730			
Lime			730	796			
Slate			796	804			
Coal-Mapletown			804	805			
Slate			805	810			

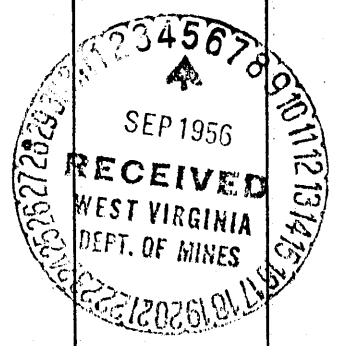

Description	Color	Hard or Soft	Top 10	Bottom	Oil, Gas or Water	Depth Found	Remarks
Lime	810	822					
Slate	822	827					
Lime	827	888					
Slate	888	896					
Lime	896	898					
Coal-Pgh.	898	908					
Lime-Gritty	908	912					
Slate	912	925					
Total Depth		925'					

Date _____, 19____

APPROVED _____, Owner

By _____