


Latitude 39° 40'

Longitude 80° 30'

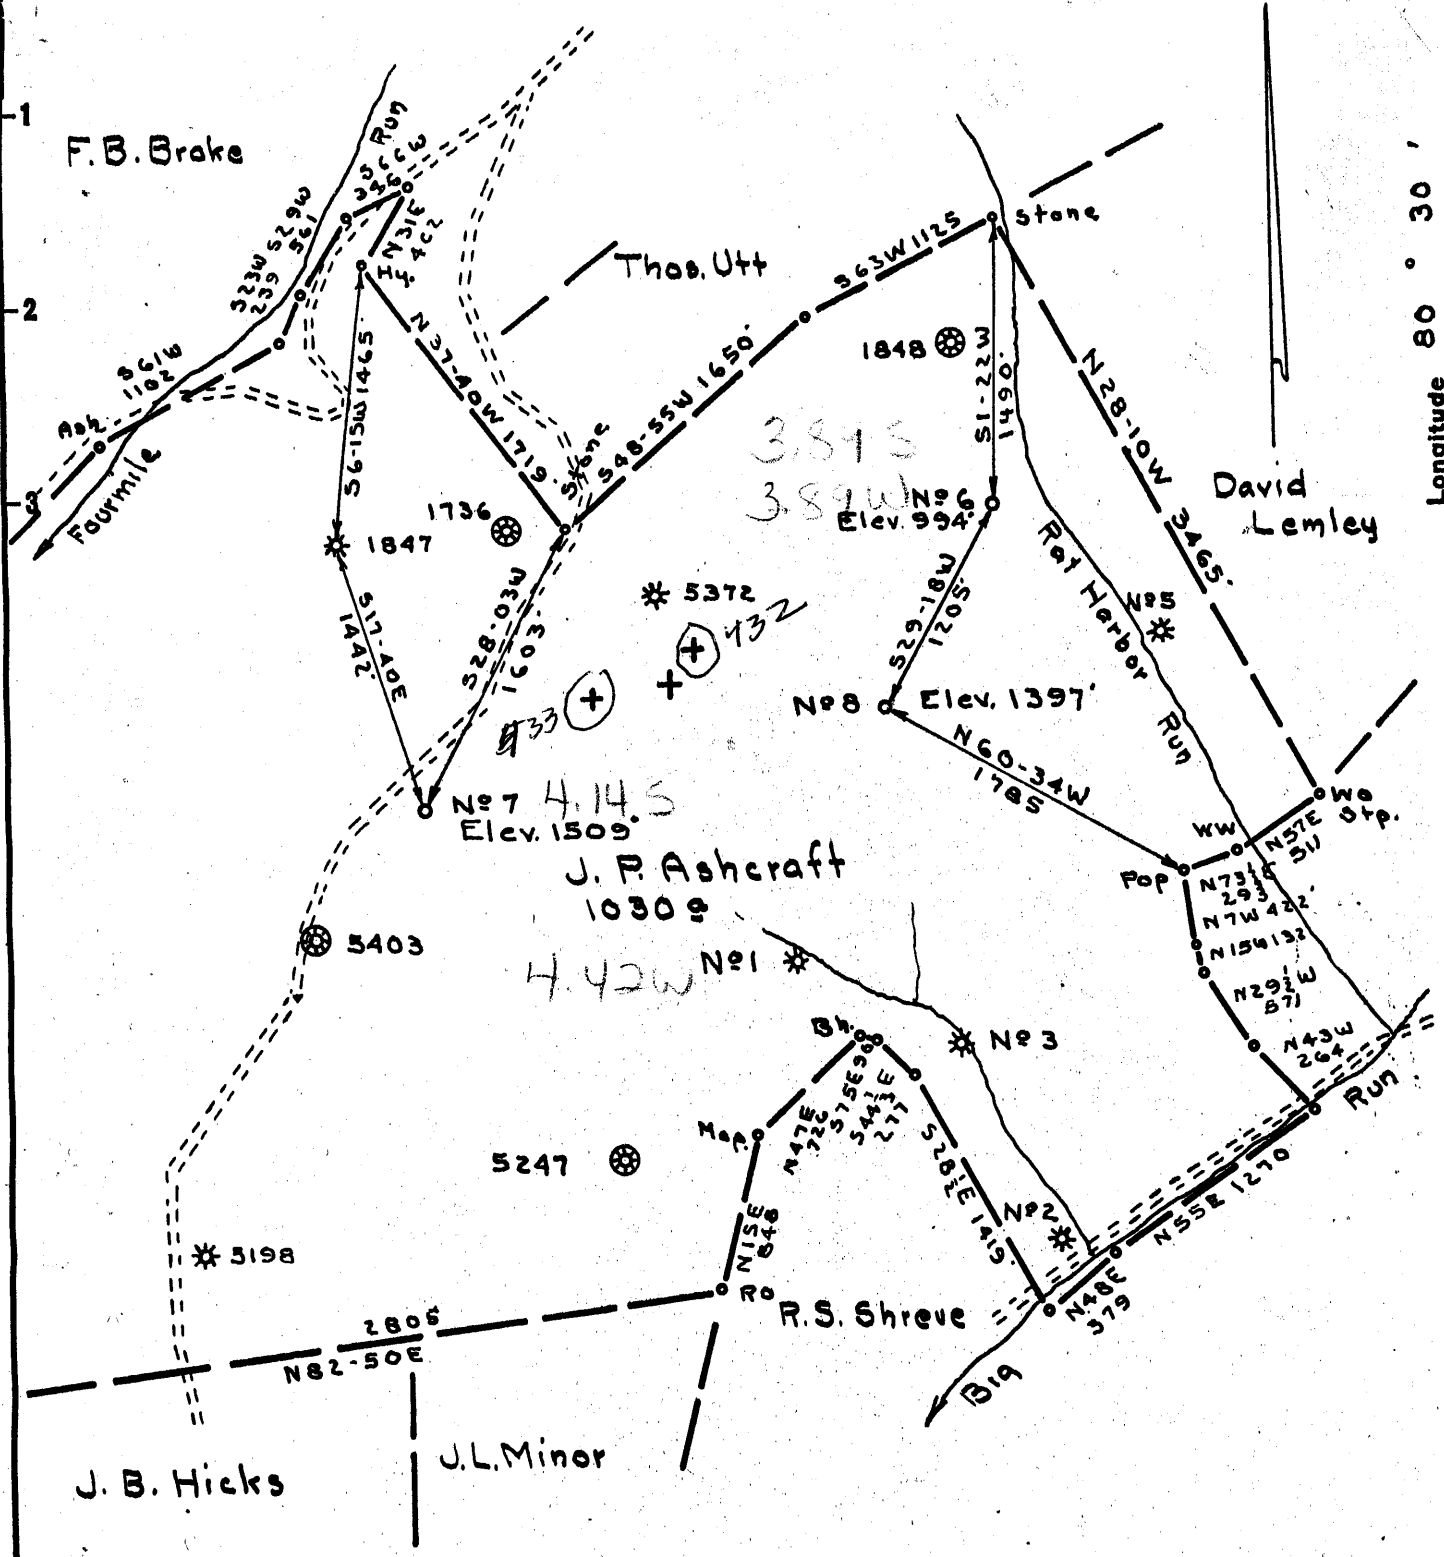

New Location...
 Drill Deeper.....
 Abandonment.....

Company R.C. McKenzie Co.
 Address Pittsburgh, Pa
 Farm J.P. Ashcraft
 Tract _____ Acres 1028 Lease No. _____
 Well (Farm) No. 6-7-8 Serial No. _____
 Elevation (Spirit Level) As Shown
 Quadrangle Littleton SE 1?
 County Wetzel District Grant
 Engineer James D. Jeffries
 Engineer's Registration No. 1084
 File No. 183/60 Drawing No. _____
 Date 5-9-56 Scale 1" = 1000'

STATE OF WEST VIRGINIA
 DEPARTMENT OF MINES
 OIL AND GAS DIVISION
 CHARLESTON

WELL LOCATION MAP

FILE NO. Wet-432-#6

433-#7
 434-#8

+ Denotes location of well on United States Topographic Maps, scale 1 to 62,500, latitude and longitude lines being represented by border lines as shown.

- Denotes one inch spaces on border line of original tracing.

+ 432 6-0 45
 + 1133 6-6 45