


Latitude 39° 30'

Longitude 80° 35'

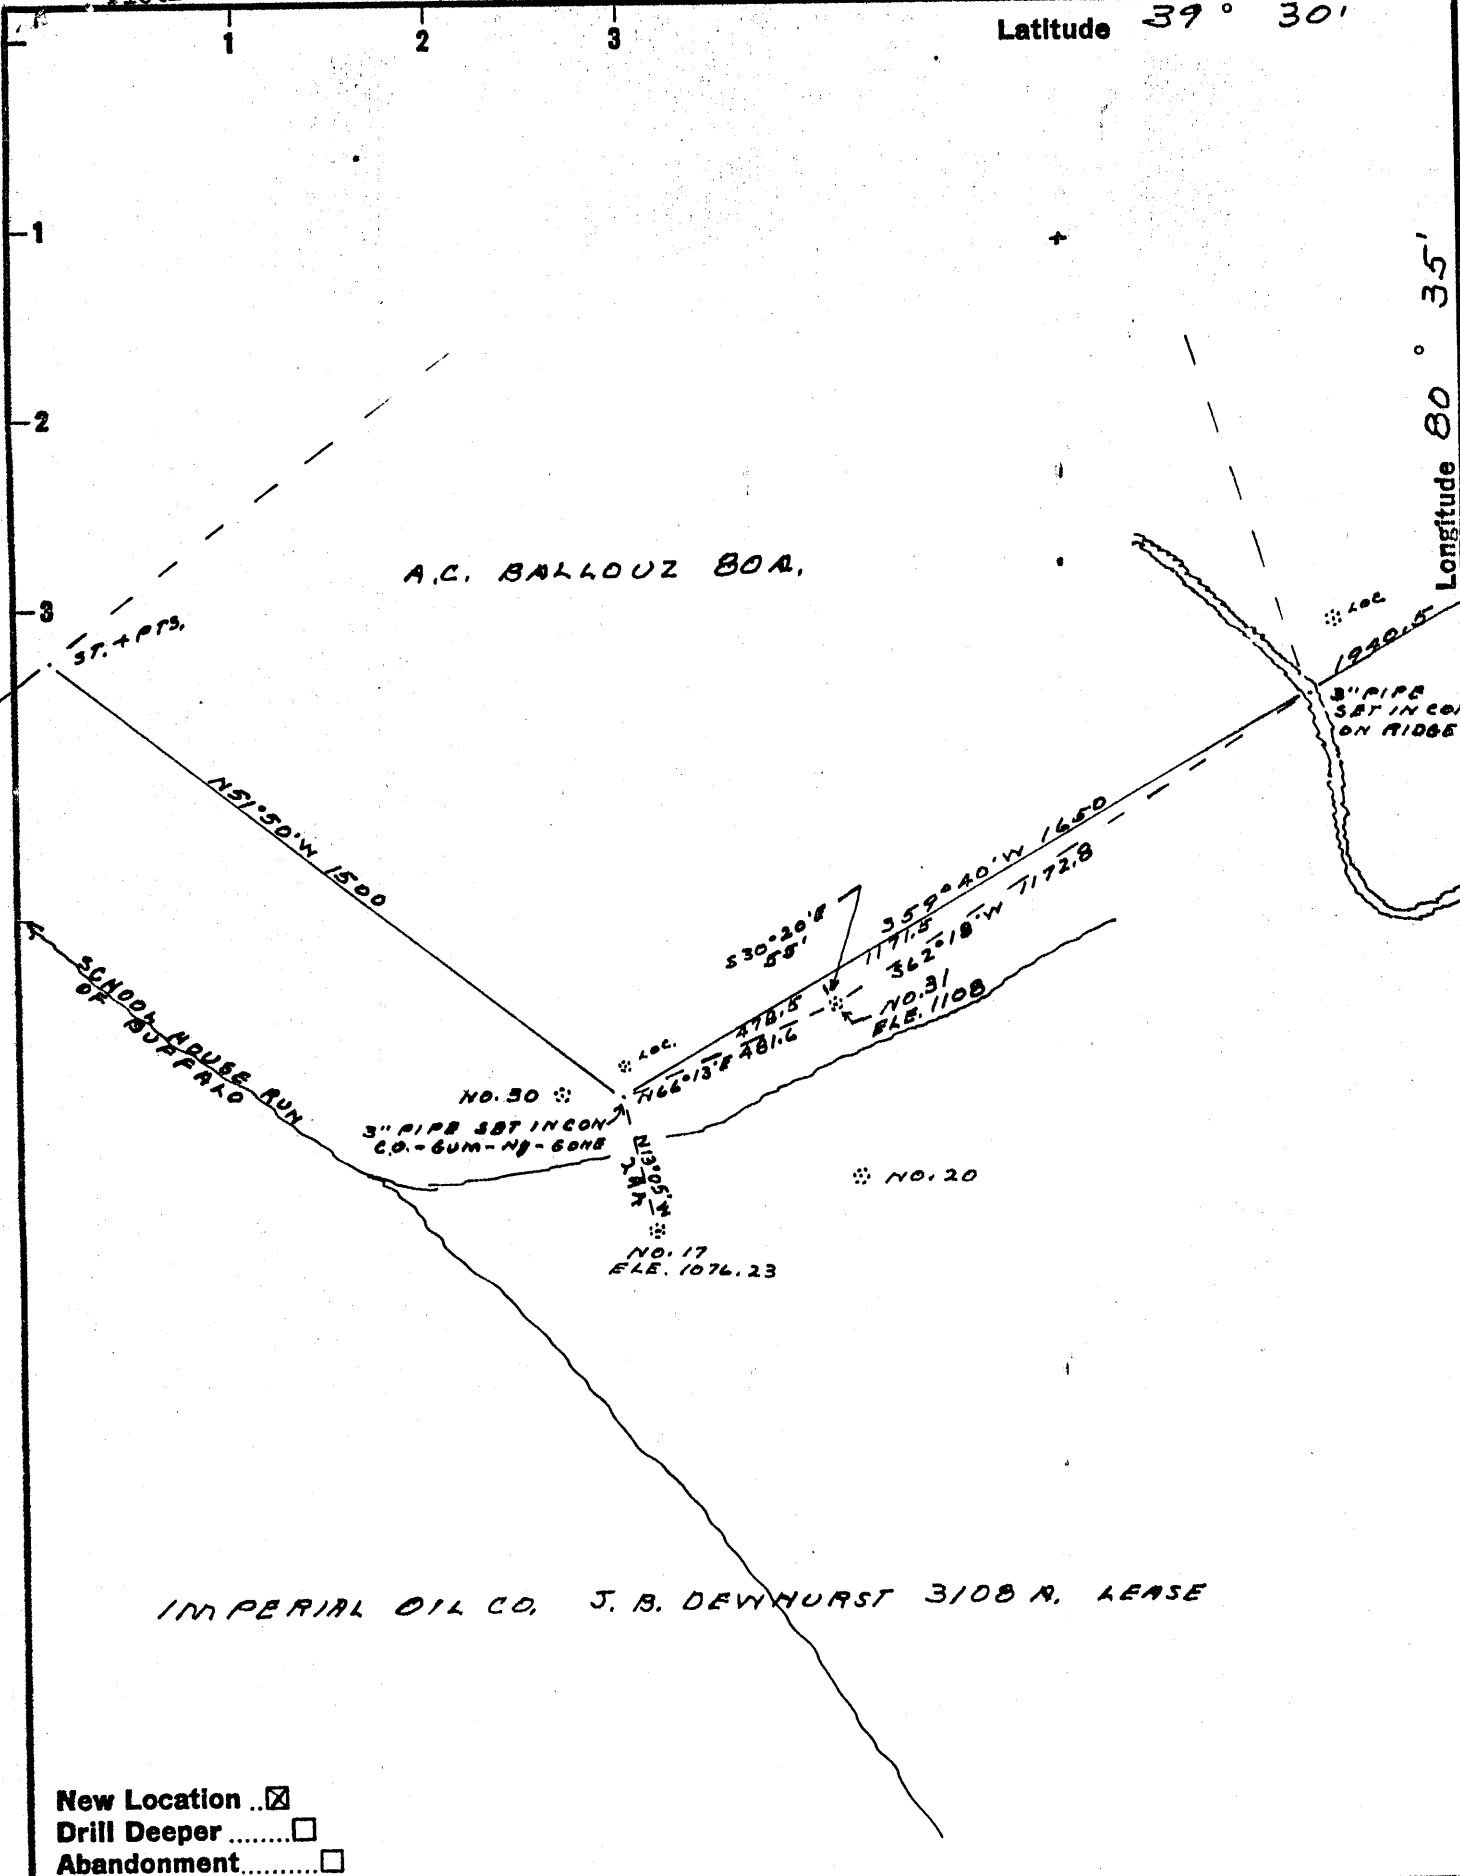

Company IMPERIAL OIL CO.
 Address 504 CARLTON HOUSE, PITTSBURGH 19, PA.
 Farm J. B. DEWHURST
 Tract 1 Acres 3108 Lease No. _____
 Well (Farm) No. 31 Serial No. _____
 Elevation (Spirit Level) 1108
 Quadrangle CENTERPOINT NC
 County WETZEL District GRANT
 Engineer Robert P. Wheeler
 BY J. HERBERT HIBBOTHAM
 Engineer's Registration No. 3582
 File No. _____ Drawing No. _____
 Date 12-9-60 Scale 1" = 400'

STATE OF WEST VIRGINIA
 DEPARTMENT OF MINES
 OIL AND GAS DIVISION
 CHARLESTON

WELL LOCATION MAP
 FILE NO. Wet-498
Cancelled - 7-7-61
 + Denotes location of well on United States Topographic Maps, scale 1 to 62,500, latitude and longitude lines being represented by border lines as shown.
 - Denotes one inch spaces on border line of original tracing.

Latitude 39° 30'

Longitude 80° 35'

A.C. BALLOUZ BOA.

ST. + PTS.

N51°50'W 1500

SCHOOLHOUSE RUN
OF SUTHERLAND

S30°20'E
55'

S59°40'W 1650
1171.5
362.18'W 7172.8

NO. 30
3" PIPE SET IN CON.
C.O. - GUM - NG - 608E

WELLS
NO. 17
ELE. 1076.23

NO. 20

NO. 31
ELE. 1108

LOC

3" PIPE
SET IN CON.
ON RIDGE

IMPERIAL OIL CO. J. B. DEWHURST 3108 A. LEASE

New Location
Drill Deeper
Abandonment

Company IMPERIAL OIL CO.

Address 504 CARLTON-ROUSE, PITTSBURGH 19, PA.

Farm J. B. DEWHURST

Tract 1 Acres 3108 Lease No. _____

Well (Farm) No. 31 Serial No. _____

Elevation (Spirit Level) 1108

Quadrangle CENTERPOINT NC

County WETZEL District GRANT

Engineer Robert P. Wheeler
BY S. NEASENT NIBBITHOTHAM

Engineer's Registration No. 3582

File No. _____ Drawing No. _____

Date 12-9-60 Scale 1" = 400'

STATE OF WEST VIRGINIA
DEPARTMENT OF MINES
OIL AND GAS DIVISION
CHARLESTON

WELL LOCATION MAP

FILE NO. Wet-498

+ Denotes location of well on United States Topographic Maps, scale 1 to 62,500, latitude and longitude lines being represented by border lines as shown.

- Denotes one inch spaces on border line of original tracing.

Too Crowded To Plot