

Hope Natural Gas Co.

API-103-0651.


LOCATION FOR WELL No. 19.

Pine Grove DISTRICT.

On D.H. Cox Farm, on waters of Upper Run.  
Grant District, Wetzel County, West Virginia.

Lease No. 528 Acres Range: N. 8 S. E. W. 1

Scale 1" = 800' Made Feb 4 1909.

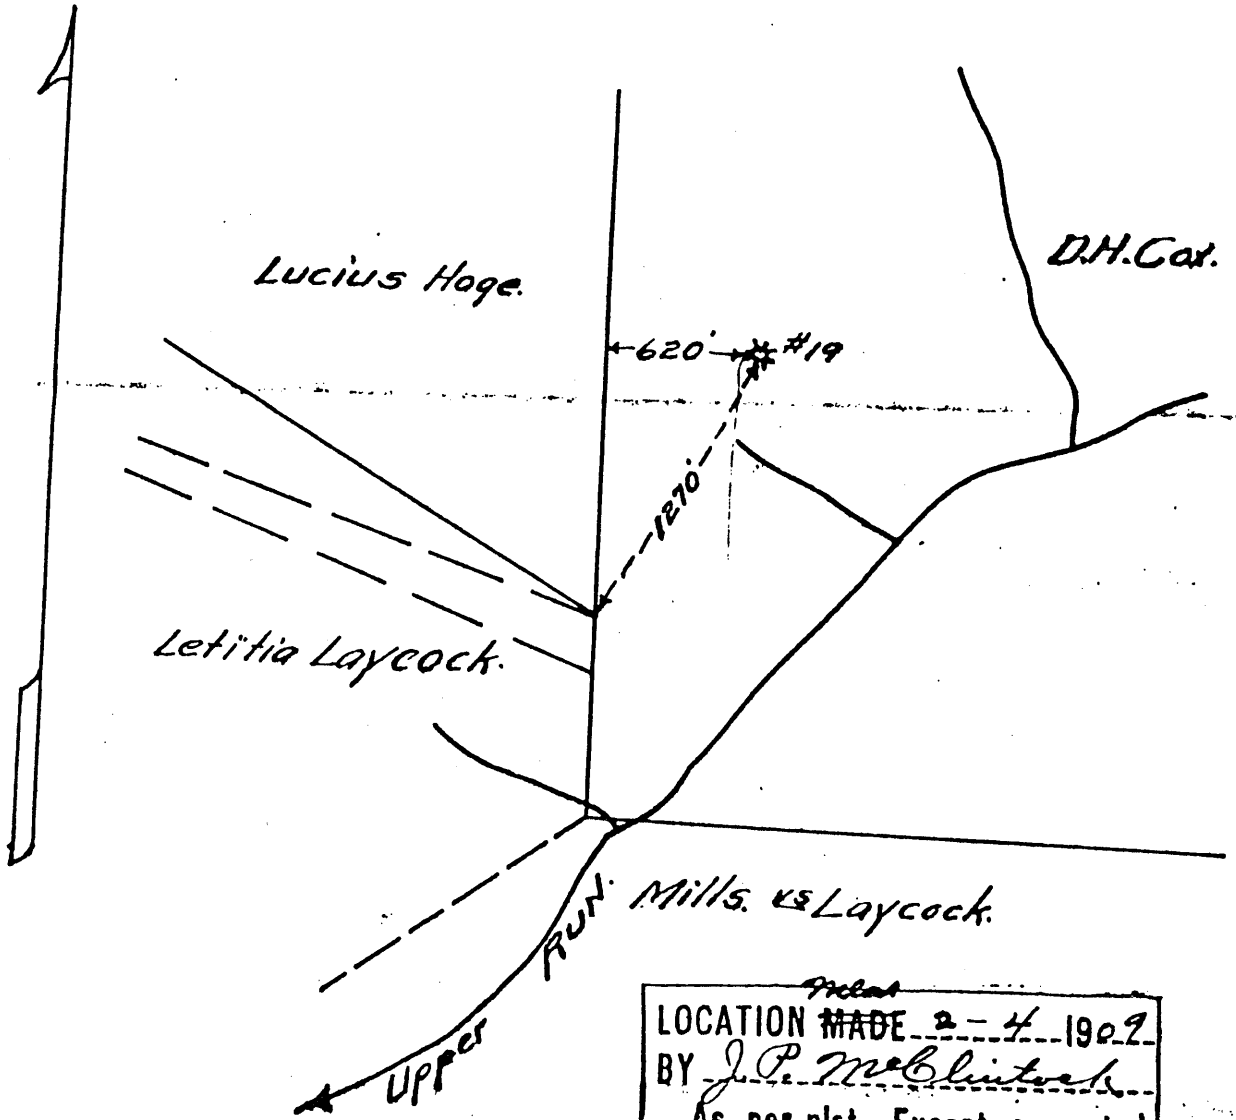


LOCATION MADE	2-4	1909
BY	J. P. McBlintock	
As per plat. Except as noted		
On Field Map		19
Recorded to Pittsburg		19

ENTERED  
LINE MAP  
1-4-1909  
E&S

RESERVE: .....  
.....  
SPECIAL INSTRUCTIONS: .....  
.....  
.....

LATITUDE 39° 35' 00"

LONGITUDE 88° 37' 30"

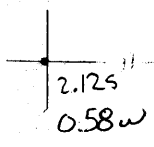

7'5 OGIS topo location

7.5' 10C ~~2.125~~ 15' 10C \_\_\_\_\_  
                   ~~0.42w~~ (calc.) \_\_\_\_\_

Company \_\_\_\_\_

Farm \_\_\_\_\_

Quad PINE GROVE 7 1/2'

County WETZEL

District GRANT

WELL LOCATION MAP

File No. 103-0651