

Hope Natural Gas Co.


LOCATION FOR WELL No. 34

Pine Grove DISTRICT.

F. F. Morgan Farm, on waters of Fishing Creek.  
Grant District, Wetzel County, West Virginia.

Lease No. 426 Acres Range: N. 9 S. — E. — W. 3

Scale 1" = 800' Made 10-29-1908

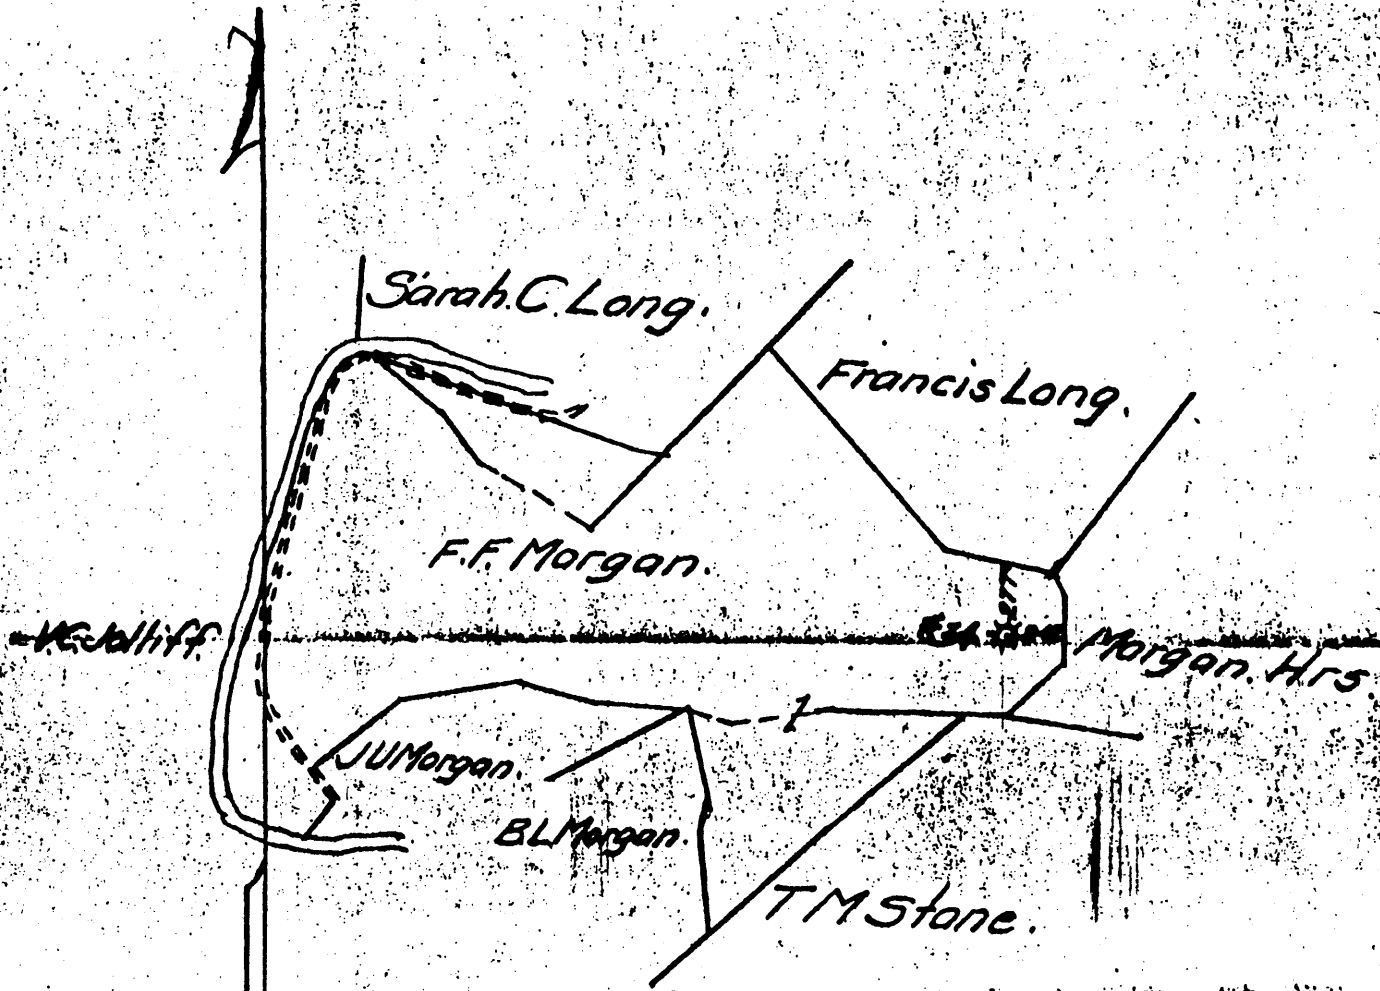

ENTERED	
WELL BOOK	_____
LEASE RECORD	_____
LEASE DOCKET	_____
WALL MAP	_____
WORKING MAP	_____
LOCATION BOOK	_____


Form No. H 100  
 ENTERED  
 LINE MAP  
 1-4 1908  
 BY: *[Signature]*

LOCATION MADE <sup>Men</sup> 10-29-1908  
 BY *J.P. McClintock*  
 As per plat. Except as noted  
 On Field Map \_\_\_\_\_ 19\_\_\_\_  
 Returned to Pittsburg \_\_\_\_\_ 19\_\_\_\_

RESERVE: .....

SPECIAL INSTRUCTIONS: ..... 103-0655

LATITUDE 39° 35' 00"

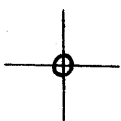

80° 40' 00"

LONGITUDE

7'5 OGIS topo location

7.5' 10C 1.035 15' 10C \_\_\_\_\_  
0.21W (calc.) \_\_\_\_\_

Company \_\_\_\_\_

Farm \_\_\_\_\_

Quad PINE GROVE 7 1/2'

County WETZEL

District GRANT

WELL LOCATION MAP

File No. 103-0655

(035)

34  
WELL RECORD.

8  
CASH

J. J. Morgan Farm Acres  
District Wetzel County W. Va. State

Well No. 1  
Rig Commenced ..... 190 }  
Rig Completed ..... 190 } Contractor  
Drilling Commenced 17/30 ..... 190 }  
Drilling Completed 7/7 ..... 190 } N. J. Banton Contractor

ROCK FORMATION.	TOP.	BOTTOM.	REMARKS.
Conductor	16.	16	
Ch. Coal.	927	928.	
Hard.	1415	1470	
Little Linn	2040	2050	
Amil Coal	2050	2060	
Big Linn	2060	2120	
Big Inyan	2120.	2395	
50 ft.	2790	2830.	
Red Rock	2830.	2870.	
Gray sd.	2947		
Gordon	2988.		
Gas.	2989.		
Total	3008.		

CASING RECORD.

Size.	Charged to Well.		Put in Well.		Pulled Out.		Left in Well.		Transferred Before Completion.		Left at Well, Not in Use.	
	Feet	In	Feet	In	Feet	In	Feet	In	Feet	In	Feet	In
10			785		785							
8 1/4			1420		1420.							
6 3/8			2174									
5 1/2			2239									
5 1/16												

Approved by \_\_\_\_\_ Supt.  
Production First 24 hours } ..... Bbls.

Proof.—Sum of Three right hand columns equals First or "Charged to Well."  
Use as many sheets as necessary to make a complete record.

103-0655