

SENT TO *W. G. C. L. 6-1-1908*
 RETURNED BY *6-9-08*

LOCATION FOR WELL

LOCATION FOR WELL No. 1075

Pittsburgh DISTRICT.

On *John Codd* Farm, on waters of *State Road Run*
Green District, *Netzel* County, West Virginia.


Lease No. *5323* Acres *70* Range: N. *8* S. E. W. *8*

Scale *1" = 80 poles* Made *June 6 1908*

ENTERED	
WELL BOOK
LEASE RECORD
LEASE DOCKET
WALL MAP	<i>6-11-08</i>
WORKING MAP
LOCATION BOOK

Wet - 681

ENTERED
 LINE MAP
On line map.
 BY

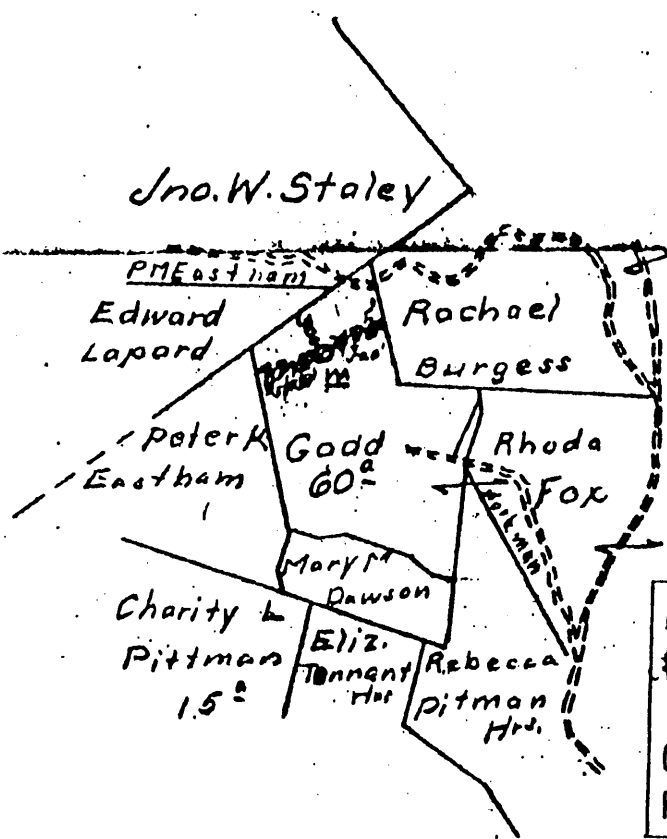

LOCATION MADE *6-5 1908*
 BY *Geo. W. Packard*
 As per plat. Except as noted
 On Field Map *June 6 1908*
 Returned to Pittsburgh *JUN 19 1908*

OK


RESERVE: *Three hundred feet around the buildings*

SPECIAL INSTRUCTIONS:

LATITUDE 39° 35' 00"

88° 54' 00"

LONGITUDE

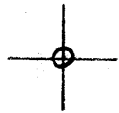

7.5 OGIS topo location

7.5' loc 2.225 15' loc _____
 0.54w (calc.) _____

Company _____

Farm _____

Quad PORTERS FALLS 7 1/2'

County WETZEL

District GREEN

WELL LOCATION MAP

File No. 106-0681

(035)

Wm Gadd
 Grant District Wetzel County W Va State
 Farm _____ Acres _____
 Well No. 1075
 Rig Commenced July 15 1908
 Rig Completed " 20 1908
 Drilling Commenced July 30 1908
 Drilling Completed Feb 19 1909
 Jno Craig Contractor.
 J P Fitch Contractor.

ROCK FORMATION.	TOP	BOTTOM.	REMARKS.
9th Coal	752	756	
Murphy Sand	776	780	
Little Sand	1062	1065	
Big Sand	1270	1304	
Coal	1393	1397	
Fire Gas Sand	1425	1462	
Coal	1498	1502	
2nd Gas Sand	1565	1590	
Fire Salt Sand	1706	1817	Water - 1738-1740 & 1793
Little Lime	1900	1915	
Pencil Ore	1915	1920	
Big Lime	1920	1990	
Big Injun	1990	1995	
Gas			
Total depth		2025	

W. L. FOCK
 LEASE NO. 10000
 WALL NO. 22-27-09
 WORKING CAP.
 LOCATION LOCK

Shut in on 8 1/4" casing Feb 19-1909

First hole drilled to 2013 ft and abandoned.

2 jts of 8 1/4 in Casing and 1 - 10 x 8 1/4 in B H Packer
 left in old hole. - casing damaged =
 23 1/2 ft 13 in
 147 5/12 ft 10 in
 164 1/2 ft 8 1/4 in

CASING RECORD.

Size.	Charged to Well.		Put in Well.		Pulled Out.		Left in Well.		Transferred Before Completion.		Left at Well, Not in Use.	
	Feet.	In.	Feet.	In.	Feet.	In.	Feet.	In.	Feet.	In.	Feet.	In.
13	304	9	214	10			214	10			89	11
10	1464	8	1276	9			1276	9			187	11
8 1/4	2242	11	1922	10			1922	10			280	1

Production first 48 hours } 7/10 Water
 thru 8 1/4
 Approved by J. W. P. Supt.

Proof - Sum of Three right hand columns equals first or "Charged to Well."
 Use as many sheets as necessary to make a complete record.
 In making out this record please use copying ink or an indelible pencil.

Wet - 581

DEFECTIVE WELL REPORT

74-71
94-72

22

DATE May 23, 1972 MAP 47 N 8 E 8 W TOWN, TWP. Green COUNTY Watauga
 WELL NO. 1075 NAME William Gadd DISTRICT Green WORKING DISTRICT Mannington

ORIG. OPEN FLOW No Record SAND _____ TEST FOR THIS REPORT: DATE 9-2-71 SAND Gordon
 ORIG. ROCK PRES. _____ DATE _____ OPEN FLOW 18.4 ROCK PRES. 22

ORIG. BARRELS _____ Dolly No. _____ DATE _____ BARRELS _____ Dolly No. _____ DATE _____
 SANDS No Record SANDS None

PRESENT CASING RECORD

SIZE	WT.	GR.	AMT. RUN	SHOE OR PACKER	SET AT	CEMENTED WITH	DATE RUN	CONDITION OF CASING
10			460					
8 1/4			1922					
6 5/8			2050					
5 3/16			2456					
2 3/8			2915					

HISTORY OF WELL

Depth of Pittsburgh Coal 752 Original Depth 2025 Present Depth 2897
 Well Producing Gas Gordon Sand _____ at depths of 2848 Oil Produced by None
Oil Sand _____ Condition of Rig _____

Amount of Cavings in holes _____ Amount of Water _____ Amount of Oil _____
 Date well cleaned out: 9-2-71 155 Ga. Water Results From 10.6 OF to 18.4 OF

Date well treated 11-7-19 Resulting open flow _____

Type of treatment: Floc. Shot 2848 (where) Acidize _____ (Other) _____

Remarks: 4 1/2 / 10 W 2" OF Inc to 45 / 10 W 2" OF

2897
2025
872 new log

What should be done with well in my opinion: Suggest sell for abandonment per Roy Doman Functional Study

Date 7/10/72 District Superintendant [Signature]
 I would recommend As above.

Date 7-14-72 Division Superintendant [Signature]
 I would recommend _____

Form No. 100 Special 40 lbs. 8-64

SPECIAL VOLUME AND PRESSURE REPORT

WELL No. 1075 OWNER OF WELL Hope Natural Gas Company, DISTRICT Pine Grove
 FARM NAME William Gadd

DATE OF TEST	FLOW METER OR OPEN FLOW	SIZE OF OPENING	PITOT TUBE		OPEN FLOW LBS.	SAND GAS FROM	Special test requested by: _____
			READING	LIQUID USED			
7-17-45	6-5/8"	1/2"	5/10	water	4611 OF	Inj	J A Clark
2 hr	5-5/16"	1/4"	None	Water	None	No record	
	2"	1"	10/10	water	23814 OF	Gordon	

DATE OF TEST	OPENING	PRESSURE TEST											
		1 MIN.	2 MIN.	3 MIN.	4 MIN.	5 MIN.	6 MIN.	7 MIN.	8 MIN.	9 MIN.	10 MIN.	30 MIN.	60 MIN.
7-20-45	6" CASING	72 hr. rock	11 Lbs.			7-23-45	144	12	12 lbs	7-24-45	168	168 hr. rock	
	5" CASING	72 "	None			7-23-45	144	" "	None	7-24-45	168	168 hr. rock	
	2" TUBING	78 "	50 Lbs			7-23-45	144	" "	50 Lbs.	7-24-45	168	168 hr. rock	

REMARKS _____

OIL: FROM None SAND _____

ESTIMATED PRODUCTION _____ BBL. PER DAY _____

Wet - 681