

# HOPE NATURAL GAS CO.

LOCATION FOR WELL No. 3863

DISTRICT

*E. B. Metzger*  
*E. B. Metzger*

Farm in waters of

*N. T. Fishing Creek*

District

*Metzger*

County, West Virginia.

No. 23160

Acres

*50*

N.

*7*

S.

E.

*6*

W.

one inch equals

*800 feet*

Sent to Clarksburg Office


*June 9 1915*

Location to be

*600 feet from Wm K. Simpson farm and 400 feet from*  
*W. H. ...*

*6-9-15*

*R. P. Wells (signifying landowner)*  
*Smithfield, W. Va.*

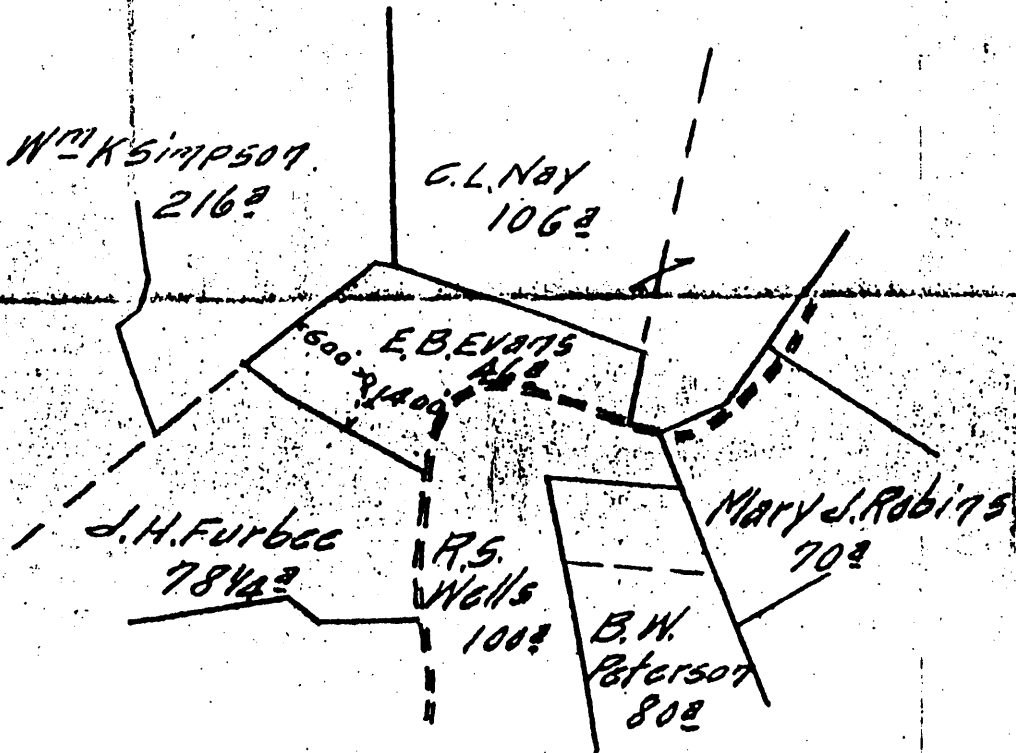

*ARI - 103 - 0693*

*31*  
*27*

TITLE

RESERVE *Two hundred feet around the*  
*well and farm buildings*

SPECIAL INSTRUCTIONS: COMPLETE WELL ON OR BEFORE

*Nov 27, 1915*

Location made *6-11-15* by *D. B. Lacey* As per plat, ~~except as noted~~. On field map

*6-14-15* Returned to Pittsburgh *6-14-15*

changed on account of

Drawn by

Date

Signed



