


FILE NO. _____
 DRAWING NO. _____
 SCALE 1" = 400'
 MINIMUM DEGREE OF ACCURACY 1" IN 500'
 PROVEN SOURCE OF ELEVATION USGS TOPOGRAPHIC QUAD SHEET

I THE UNDERSIGNED, HEREBY CERTIFY THAT THIS PLAT IS CORRECT TO THE BEST OF MY KNOWLEDGE AND BELIEF AND SHOWS ALL THE INFORMATION REQUIRED BY LAW AND THE REGULATIONS ISSUED AND PRESCRIBED BY THE DEPARTMENT OF MINES.
 (SIGNED) Duane R. Dishong
 R.P.E. 8993 L.L.S.

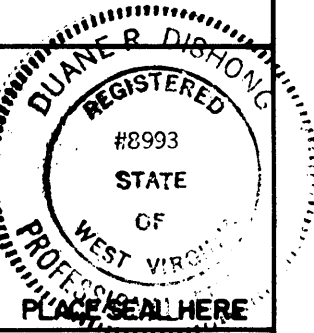

(+) DENOTES LOCATION OF WELL ON UNITED STATES TOPOGRAPHIC MAPS
 FORM IV-6 (8-78)



DATE JUNE 6, 19 96
 OPERATOR'S WELL NO. 713
 API WELL NO. 47 103 00772-P
 STATE COUNTY PERMIT

STATE OF WEST VIRGINIA
 DEPARTMENT OF MINES
 OIL AND GAS DIVISION

WELL TYPE: OIL GAS LIQUID INJECTION WASTE DISPOSAL
 (IF "GAS,") PRODUCTION STORAGE DEEP SHALLOW
 LOCATION: ELEVATION 975' WATER SHED FORK FISH CREEK
 DISTRICT CHURCH COUNTY WETZEL
 QUADRANGLE HUNDRED
 SURFACE OWNER R.L. KIMBLE ACREAGE 55.65
 OIL & GAS ROYALTY OWNER N. KENNEDY LEASE ACREAGE 48
 LEASE NO. 8791
 PROPOSED WORK: DRILL CONVERT DRILL DEEPER REDRILL FRACTURE OR STIMULATE PLUG OFF OLD FORMATION PERFORATE NEW FORMATION OTHER PHYSICAL CHANGE IN WELL (SPECIFY)
Well drilled in 1917 to 2875' Produced from fifth sand of thirty ft.
 PLUG AND ABANDON CLEAN OUT AND REPLUG
 TARGET FORMATION BIG DUNKARD ESTIMATED DEPTH 2875
 WELL OPERATOR CARNEGIE NATURAL GAS DESIGNATED AGENT H. BOGGS - OPERATIONS MANAGER
 ADDRESS 800 REGIS AVE ADDRESS P.O. BOX 387
PITTSBURGH, PA 15236 MANNINGTON, WV 26582

SEP 04 1996
 STATE OF WEST VIRGINIA
 DIVISION OF ENVIRONMENTAL PROTECTION
 SECTION OF OIL AND GAS

Permitting
 Office of Oil & Gas AFFIDAVIT OF PLUGGING AND FILLING WELL

AFFIDAVIT SHOULD BE IN TRIPLICATE, one copy mailed to the Division, one copy to be retained by the Well Operator and the third copy (and extra copies if required) should be mailed to each coal operator at their respective addresses.

Farm name: KIMBLE, ROCKY L. Operator Well No.: KENNEDY #713

LOCATION: Elevation: 975.00 Quadrangle: MANNINGTON
 District: CHURCH County: WETZEL
 Latitude: 7150 Feet South of 39 Deg. 42 Min. 30 Sec.
 Longitude 7020 Feet West of 80 Deg. 27 Min. 30 Sec.

Well Type: OIL _____ GAS X

Company: CARNEGIE NATURAL GAS Coal Operator NONE
800 REGIS AVENUE or Owner _____
PITTSBURGH, PA _____

Agent: DOUGLAS R. NAY Coal Operator _____
 or Owner _____

Permit Issued: 07/08/96

AFFIDAVIT

STATE OF WEST VIRGINIA,
 County of MARION ss:

ROBERT W. CARTER and RALPH C. WRIGHT being first duly sworn according to law depose and say that they are experienced in the work of plugging and filling oil and gas wells and were employed by the above named well operator, and participated in the work of plugging and filling the above well, and RANDAL MICK Oil and Gas Inspector representing the Director, say that said work was commenced on the 10TH day of JUNE, 1996, and that the well was plugged and filled in the following manner:

| GEL | TYPE | FROM TD | TO SURFACE | PIPE REMOVED | LEFT |
|-----|-------------|---------|------------|---------------------|------|
| | CEMENT PLUG | 2800 | 2550 | | |
| | CEMENT PLUG | 2150 | 1800 | RIP 7" THROUGH COAL | |
| | CEMENT PLUG | 1230 | 1130 | BEDS (per R. MICK) | |
| | CEMENT PLUG | 700 | 500 | 304' 7" CASING | |
| | CEMENT PLUG | 325 | 225 | | |
| | CEMENT PLUG | 175 | 125 | 152' 10" CASING | |
| | CEMENT PLUG | 50 | SURFACE | | |

Description of monument: 7" CASING WITH WELL NO. & API# & COMPANY NAME
 and that the work of plugging and filling said well was completed on the 16TH day of JULY, 1996.

And further deponents saith not.

Ralph C. Wright
Robert W. Carter

Sworn and subscribe before me this 18TH day of JULY, 1996
 My commission expires: OCTOBER 26, 2001

J. Wayne Jones
 Notary Public

Oil and Gas Inspector: *Randal Mick*

SEP 16 1996