


30983

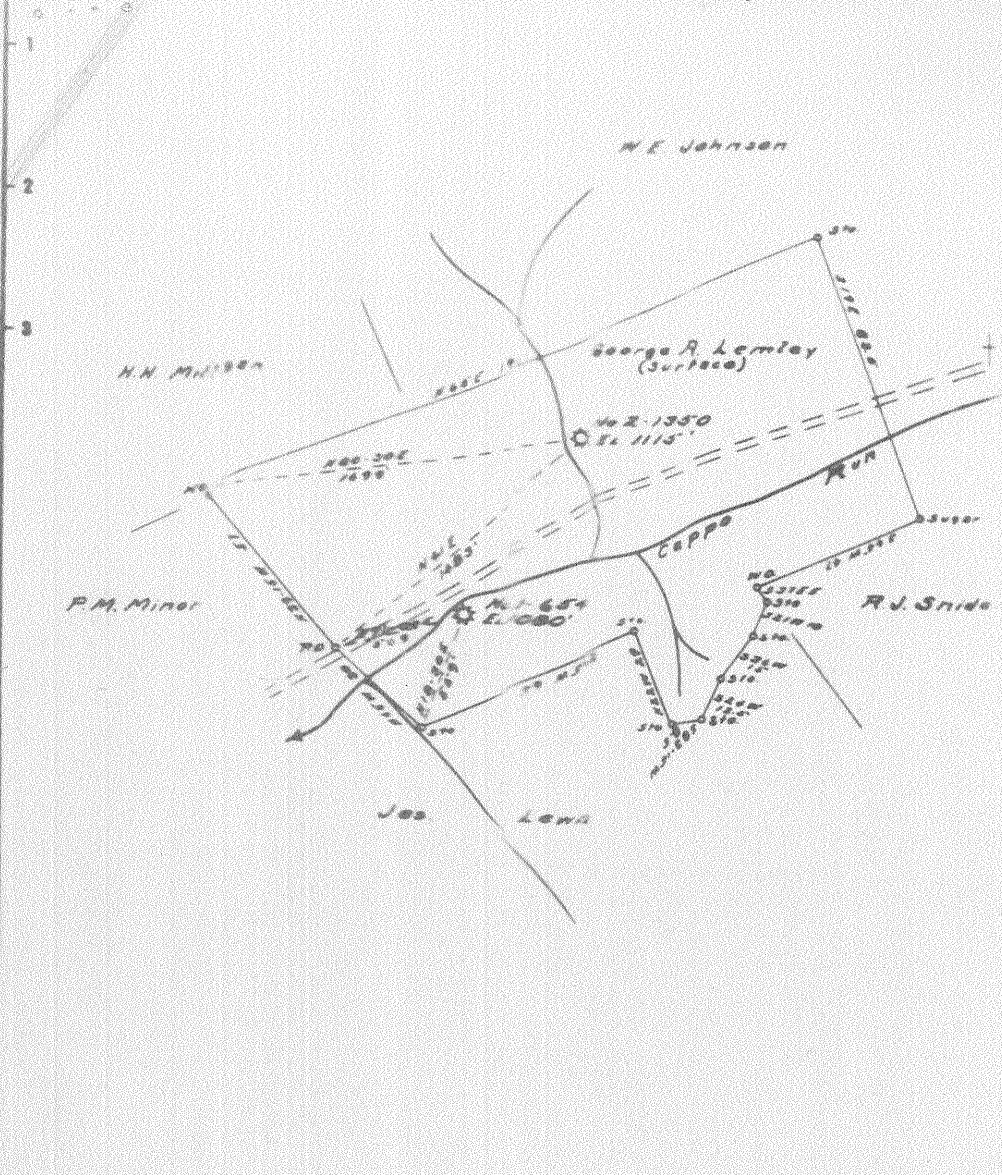

New Location   
 Drill Deeper   
 Abandonment

Company CARBIDE NATURAL GAS  
 Address PITTSBURGH, PA  
 Farm JONES HOSSTUTLER  
 Tract \_\_\_\_\_ Ac<sup>res</sup> 30 Lease No. 1987-77  
 Well (Farm) No. 2 Serial No. 1357  
 Elevation (Spirit Level) 1115

STATE OF WEST VIRGINIA  
 DEPARTMENT OF MINES  
 OIL AND GAS DIVISION  
 CHARLESTON

WELL LOCATION M  
 FILE NO. W-983





1413

STATE OF WEST VIRGINIA  
DEPARTMENT OF MINES  
OIL AND GAS DIVISION

WELL RECORD

Permit No. 983-A

WELL TO BE ABANDONED

Oil or Gas Well Gas  
(KIND)


Company Carnegie Natural Gas Company  
Address 1015 Friek Building, Pittsburgh 19, Pa.  
Farm John Hostutler Acres 85  
Location (waters) Cappo Run  
Well No. 2-1350 Elev. 1115 ft.  
District Church County Wetzel  
The surface of tract is owned in fee by George A. Lemley  
Address Hundred, W. Va.  
Mineral rights are owned by Vernon Snider, George A. & Lela N. Lemley  
Address Hundred, W. Va.  
Drilling commenced 9-16-26  
Drilling completed 11-14-26  
Date Shot 5-6-30 From 3021 ft. To 3025 ft.  
With 15 qts.

Casing and Tubing	Used in Drilling	Left in Well	Packers
Size			Kind of Packer
16			
13			
10	270	270	Size of
8 1/4	1205	1250	
6 5/8	2070	2070	Depth set
5 3/16			
3			Perf. top
2			Perf. bottom
Liners Used			Perf. top
			Perf. bottom

Open Flow /10ths Water in \_\_\_\_\_ Inch  
/10ths Merc. in \_\_\_\_\_ Inch  
Volume 525,000 Cu. Ft.  
Rock Pressure \_\_\_\_\_ lbs. \_\_\_\_\_ hrs.  
Oil \_\_\_\_\_ bbls., 1st 24 hrs.  
Fresh water \_\_\_\_\_ feet \_\_\_\_\_ feet  
Salt water \_\_\_\_\_ feet \_\_\_\_\_ feet

CASING CEMENTED \_\_\_\_\_ SIZE \_\_\_\_\_ No. Ft. \_\_\_\_\_ Date \_\_\_\_\_  
COAL WAS ENCOUNTERED AT 750 FEET \_\_\_\_\_ INCHES  
860 FEET \_\_\_\_\_ INCHES FEET \_\_\_\_\_ INCHES  
FEET \_\_\_\_\_ INCHES FEET \_\_\_\_\_ INCHES

Formation	Color	Hard or Soft	Top	Bottom	Oil, Gas or Water	Depth Found	Remarks
Mapleton Coal			750	756			
Pittsburgh Coal			860	866			
Little Dunkard			1250	1257			
Big Dunkard			1450	1470	Show of gas	1460	
1st Salt Sand			1595	1683			
2nd Salt Sand			1714	1726			
3rd Salt Sand			1769	1880			
Maxon Sand			1987	2043			
Big Line			2043	2092			
Big Injun			2092	2356			
Gordon Stray			2895	2921	Gas	2916-2920	
Gordon Sand			2933		Gas	2936-2937	
			Total	2947			

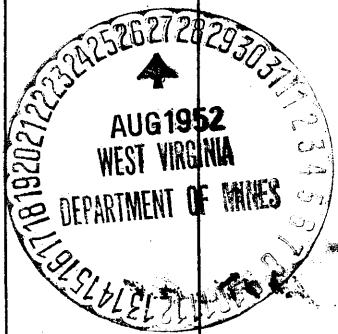

Formation	Color	Hard or Soft	Top	Bottom	Oil, Gas or Water	Depth Found	Remarks

Date August 25, 1952

APPROVED Carnegie Natural Gas Company, Owner

By B. H. Tucker  
(Title) Land Agent