

WW-7
8-30-06



West Virginia Department of Environmental Protection
Office of Oil and Gas
WELL LOCATION FORM: GPS

API: 47-103-00812 WELL NO.: WV 651731 (Ney Heirs #598)

FARM NAME: Wilson Ney Heirs

RESPONSIBLE PARTY NAME: EQT Production Company

COUNTY: Wetzel DISTRICT: Grant

QUADRANGLE: Big Run 7.5'

SURFACE OWNER: Larry and Mary Shimp

ROYALTY OWNER: Tara D. Reid, et al.

UTM GPS NORTHING: 4378157

UTM GPS EASTING: 541857 GPS ELEVATION: 410 m (1346 ft)

RECEIVED
Office of Oil and Gas

MAY 22 2020

WV Department of
Environmental Protection

The Responsible Party named above has chosen to submit GPS coordinates in lieu of preparing a new well location plat for a plugging permit or assigned API number on the above well. The Office of Oil and Gas will not accept GPS coordinates that do not meet the following requirements:

- Datum: NAD 1983, Zone: 17 North, Coordinate Units: meters, Altitude: height above mean sea level (MSL) – meters.
- Accuracy to Datum – 3.05 meters
- Data Collection Method:

Survey grade GPS _____ : Post Processed Differential _____
 Real-Time Differential _____
 Mapping Grade GPS X : Post Processed Differential X
 Real-Time Differential _____

- Letter size copy of the topography map showing the well location.**

I the undersigned, hereby certify this data is correct to the best of my knowledge and belief and shows all the information required by law and the regulations issued and prescribed by the Office of Oil and Gas.

[Signature]
Signature


PS # 2180
Title

5/14/2020
Date

Topo Quad: Big Run 7.5' Scale: 1" = 2000'
 County: Wetzel Date: May 08, 2020
 District: Grant Project No: 40-34-00-09

47-103-00812 WV 651731 (Ney Heirs #598)

Topo

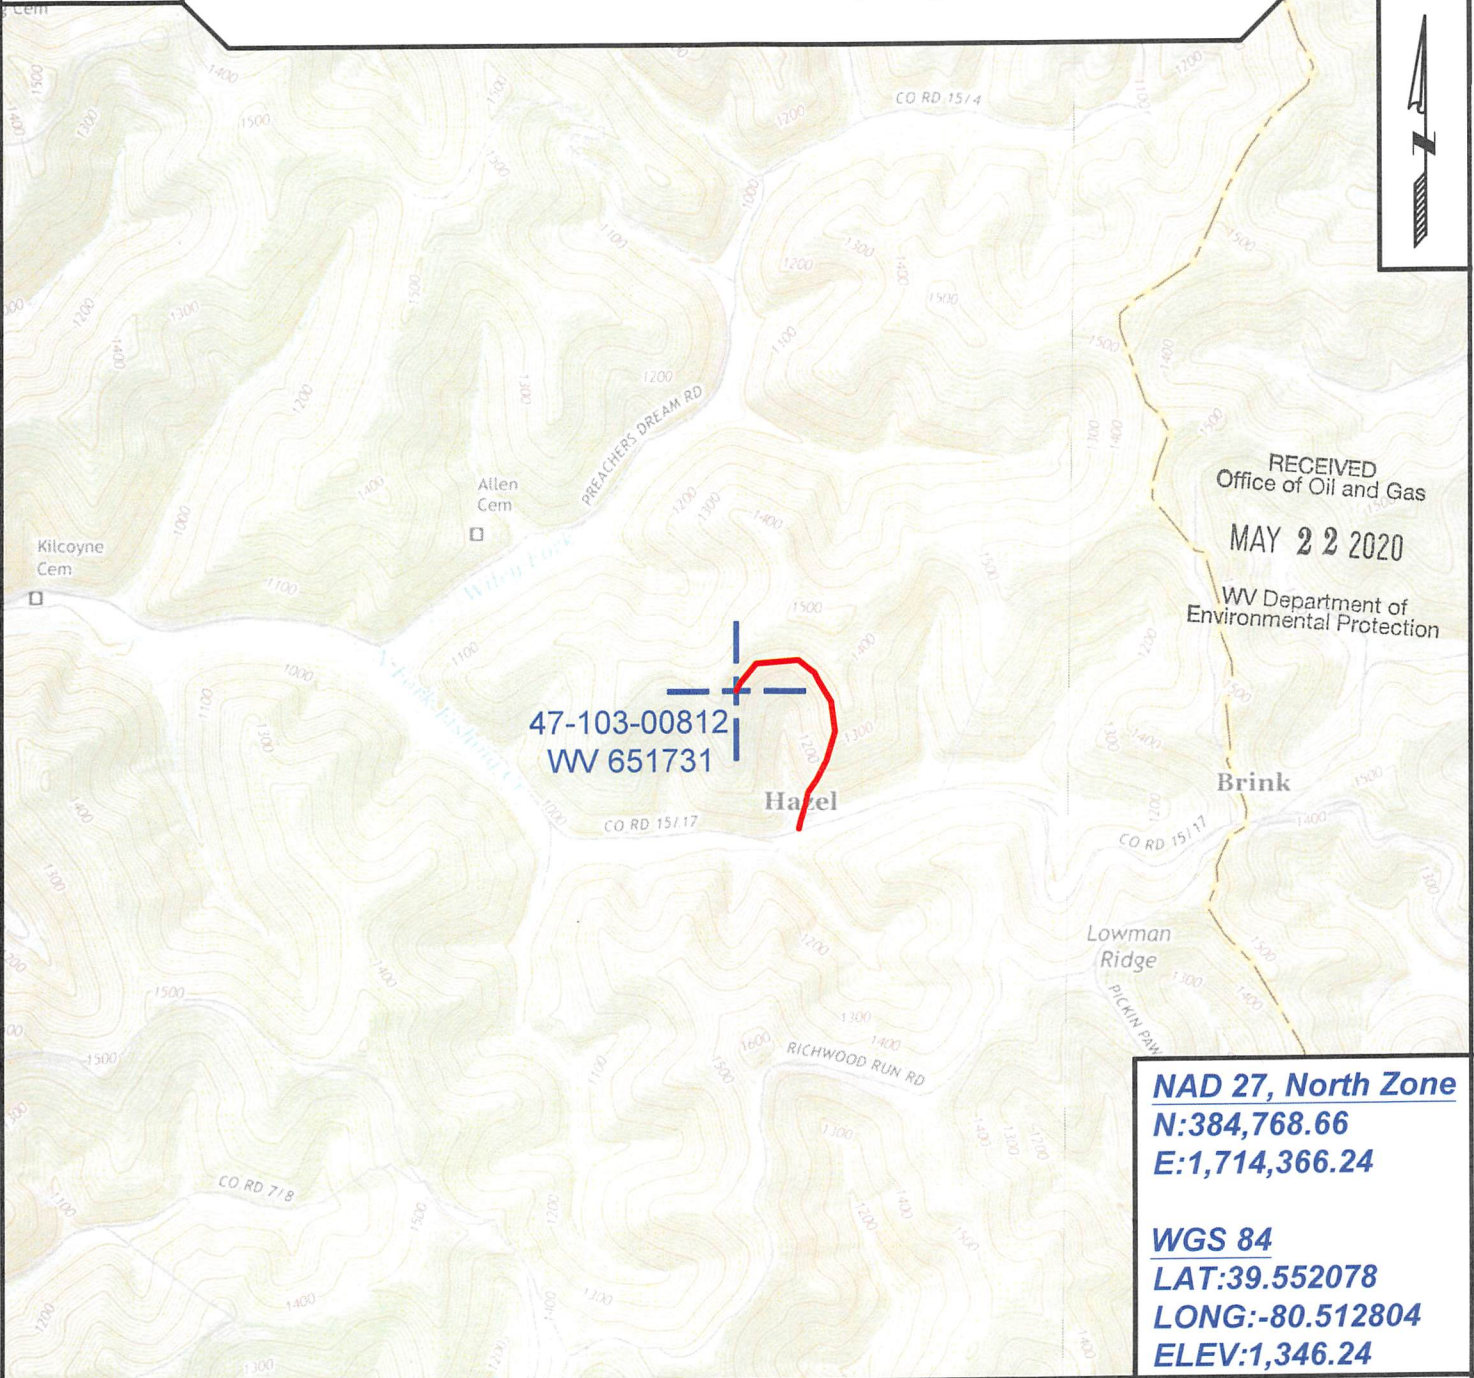

RECEIVED
 Office of Oil and Gas
 MAY 22 2020
 WV Department of
 Environmental Protection

47-103-00812
 WV 651731

NAD 27, North Zone
N:384,768.66
E:1,714,366.24

WGS 84
LAT:39.552078
LONG:-80.512804
ELEV:1,346.24



SURVEYING AND MAPPING SERVICES PERFORMED BY:
ALLEGHENY SURVEYS, INC.
 1-800-482-8606
 237 Birch River Road
 Birch River, WV 26610
 PH: (304) 649-8606
 FAX: (304) 649-8608

PREPARED FOR:
EQT Production Company
 400 Woodcliff Drive
 Canonsburg, PA 15317
DMH 5/19/20