

WW-7  
8-30-06



West Virginia Department of Environmental Protection  
Office of Oil and Gas  
**WELL LOCATION FORM: GPS**

API: 47-103-00829 WELL NO.: WV 601624 (Michael Barr #1624)

FARM NAME: Michael Barr

RESPONSIBLE PARTY NAME: EQT Production Company

COUNTY: Wetzel DISTRICT: Grant

QUADRANGLE: Big Run 7.5'

SURFACE OWNER: Laslie Lydick & Susan Miracle

ROYALTY OWNER: Roger K. Hinerman

UTM GPS NORTHING: 4381240

UTM GPS EASTING: 535164 GPS ELEVATION: 241 m (792 ft)

The Responsible Party named above has chosen to submit GPS coordinates in lieu of preparing a new well location plat for a plugging permit or assigned API number on the above well. The Office of Oil and Gas will not accept GPS coordinates that do not meet the following requirements:

1. Datum: NAD 1983, Zone: 17 North, Coordinate Units: meters, Altitude: height above mean sea level (MSL) – meters.
2. Accuracy to Datum – 3.05 meters
3. Data Collection Method:

Survey grade GPS \_\_\_\_\_ : Post Processed Differential \_\_\_\_\_  
 Real-Time Differential \_\_\_\_\_  
 Mapping Grade GPS X : Post Processed Differential X  
 Real-Time Differential \_\_\_\_\_

4. Letter size copy of the topography map showing the well location.

I the undersigned, hereby certify this data is correct to the best of my knowledge and belief and shows all the information required by law and the regulations issued and prescribed by the Office of Oil and Gas.

Signature

PS # 2100  
Title

8/23/18  
Date

RECEIVED  
Office of Oil and Gas  
OCT 17 2018  
WV Department of  
Environmental Protection

Topo Quad: Big Run 7.5'

Scale: 1" = 2000'

County: Wetzel


Date: August 23, 2008

District: Grant

Project No: 40-34-00-09

# 47-103-00829 WV 601624 (Michael Barr #1624)

Topo

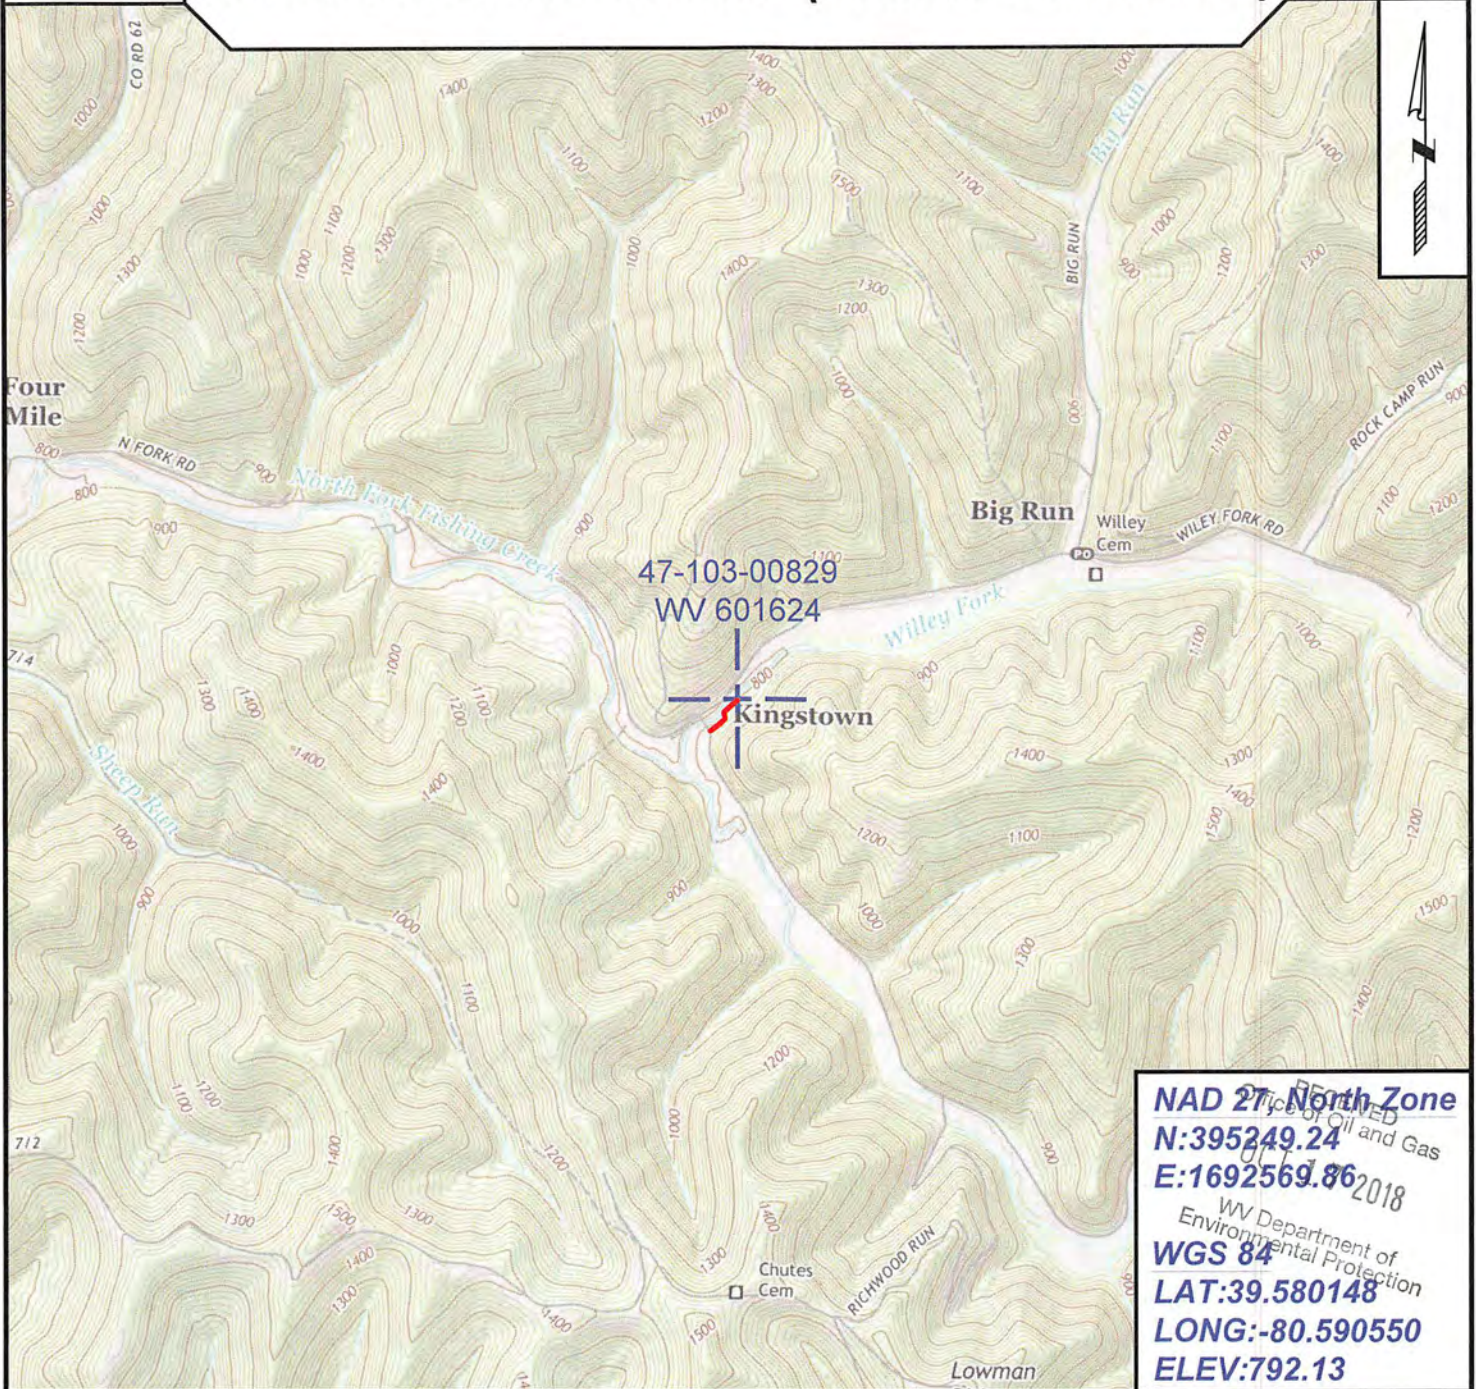

NAD 27, North Zone  
 N: 395249.24  
 E: 1692569.86  
 WGS 84  
 LAT: 39.580148  
 LONG: -80.590550  
 ELEV: 792.13



SURVEYING AND MAPPING SERVICES PERFORMED BY:

## ALLEGHENY SURVEYS, INC.

1-800-482-8606  
 237 Birch River Road  
 Birch River, WV 26610  
 PH: (304) 649-8606  
 FAX: (304) 649-8608

PREPARED FOR:

## EQT Production Company

2400 Ansys Drive  
 Canonsburg, PA 15317