


390301

500351

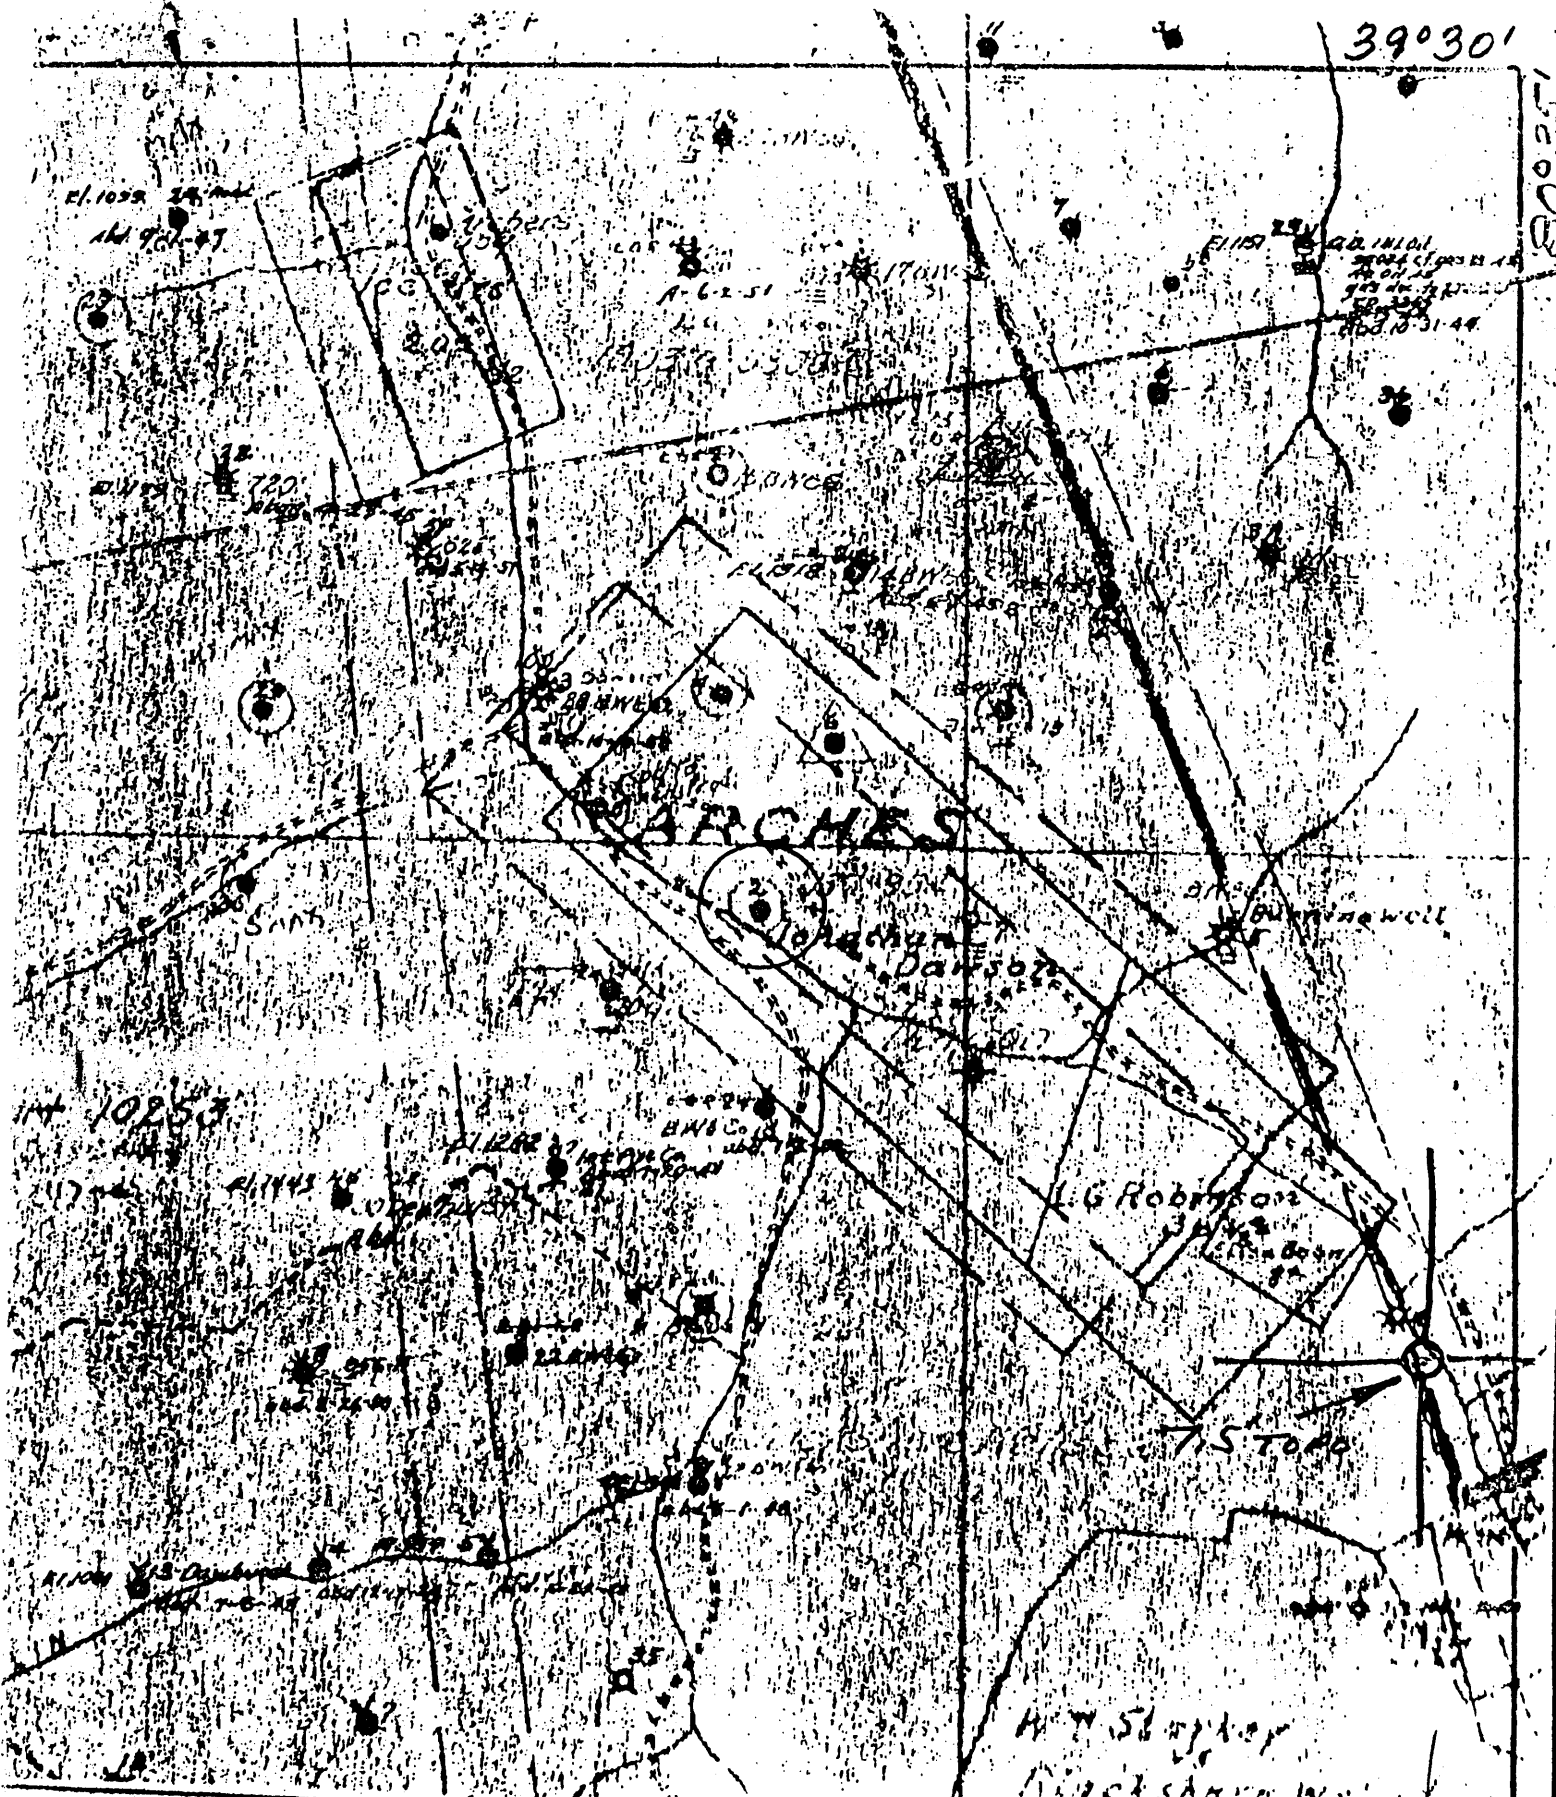

(+) DENOTES LOCATION OF WELL ON UNITED STATES TOPOGRAPHIC MAPS

FORM IV-6  
(8-78)  
NABNIEZ



STATE OF WEST VIRGINIA  
DEPARTMENT OF MINES

DATE 1-4-1929  
OPERATOR'S WELL NO. 2  
API WELL NO. 47-103-0952  
STATE COUNTY PERMIT

OIL AND GAS DIVISION

WELL TYPE: OIL  GAS  LIQUID INJECTION  WASTE DISPOSAL   
(IF "GAS", PRODUCTION  STORAGE  DEEP  SHALLOW

LOCATION: ELEVATION \_\_\_\_\_ WATER SHED ARCHES FORK  
DISTRICT GRANT COUNTY WETZEL  
QUADRANGLE FOLSOM 7.51

SURFACE OWNER \_\_\_\_\_ ACREAGE \_\_\_\_\_  
OIL & GAS ROYALTY OWNER \_\_\_\_\_ LEASE NO. \_\_\_\_\_ LEASE ACREAGE \_\_\_\_\_

PROPOSED WORK: DRILL  CONVERT  DRILL DEEPER  REDRILL  FRACTURE OR STIMULATE  PLUS OFF OLD FORMATION  PERFORATE NEW FORMATION  OTHER PHYSICAL CHANGE IN WELL (SPECIFY) \_\_\_\_\_

PLUG AND ABANDON  CLEAN OUT AND REPLUG

TARGET FORMATION \_\_\_\_\_ ESTIMATED DEPTH \_\_\_\_\_

WELL OPERATOR Pennzoil Company DESIGNATED AGENT James A. Crew  
ADDRESS P. O. Box 1588 ADDRESS P. O. Box 1588  
Parkersburg, WV 26101 Parkersburg, WV 26101



# SOUTH PENN OIL COMPANY—COMPLETION

No. 1  
 SERIAL NO. \_\_\_\_\_ FARM DAWSON CASSA WELL NO. 2  
 ELEVATION \_\_\_\_\_ N. 2 S. \_\_\_\_\_ E. \_\_\_\_\_ W. 2  
 LEASE NO. 10137 ACRES 95 Map 2951  
 WATERS OF Arches Fork, So-Fork Fishing Creek  
 DISTRICT Grant COUNTY Wetzel STATE W. Va.  
 DRILLING COMMENCED ? COMPLETED 10/7/94 DEPTH 2097

PGH. COAL OR BIG LIME	SANDS		ELEV. TOP	CASING
	TOP	BOTTOM		
Pgh Coal	620		10	220
Big Injun Sand	1071		8 $\frac{1}{2}$	1127
1st Pay	2036		6 $\frac{1}{2}$	1971
2nd "	2050			

PACKERS AND DEPTH SET  
 INITIAL PROD. 100 Bbls. SAND Big Inj DEPTH 2036 & 2050  
 GAS TEST \_\_\_\_\_  
 SHOT 6/7/1898 QUARTS 10 " Big Injun 2044  
 REMARKS \_\_\_\_\_

REPORTED BY WETZEL DISTRICT ABANDONED \_\_\_\_\_

/03-952