

West Virginia Department of Environmental Protection
Office of Oil & Gas

WELL LOCATION FORM: GPS

API: 47- 103 - 0972 WELL NO: No.2

FARM NAME: Alfred Efaw

RESPONSIBLE PARTY NAME: HG Energy, LLC

COUNTY: Wetzel DISTRICT: Center 1

QUADRANGLE: Littleton 7.5' 438

SURFACE OWNER: Steven & James Barbe

ROYALTY OWNER: HG Energy LLC et al.

UTM GPS NORTHING: 4,388,847

UTM GPS EASTING: 537,684 GPS ELEVATION: 384 m. 1260 Ft

The Responsible Party named above has chosen to submit GPS coordinates in lieu of preparing a new well location plat for a plugging permit on the above well. The Office of Oil & Gas will not accept GPS coordinates that do not meet the following requirements:

1. Datum: NAD 1983, Zone:17 North, Coordinate Units: meters, Altitude: height above mean sea level (MSL) - meters.
2. Accuracy to Datum - 3.05 meters
3. Data Collection Method:

Survey Grade GPS Post Processed Differential
 Real-Time Differential

Mapping Grade GPS Post Processed Differential
 Real-Time Differential

I the undersigned, hereby certify this data is correct to the best of my knowledge and belief and shows all the information required by law and the regulations issued and prescribed by the Office of Oil and Gas.


Diane White Diane White
Signature

September 4, 2014
Date

Designated Agent
Title

Received
Office of Oil & Gas
OCT 06 2014

SUBJECT WELL
Alfred Efaw No.2
47-103-0972

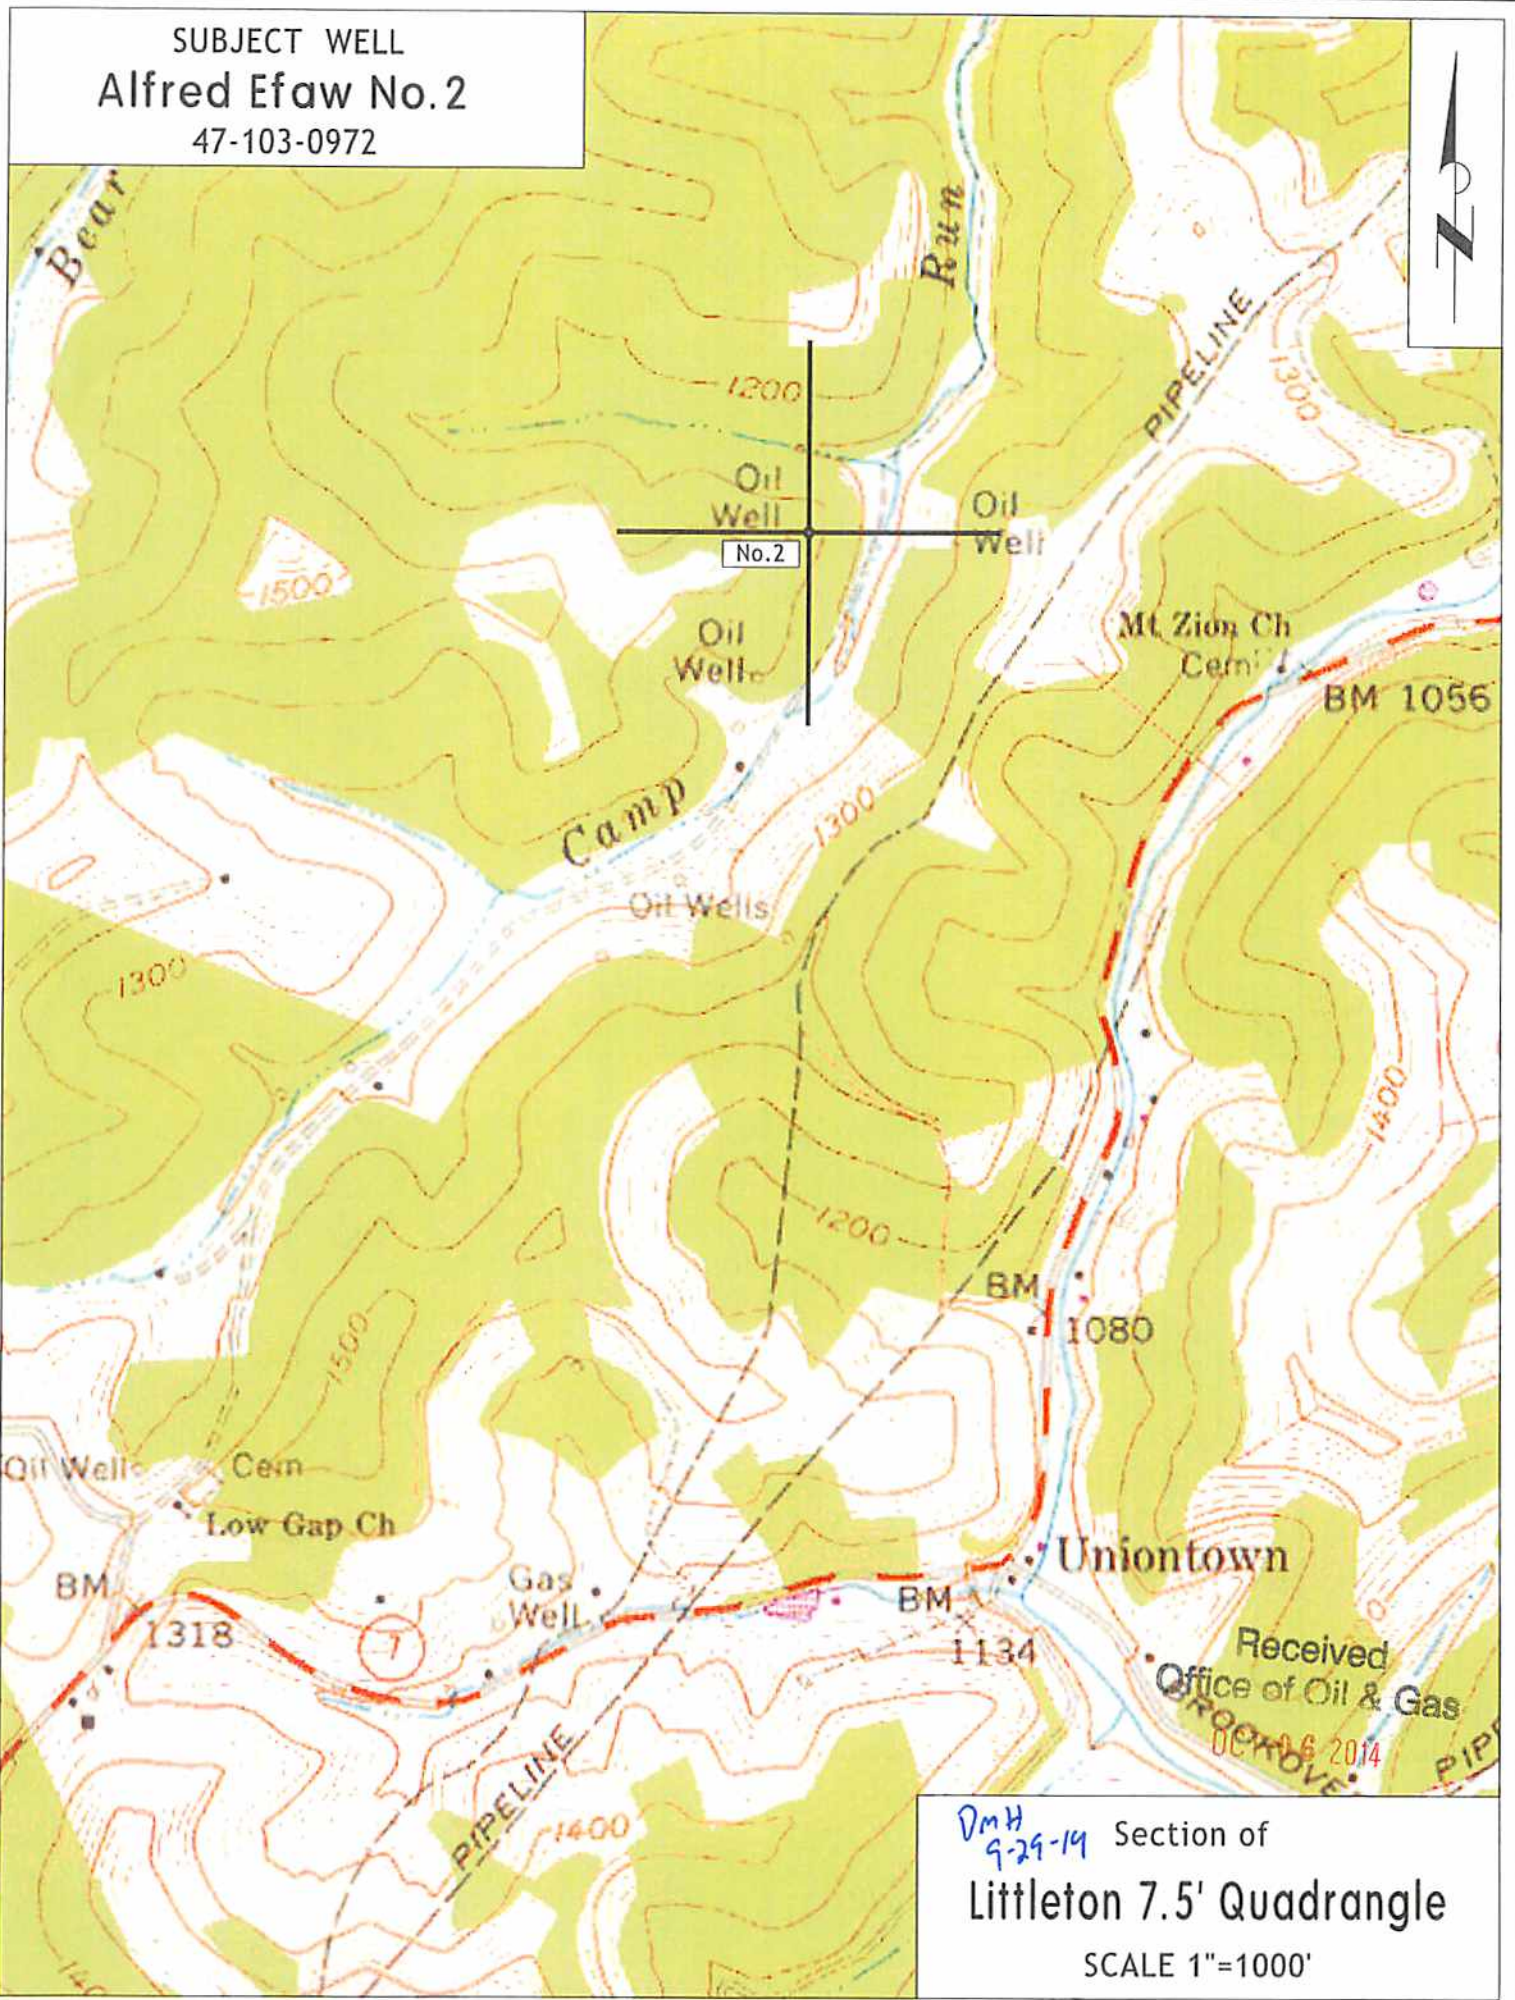

DMH
9-29-19 Section of
Littleton 7.5' Quadrangle
SCALE 1"=1000'

Received
Office of Oil & Gas
OCT 06 2014