




SUBJECT WELL  
Charles Gilbert No. 3  
47-103-0980

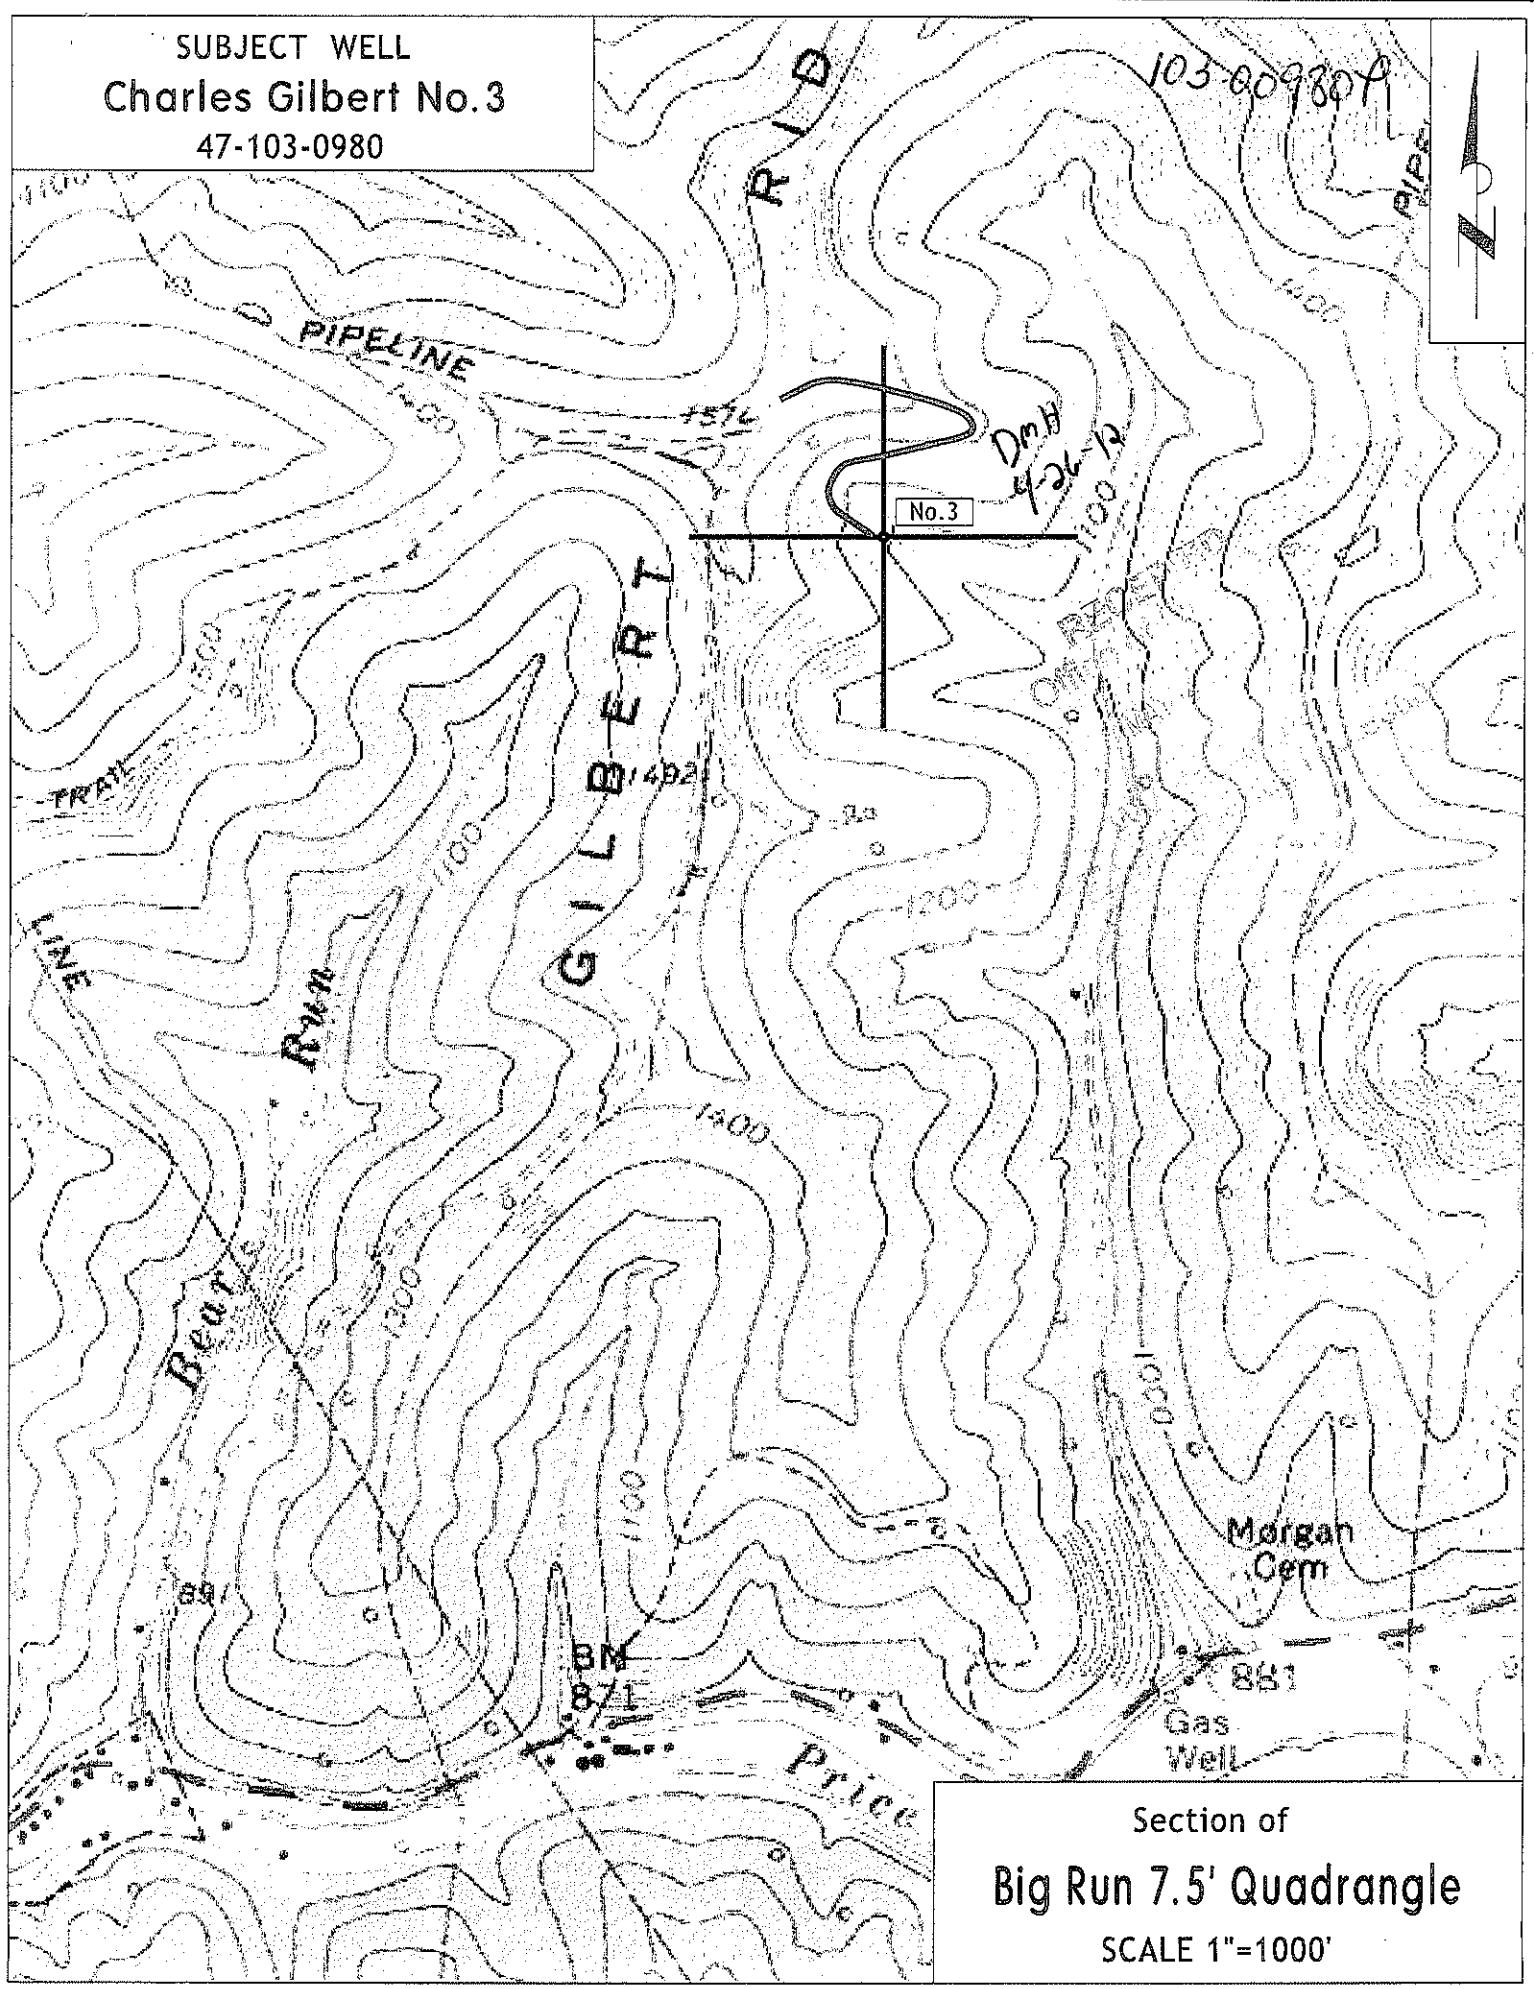

Section of  
Big Run 7.5' Quadrangle  
SCALE 1"=1000'