



*Jamie*  
7/16/91

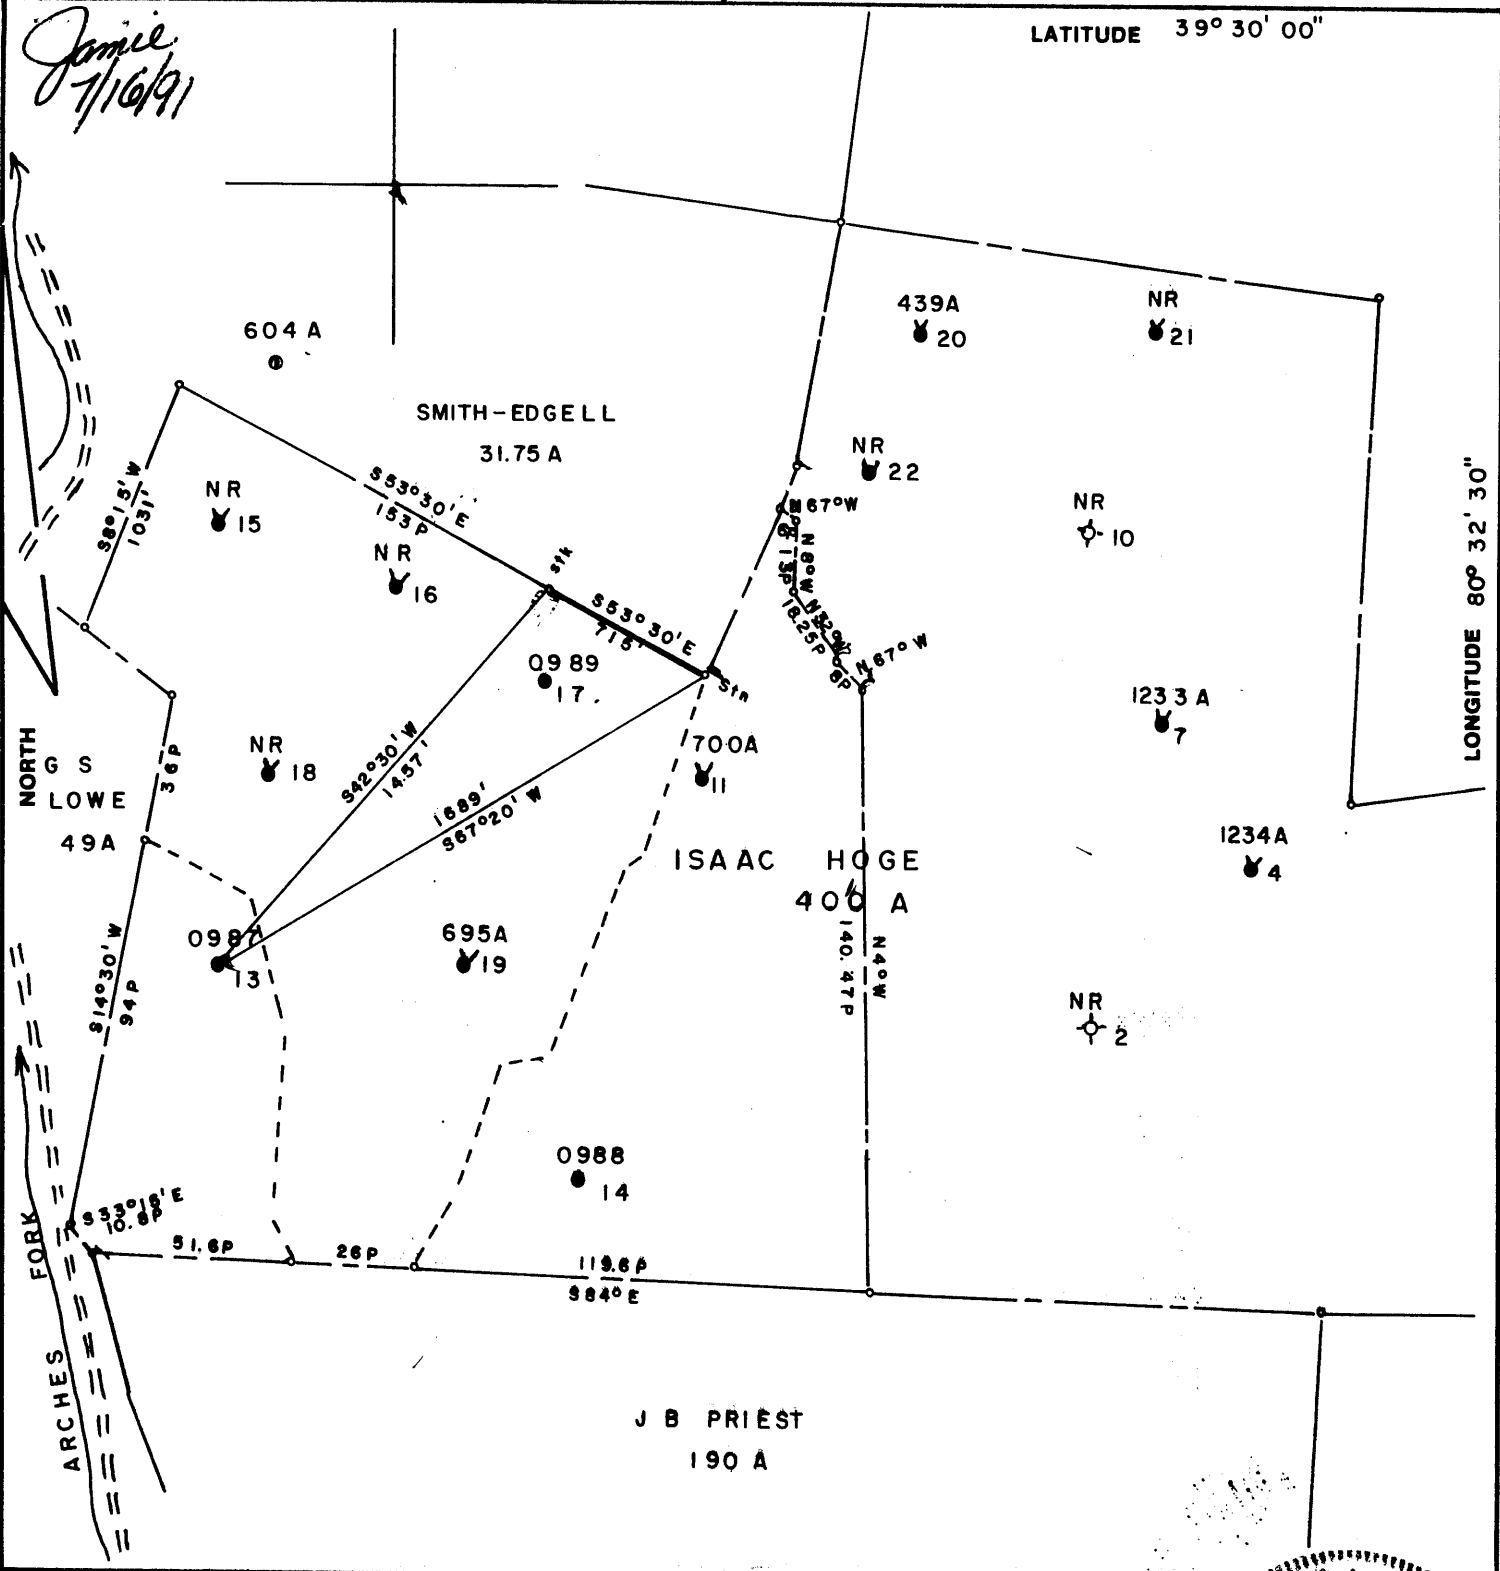

FILE NO. \_\_\_\_\_  
 MAP N58 SQS N4E3  
 SCALE 1" = 800'  
 MINIMUM DEGREE OF ACCURACY 1/200  
 PROVEN SOURCE OF ELEVATION PENNZOIL CO.  
 RECORDS

I, THE UNDERSIGNED, HEREBY CERTIFY THAT THIS PLAT IS CORRECT TO THE BEST OF MY KNOWLEDGE AND BELIEF AND SHOWS ALL THE INFORMATION REQUIRED BY LAW AND THE REGULATIONS ISSUED AND PRESCRIBED BY THE DEPARTMENT OF MINES.  
 (SIGNED) Curtis A. Lucas  
 CURTIS A. LUCAS LLS 275

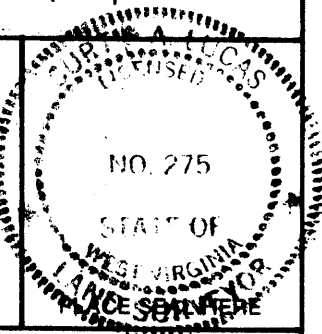

**STATE OF WEST VIRGINIA**  
 DEPARTMENT OF MINES  
 OIL AND GAS DIVISION



DATE JUNE 29, 19 91  
 FARM ISAAC HOGE NO. 13  
 API WELL NO.

47 - 103 - 0987-P  
 STATE COUNTY PERMIT

(+) DENOTES LOCATION OF WELL ON UNITED STATES TOPOGRAPHIC MAPS  
 WELL TYPE: OIL  GAS  LIQUID INJECTION  WASTE DISPOSAL   
 (IF "GAS,") PRODUCTION  STORAGE  DEEP  SHALLOW   
 LOCATION: ELEVATION 874 WATER SHED ARCHES FORK  
 DISTRICT GRANT COUNTY WETZEL  
 QUADRANGLE FOLSOM

SURFACE OWNER CLIFFORD LOWE ACREAGE 33.12  
 OIL & GAS ROYALTY OWNER TRIO PETROLEUM CORP LEASE ACREAGE 4.00  
 LEASE NO. \_\_\_\_\_

PROPOSED WORK: DRILL  CONVERT  DRILL DEEPER  REDRILL  FRACTURE OR STIMULATE  PLUG OFF OLD FORMATION  PERFORATE NEW FORMATION  OTHER PHYSICAL CHANGE IN WELL (SPECIFY) \_\_\_\_\_

PLUG AND ABANDON  CLEAN OUT AND REPLUG   
 TARGET FORMATION BIG INJUN ESTIMATED DEPTH 2253  
 WELL OPERATOR PERKINS OIL & GAS INC DESIGNATED AGENT DERYL L. PERKINS  
 ADDRESS P O BOX 547 ADDRESS P O BOX 547  
PENNSBORO WV 26415 PENNSBORO WV 26415

STATE OF WEST VIRGINIA  
DEPARTMENT OF ENERGY  
DIVISION OF OIL AND GAS

RECEIVED  
Office of Oil & Gas  
OCT 07 92  
WV Division of  
Environmental Protection

AFFIDAVIT OF PLUGGING AND FILLING WELL

AFFIDAVIT SHOULD BE IN TRIPLICATE, one copy mailed to the Environmental Protection Agency (one copy to be retained by the Well Operator and the third copy (and extra copies if required) should be mailed to each coal operator at their respective addresses.

Farm name: LOVE, CLIFFORD Operator Well No.: ISAAC HOGE 13

LOCATION: Elevation: 874.00 Quadrangle: FOLSOM  
District: GRANT County: WETZEL  
Latitude: 1900 Feet South of 39 Deg. 30 Min. 0 Sec.  
Longitude 11425 Feet West of 80 Deg. 32 Min. 30 Sec.

Well Type: OIL X GAS \_\_\_\_\_

Company: PERKINS OIL & GAS INC  
P O BOX 547  
PENNSBORO, WV 26415

Coal Operator CONSOLIDATION COAL CO  
or Owner P O BOX 1314  
MORGANTOWN WV 26507

Agent: DERYL L PERKINS  
Inspector: RANDALL MICK  
Permit Issued: 07/18/91

Coal Operator \_\_\_\_\_  
or Owner \_\_\_\_\_

AFFIDAVIT

STATE OF WEST VIRGINIA,  
County of RITCHIE ss:

MIKE LAMP and LYLE FARLEY being first duly sworn according to law depose and say that they are experienced in the work of plugging and filling oil and gas wells and were employed by PERKINS OIL & GAS INC, well operator, and participated in the work of plugging and filling the above well, that said work was commenced on the 17th day of July, 1992, and that the well was plugged and filled in the following manner:

TYPE	FROM	TO	PIPE REMOVED	LEFT
Gel	2782	2730	5 3/16 2018	85
Cement	2730	1895	6 5/8 657	1253
Gel	1895	700		
Cement	700	600		
Gel	600	340		
Cement	340	230		
Gel	230	100		
Cement	100	surface		

Description of monument: 1 joint 6 5/8" casing extending 80" above surface

and that the work of plugging and filling said well was completed on the 23 day of July, 1992.

And further deponents saith not.

Mike Lamp  
Lyle R. Farley  
OCT 30 1992

Sworn and subscribe before me this 24th day of Sept., 1992  
My commission expires: Apr. 13, 1994

Deryl L. Perkins  
Notary Public

Randall Mick Notary Public