


39037'30"



(+) DENOTES LOCATION OF WELL ON UNITED STATES TOPOGRAPHIC MAPS

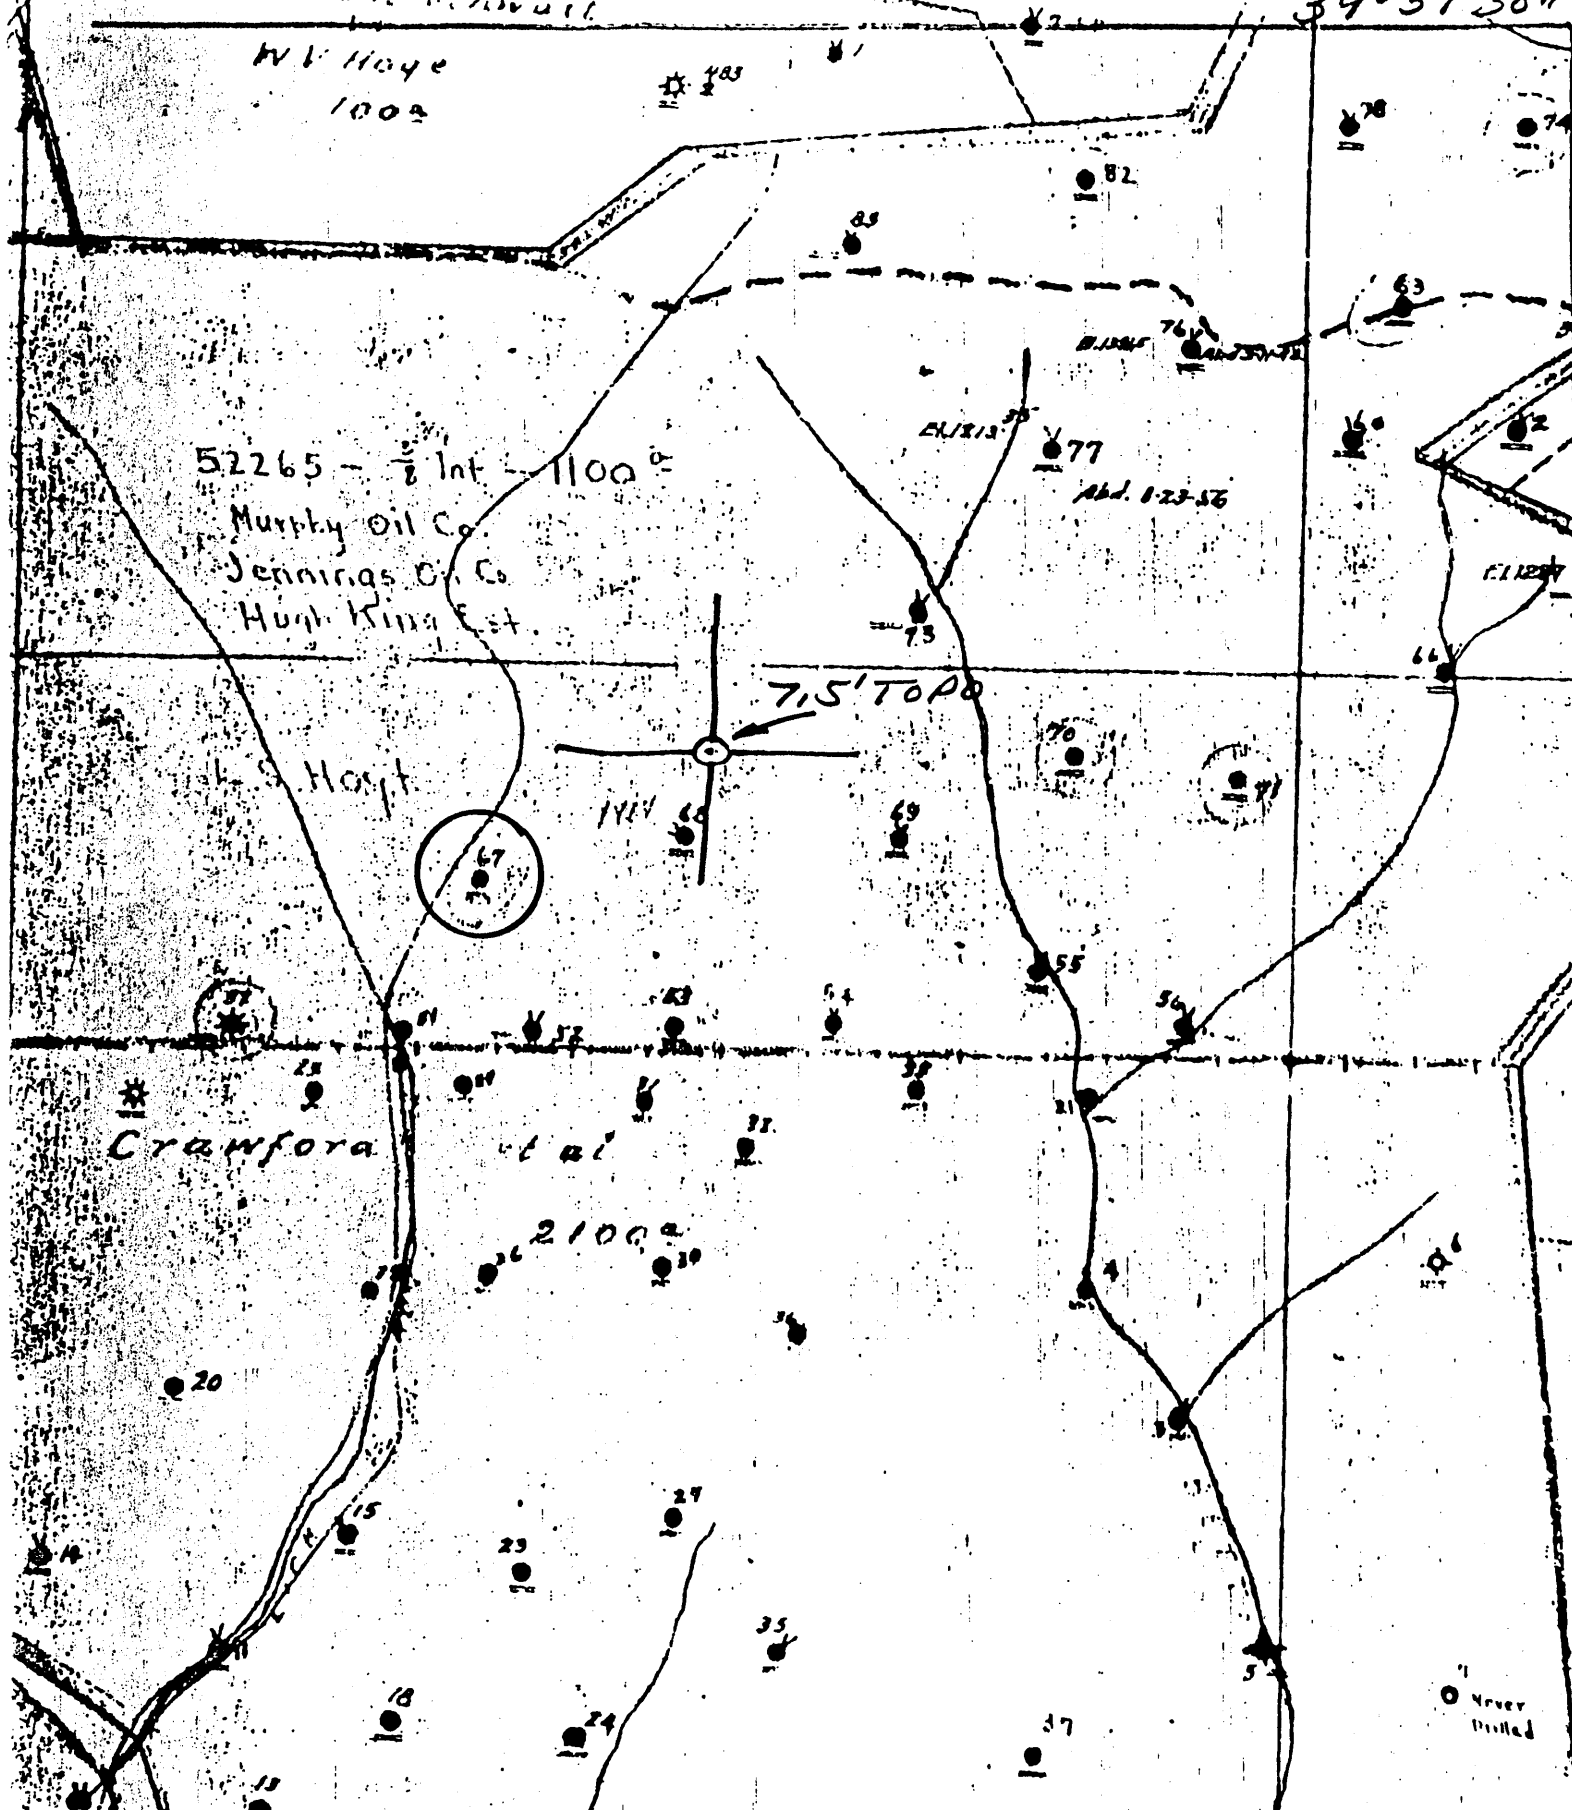

DATE 1-5- 19 79  
 OPERATOR'S WELL NO 67  
 API WELL NO. 47-103-0994  
 STATE COUNTY PERMIT

FORM IV-6  
 (8-78)  
 N68 N11 W2

STATE OF WEST VIRGINIA  
 DEPARTMENT OF MINES  
 OIL AND GAS DIVISION

WELL TYPE: OIL  GAS  LIQUID INJECTION  WASTE DISPOSAL   
 ( IF "GAS", PRODUCTION  STORAGE  DEEP  SHALLOW   
 LOCATION: ELEVATION 1296.01 WATER SHED NORTH FK, FISHING CK  
 DISTRICT GRANT COUNTY NETZEL  
 QUADRANGLE PINE GRAVE 7.5'

SURFACE OWNER \_\_\_\_\_ ACREAGE \_\_\_\_\_  
 OIL & GAS ROYALTY OWNER \_\_\_\_\_ LEASE ACRES \_\_\_\_\_  
 LEASE NO. \_\_\_\_\_

PROPOSED WORK: DRILL  CONVERT  DRILL DEEPER  REDRILL  FRACTURE OR STIMULATE  PLUS OFF OLD FORMATION  PERFORATE NEW FORMATION  OTHER PHYSICAL CHANGE IN WELL (SPECIFY) \_\_\_\_\_

PLUS AND ABANDON  CLEAN OUT AND REPLUS   
 TARGET FORMATION \_\_\_\_\_ ESTIMATED DEPTH \_\_\_\_\_  
 WELL OPERATOR Pennzoil Company DESIGNATED AGENT James A. Crews  
 ADDRESS P. O. Box 1588 ADDRESS P. O. Box 1588  
Parkersburg, WV 26101 Parkersburg, WV 26101



**SOUTH PENN OIL COMPANY—COMPLETION**

SERIAL NO. \_\_\_\_\_ FARM L.S. Hoyt, P.I. WELL NO. 67  
 ELEVATION 1296.07 N. 11 ACRES. 2100  
 LEASE NO. \_\_\_\_\_ WATER OF North Fork of Fishing Creek  
 DISTRICT Grant COUNTY. Wetzel STATE W. Va.  
 DRILLING COMMENCED 8/1/02 COMPLETED 10/8/06 DEPTH 2059

SANDS	TOP	BOTTOM	ELEV. TOP	CASING
PGH. COAL <del>5187</del>	1170			
Big Injun	2294	2574		10" 670
Gordon Stray	3157	3175		8" 1810
Gordon	4187	3705		6" 2275

PACKERS AND DEPTH SET \_\_\_\_\_  
 INITIAL PROD. No Record SAND Gordon DEPTH 2059  
 GAS TEST No Record  
 SHOT 10/9/02 QUARTS 30 Qts, 10/24/06, 50 Qts.  
 REMARKS 7/9/10, 100 Qts, 7/22/14, 95 Qts.

REPORTED BY PINEY DISTRICT ABANDONED Not Abdn.  
P. O. 834-SM-10-21

47-103-0994