

WW-7
8-30-06



West Virginia Department of Environmental Protection
Office of Oil and Gas

WELL LOCATION FORM: GPS

API: 47-103-01072 WELL NO.: 7185

FARM NAME: B. W. PETERSON

RESPONSIBLE PARTY NAME: CONSOLIDATION COAL COMPANY

COUNTY: WETZEL DISTRICT: GRANT

QUADRANGLE: FOLSOM WV 7.5'

SURFACE OWNER: COASTAL FOREST RESOURCES COMPANY

ROYALTY OWNER: _____

UTM GPS NORTHING: 4,371,674 m (1456')

UTM GPS EASTING: 541,300 m GPS ELEVATION: 444 m

The Responsible Party named above has chosen to submit GPS coordinates in lieu of preparing a new well location plat for a plugging permit or assigned API number on the above well. The Office of Oil and Gas will not accept GPS coordinates that do not meet the following requirements:

1. Datum: NAD 1983, Zone: 17 North, Coordinate Units: meters, Altitude: height above mean sea level (MSL) – meters.
2. Accuracy to Datum – 3.05 meters
3. Data Collection Method:

Survey grade GPS _____ : Post Processed Differential _____

Real-Time Differential _____

Mapping Grade GPS X : Post Processed Differential X

Real-Time Differential _____

4. **Letter size copy of the topography map showing the well location.**

I the undersigned, hereby certify this data is correct to the best of my knowledge and belief and shows all the information required by law and the regulations issued and prescribed by the Office of Oil and Gas.

Signature

Professional Surveyor

Title

MARCH 14, 2019

Date

47-103-01072 P

FOLSOM QUADRANGLE
WEST VIRGINIA
7.5 MINUTE SERIES (TOPOGRAPHIC)
NE/4 CENTER POINT 15' QUADRANGLE

1863 11 SW
(GLOVER GAP)


39 32'30" 40 1 710 000 FEET 42 80° 30' 39° 30'



4372
4371
360 000
FEET
4370
4369
4368
27'30"

RECEIVED
Office of Oil and Gas
JUN 14 2019
WV Department of
Environmental Protection

Folsom; WV Scale: 1" = 0.379Mi 610Mt 2,000Ft, 1 Mi = 2.640" , 1 cm = 240Mt

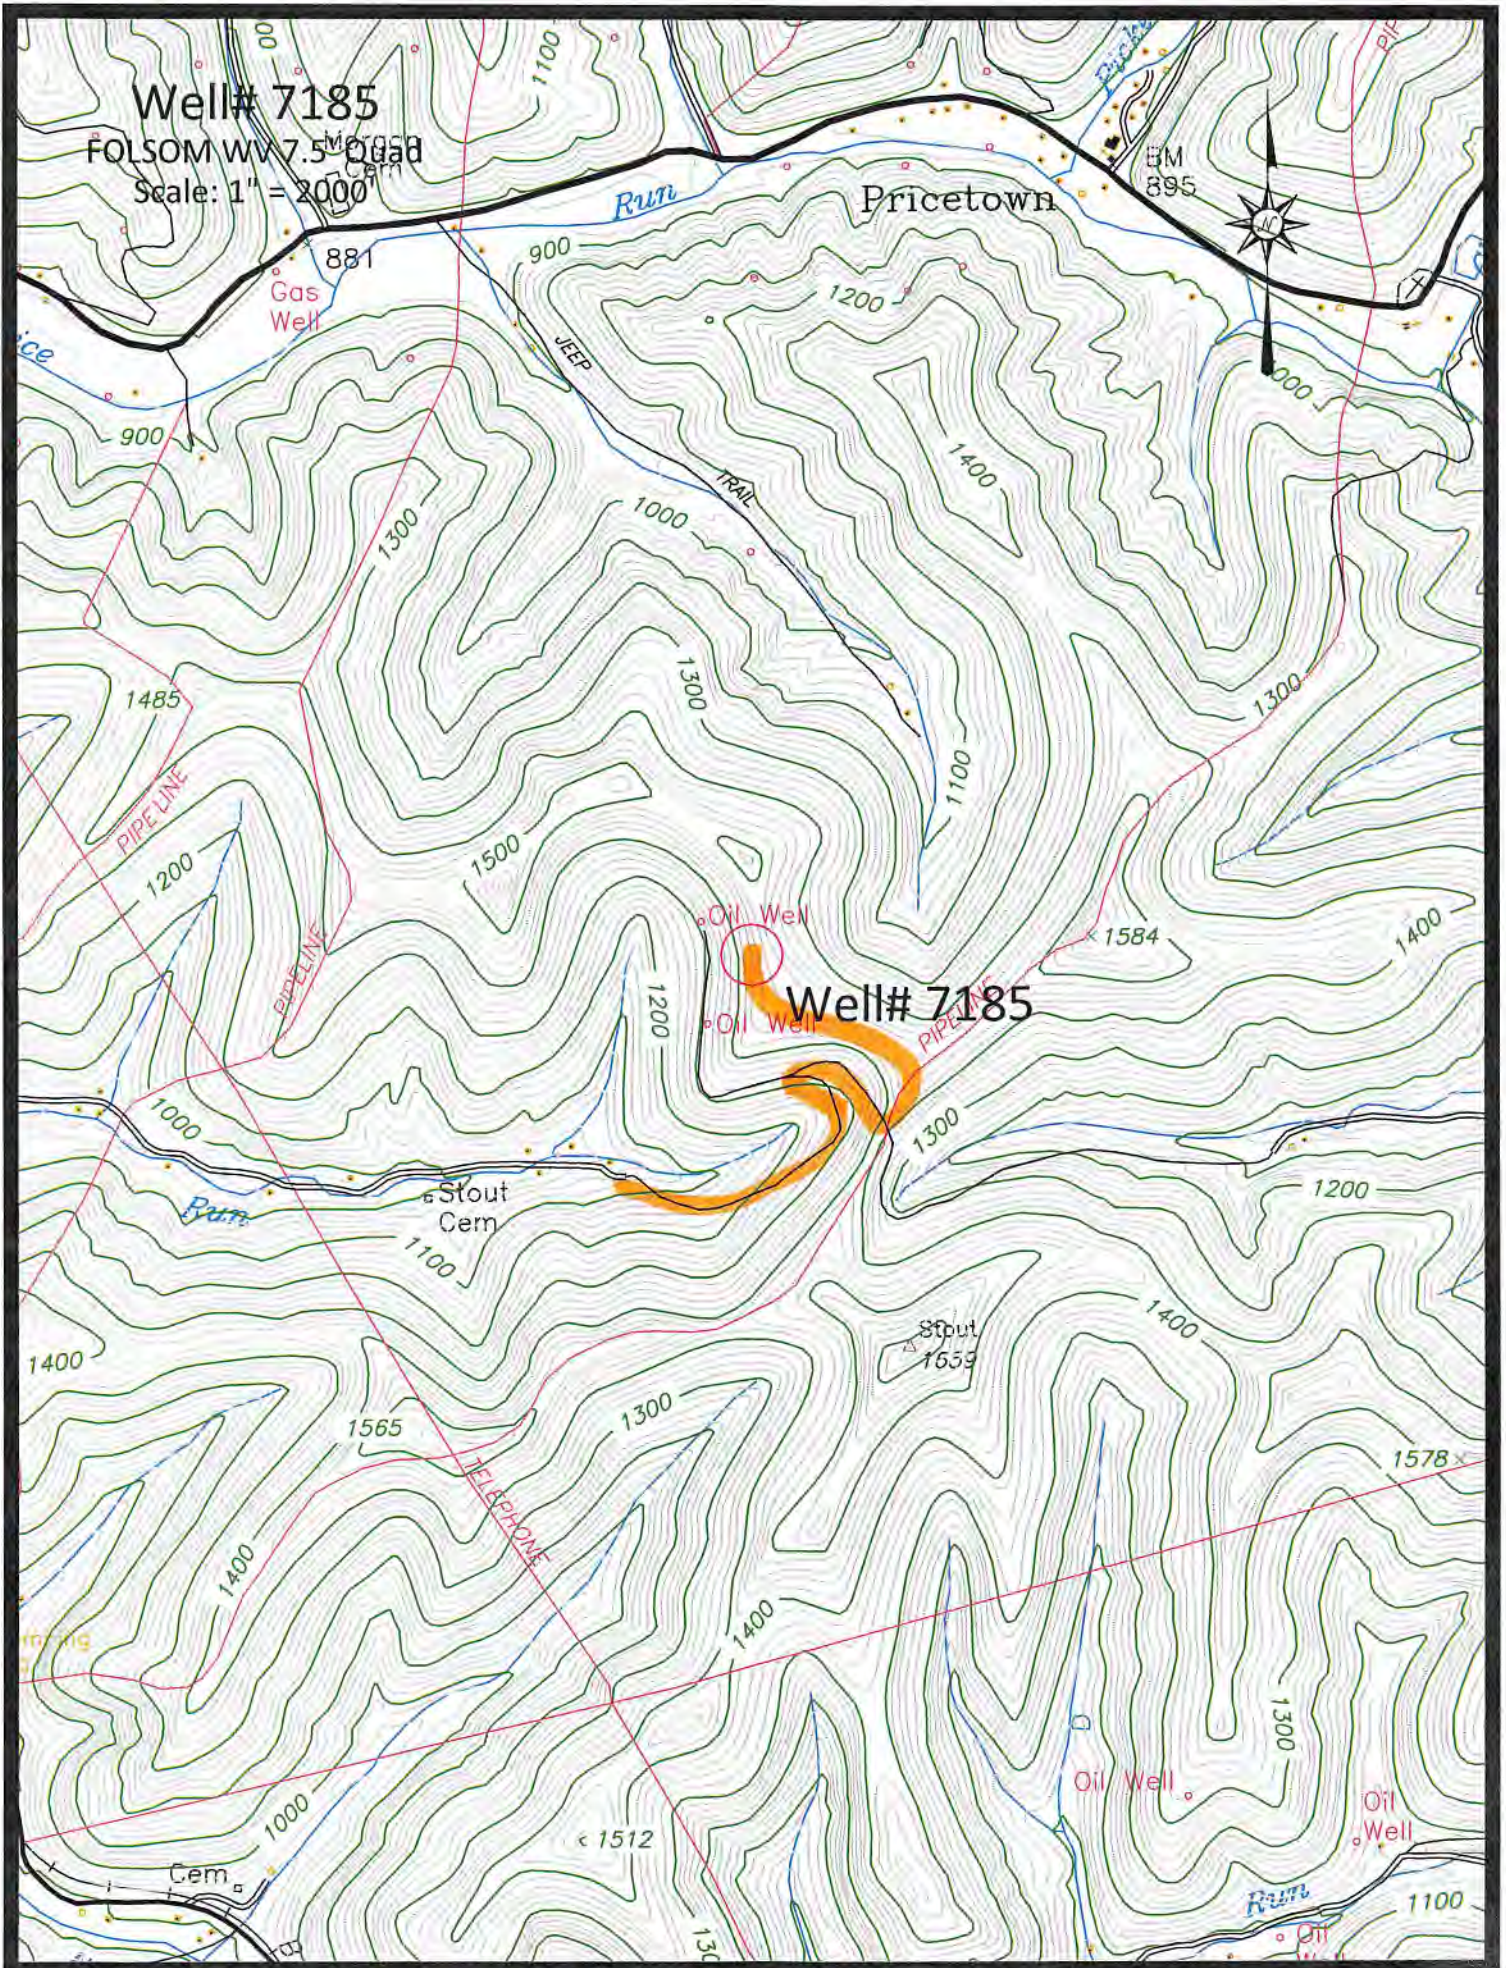

Well# 7185

FOLSOM WV 7.5' Quad

Scale: 1" = 2000'

Pricetown

Well# 7185

Access Road

Well# 7185

FOLSOM WV 7.5' Quad

Scale: 1" = 500'



1300

1100

1500

Oil Well



Well# 7185

Oil Well

1200

PIPELINE

1300

tout
em

Stout
1659

Access Road

