



39°30'

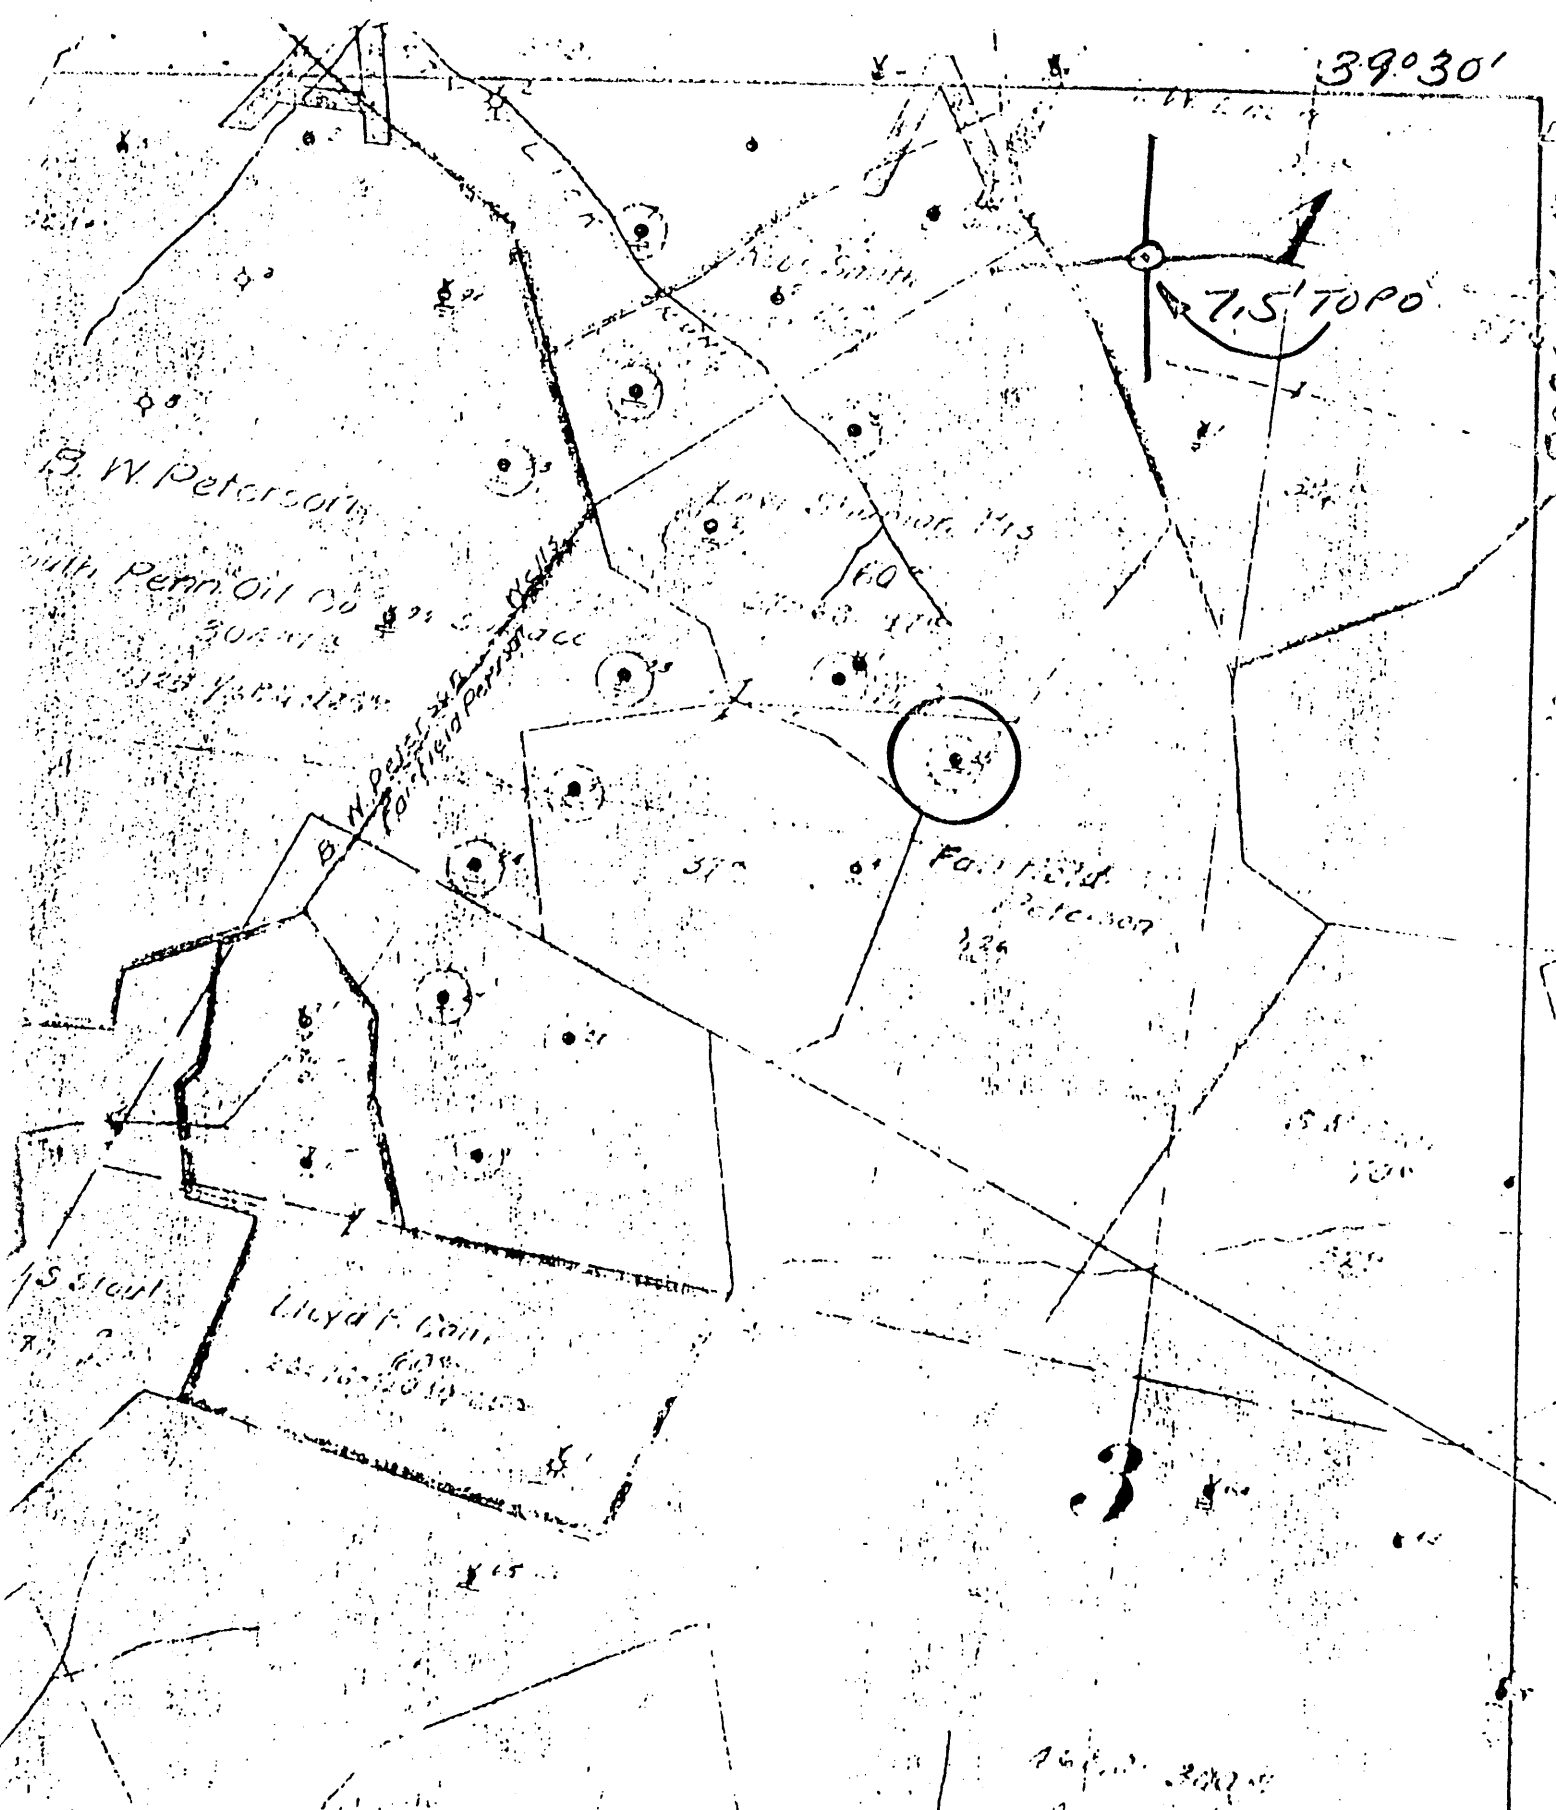

(X) DENOTES LOCATION OF WELL ON UNITED STATES TOPOGRAPHIC MAPS
 FORM IV-6
 3-78
 59 N 4 E 6



STATE OF WEST VIRGINIA
 DEPARTMENT OF MINES
 OIL AND GAS DIVISION

DATE 1-8-1979
 OPERATOR'S WELL NO. 25
 API WELL NO. 47-103-1073
 STATE COUNTY PERMIT

WELL TYPE: OIL GAS _____ LIQUID INJECTION _____ WASTE DISPOSAL _____
 (IF "GAS", PRODUCTION _____ STORAGE _____ DEEP _____ SHALLOW _____)


LOCATION: ELEVATION _____ WATER SHED KATY LICK PRICE RUN
 DISTRICT GRANT COUNTY WETZEL
 QUADRANGLE FOLSOM 7.5'

SURFACE OWNER _____ ACREAGE _____
 OIL & GAS ROYALTY OWNER _____ LEASE NO. _____ LEASE ACREAGE _____

PROPOSED WORK: DRILL _____ CONVERT _____ DRILL DEEPER _____ REDRILL _____ FRACTURE OR
 STIMULATE _____ PLUS OFF OLD FORMATION _____ PERFORATE NEW
 FORMATION _____ OTHER PHYSICAL CHANGE IN WELL (SPECIFY) _____

PLUS AND ABANDON _____ CLEAN OUT AND REPLUS _____
 TARGET FORMATION _____ ESTIMATED DEPTH _____
 WELL OPERATOR Pennzoil Company DESIGNATED AGENT James A. Crews
 ADDRESS P. O. Box 1588 ADDRESS P. O. Box 1588
Parkersburg, WV 26101 Parkersburg, WV 26101

LATITUDE 39° 30' 00"

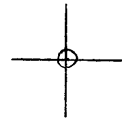

LONGITUDE 80° 03' 00"

7'5 OGIS topo location

7.5' loc 0.29 s 15' loc _____
' 0.81 w (calc.) _____

Company _____

Farm _____

Quad FALSON 7 1/2'

County WETZEL

District GRANT

WELL LOCATION MAP

File No. 103-1073

23 FAIRFIELD

Well No. 88 B. St. Peterson Farm.
 Lease No. Grant District Wetzel County.
 Rig built by South Penn Oil Co.
 Well drilled by South Penn Drilling Tools Co Contractor.
 Began drilling Dec. 6 1908 Completed April 13 1908

ROCK FORMATION	TOP.	BOTTOM.	REMARKS.
Conductor		16	
Pittsburg coal	1089	1096	Stat low measure
Little Bendersand	1445	1525	
Big " "	1590	1620	
Gas sand	1880	1964	
Salt " "	1980	2081	
Little Lime	2294	2306	
Big " "	2308	2365	
Big Injunc sand	2365	2489	" " "
Upper 30 foot "	2850	2861	Water in Injunc 2387, 2457, 2477
50 foot "	2964	3004	Stat 2/6/11-3096.
Lower 30 foot "	3065	3105	" 9/17-15 ft.
Shaly "	3127	3165	
Beddown "	3186	3215	
Oil	3206		
Total Depth		3215	

CASING RECORD.

Size.	CHARGED TO WELL.		PUT IN WELL.		PULLED OUT.		LEFT IN WELL.		Transferred before Completion.		Left at Well Not in Use.	
	Feet	In.	Feet	In.	Feet	In.	Feet	In.	Feet	In.	Feet	In.
10"	302		302		302				302			
8 3/4"	1600	6	1600	6	107	6	1493		107	6		
6 5/8"	2324	5	2324	5			2324	5				
5 1/16"	2503	2	2500				2500		3	2		

Production }
 First 24 Hours } 118 Bbls. Signed A. J. Chambers Supt.