


39° 35'

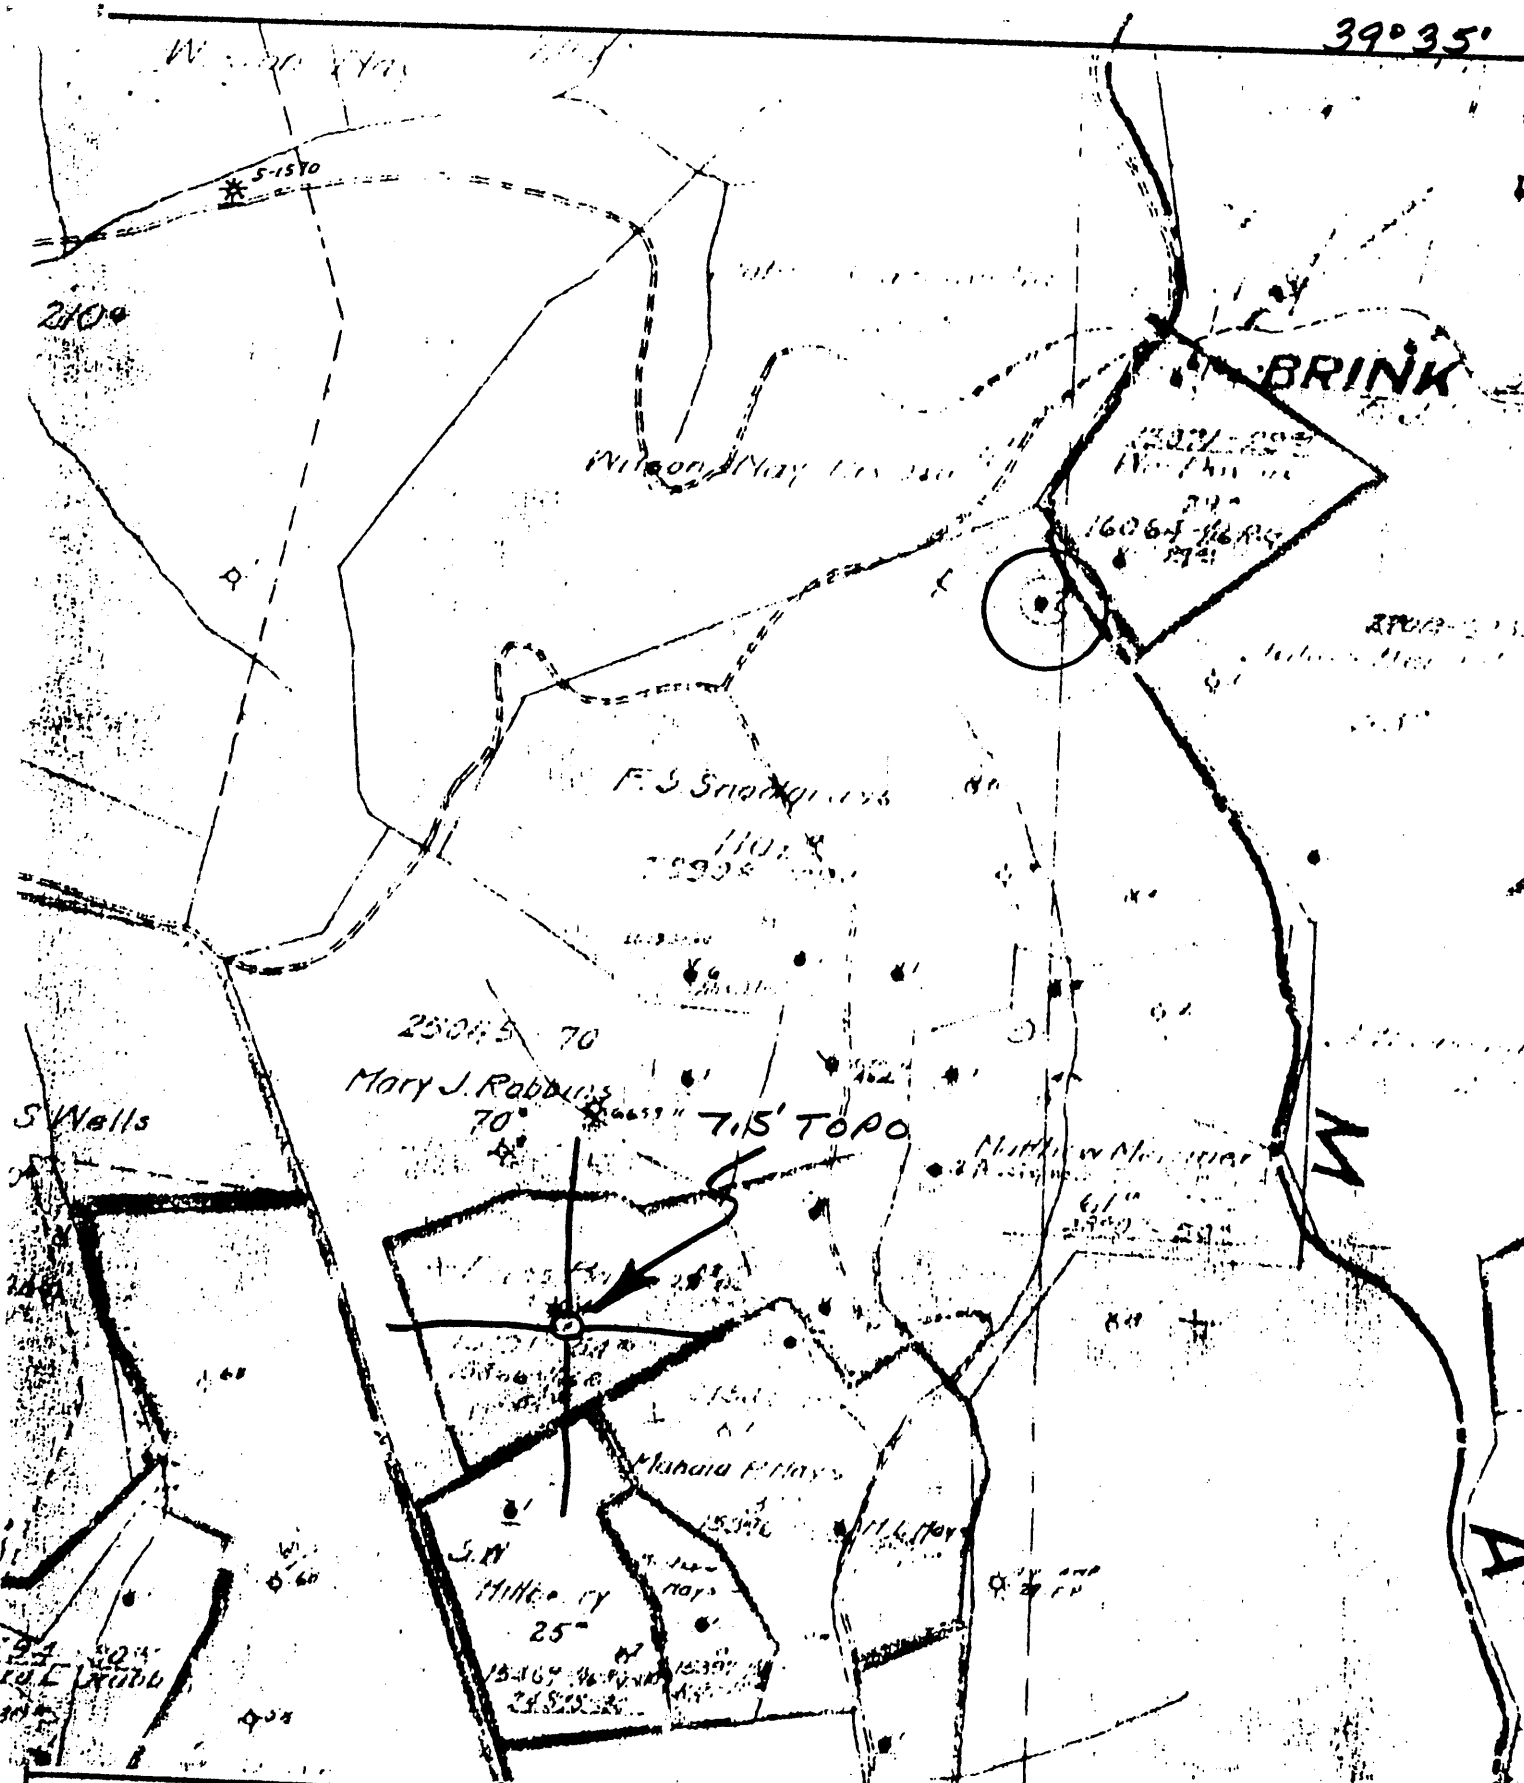

(+) DENOTES LOCATION OF WELL ON UNITED STATES TOPOGRAPHIC MAPS

FORM IV-6 (8-78)

159 N 7 E 7

STATE OF WEST VIRGINIA DEPARTMENT OF MINES OIL AND GAS DIVISION

DATE 1-9- 19 79

OPERATOR'S WELL NO. 7

API WELL NO. 47-103-1115

STATE COUNTY PERMIT

WELL TYPE: OIL GAS LIQUID INJECTION WASTE DISPOSAL
 (IF "GAS", PRODUCTION STORAGE DEEP SHALLOW

LOCATION: ELEVATION _____ WATER SHED PICKENPAW RUN, PRICE RUN

DISTRICT GRANT COUNTY WETZEL

QUADRANGLE GLOVER GAP 7.15'

SURFACE OWNER _____ ACREAGE _____

OIL & GAS ROYALTY OWNER _____ LEASE NO. _____ LEASE ACREAGE _____

PROPOSED WORK: DRILL CONVERT DRILL DEEPER REDRILL FRACTURE OR STIMULATE PLUS OFF OLD FORMATION PERFORATE NEW FORMATION OTHER PHYSICAL CHANGE IN WELL (SPECIFY) _____

PLUS AND ABANDON CLEAN OUT AND REPLUS

TARGET FORMATION _____ ESTIMATED DEPTH _____

WELL OPERATOR Pennzoil Company DESIGNATED AGENT James A. Crews

ADDRESS P. O. Box 1588 ADDRESS P. O. Box 1588

Parkersburg, WV 26101 Parkersburg, WV 26101

F.S. SNODGRASS - 7

LATITUDE 39° 35' 00"

03, 48, 08 LONGITUDE



7'5 OGIS topo location

7.5' 10C 2.68S 15' 10C _____
' 1.87W (calc.) _____

Company _____

Farm _____

Quad GLOVER GAP 7 1/2'

County WETZEL

District GRANT

WELL LOCATION MAP

File No. 103 - 1115

No. 1

SOUTH PENN OIL COMPANY—COMPLETION

SERIAL NO. _____ FARM SNODGRASS. F.S. WELL NO. 7
 ELEVATION _____ N. 7 " S. _____ E. 7 " W. _____
 LEASE NO. _____ ACRES Map 2753
 WATERS OF Pickenaw Run, Prices Fork, So. Fork Fishing Creek
 DISTRICT Grant COUNTY Wetzel STATE W. Va.
 DRILLING COMMENCED 3/8/99 COMPLETED 4/29/99 DEPTH 2643

SANDS	TOP	BOTTOM	ELEV. TOP	CASING
PGH. COAL ON THE LINE	1261	?		10 1307
Big Injun	2566			8 1/2 2207
1st Pay	2632	2637		6 1/2 2207
				5 1/2 2566

PACKERS AND DEPTH SET

INITIAL PROD. 5 Bbls SAND Big Injun DEPTH 2632
 GAS TEST _____ " _____ " _____
 SHOT 10/21/99 QUARTS 5 " _____ " _____
 REMARKS Bought from Hartmans Oil Co.
WETZEL DISTRICT

REPORTED BY _____ ABANDONED _____

103-1115

47-103-1115

103-1115

Pennzoil Co
(~ South Penn Oil Co)

F. S. SNODGRASS NO. 7 WELL.

Pub. Vol. I(a), p. 192.
Not republished.
No. 153, Old File.

Grant District, Wetzel County, W. Va.
By Hartman Oil Co.

	Top.	Bottom.
Pittsburgh Coal	1261	
Gas Sand	2073	- 2108
Salt Sand	2148	- 2250
Pencil Cave	2477	-(2483)
Big Lime	2483	- 2566
Big Injun Sand	2566	- 2642½