



47103011179

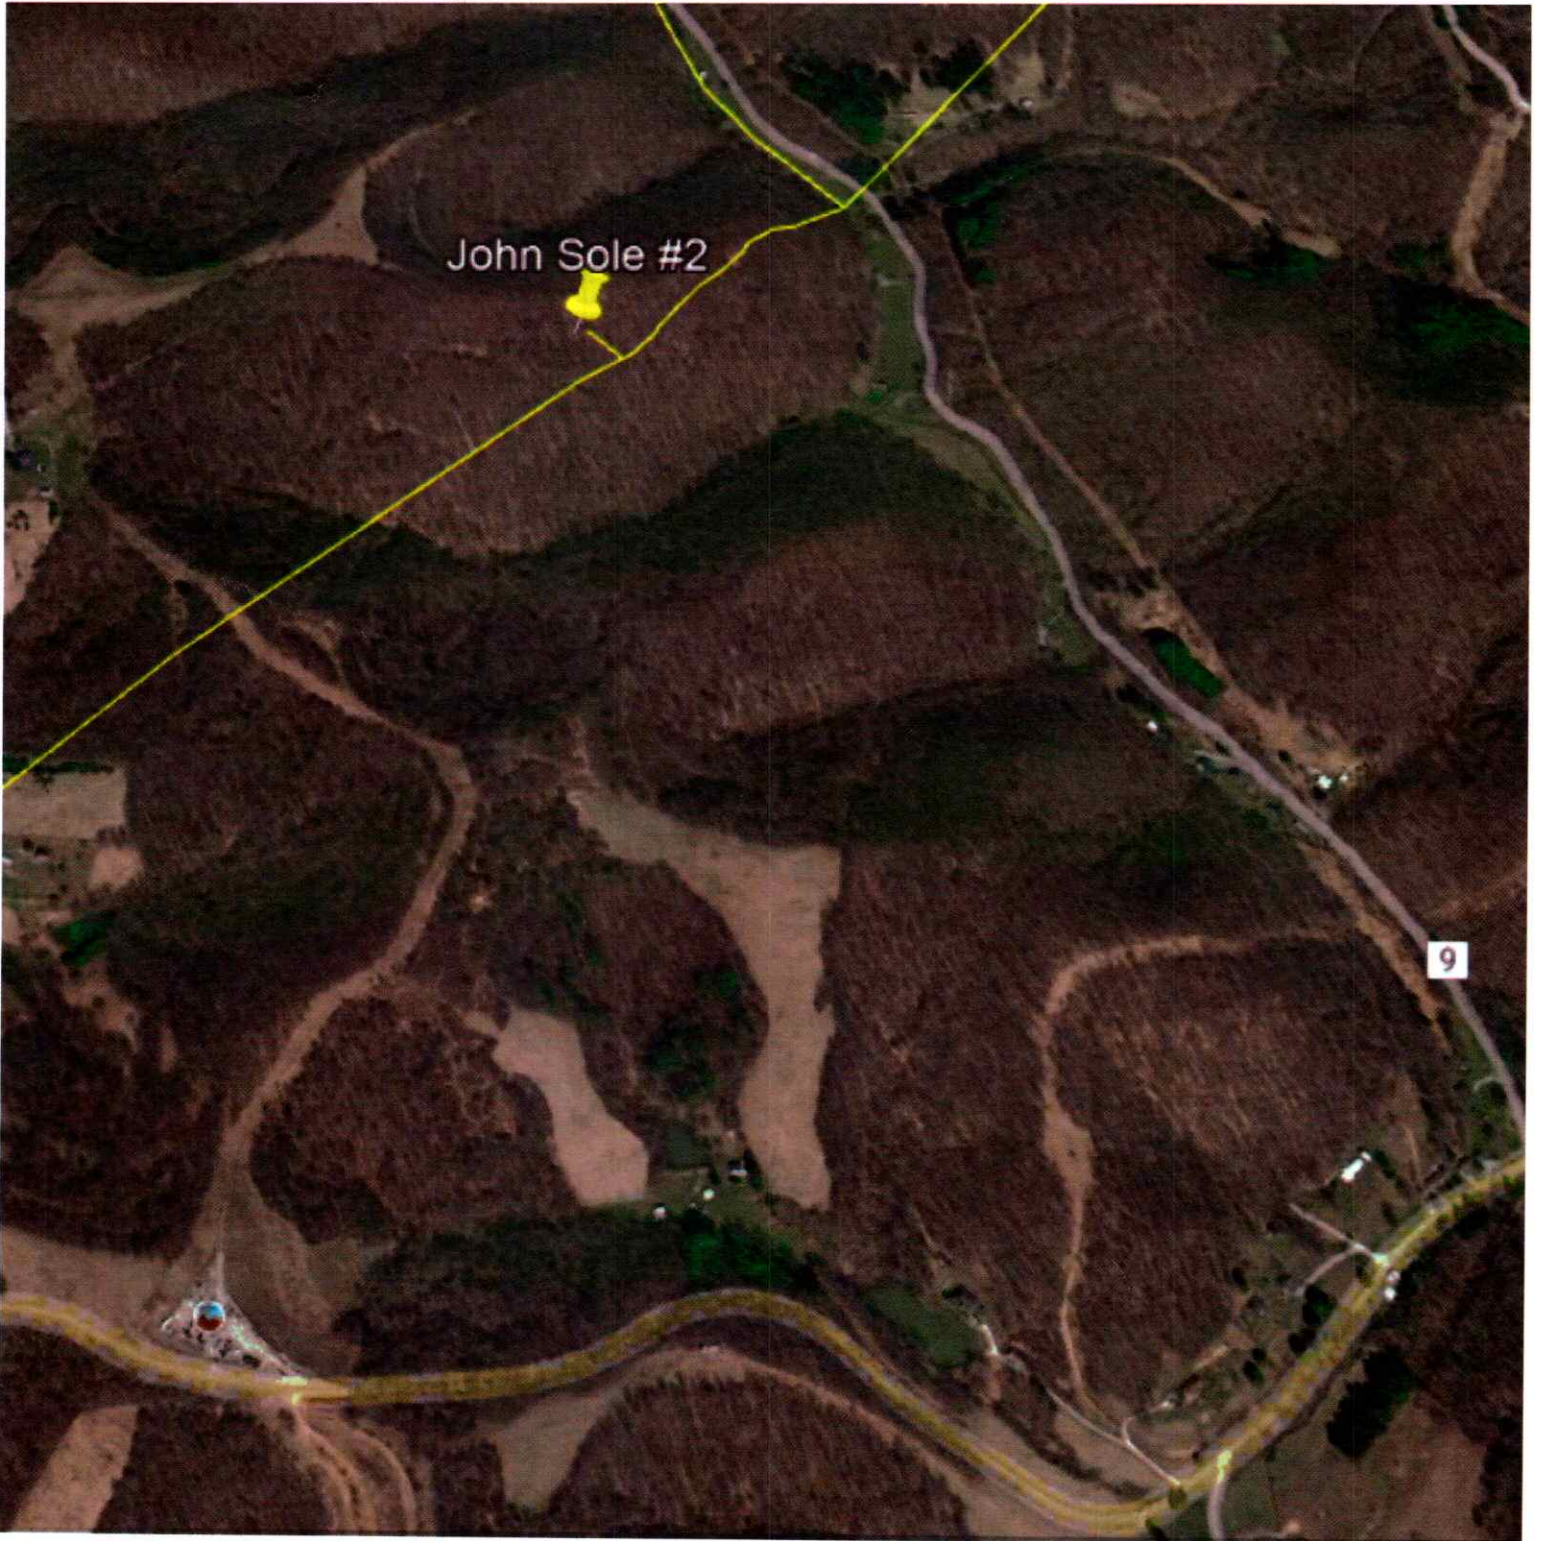

RECEIVED
Office of Oil and Gas
MAY 18 2023
WV Department of
Environmental Protection
06/16/2023

4710301117P

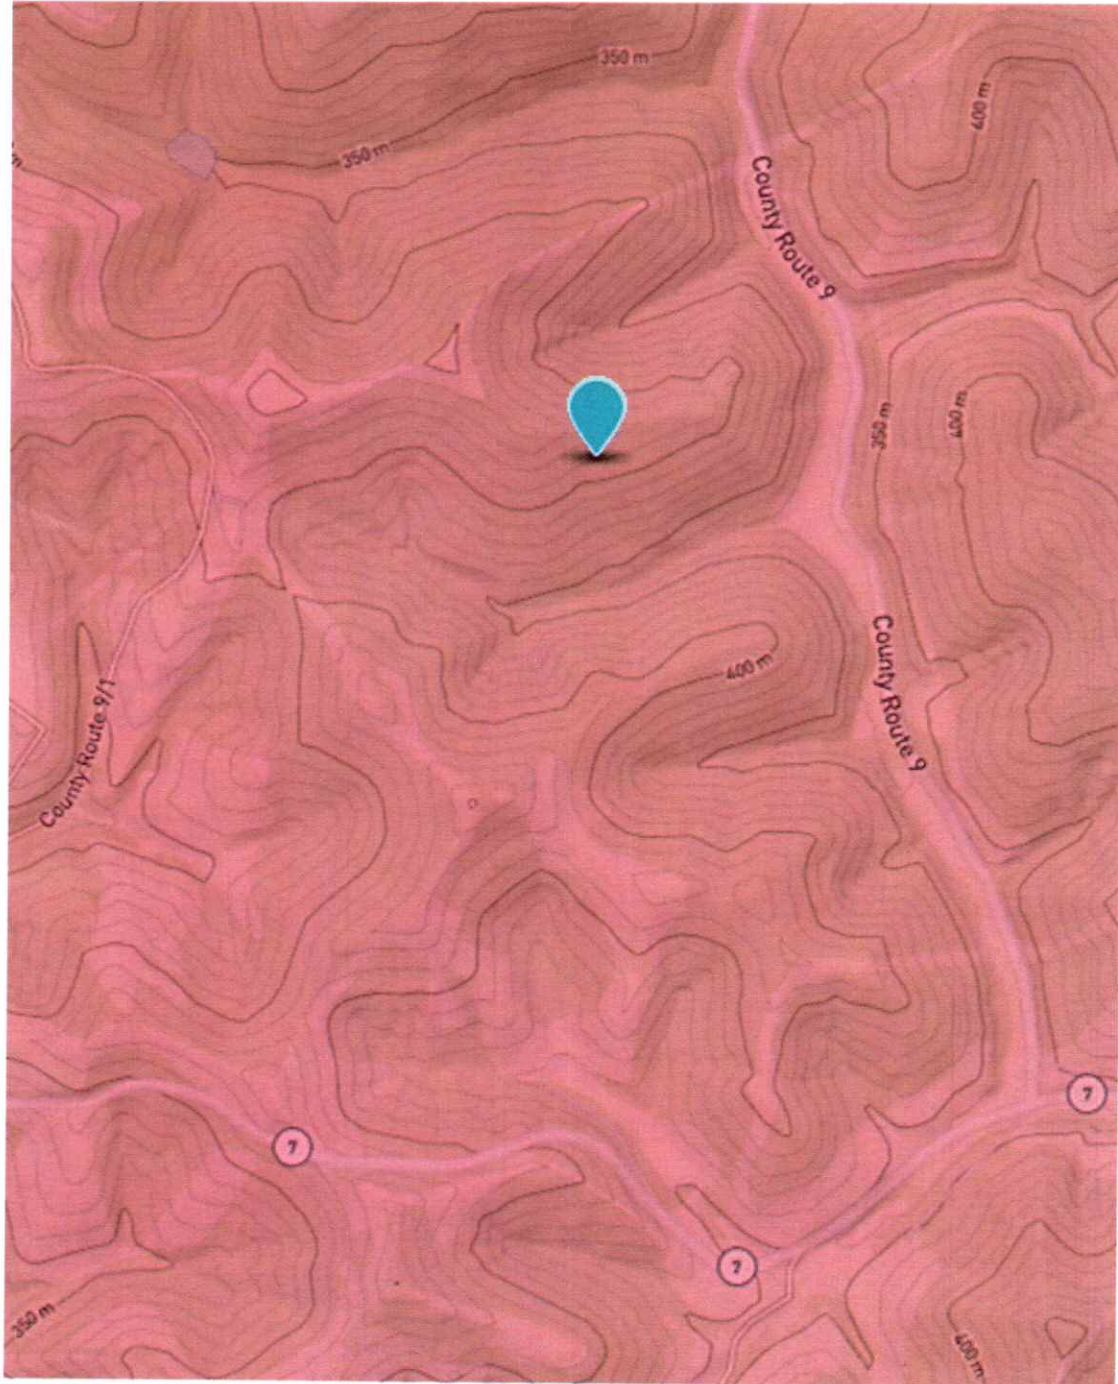

RECEIVED
Office of Oil and Gas

MAY 18 2023

WV Department of
Environmental Protection

06/16/2023

WW-7
8-30-06



West Virginia Department of Environmental Protection
Office of Oil and Gas
WELL LOCATION FORM: GPS

API: 47-103-01117 WELL NO.: 2

FARM NAME: Soles, John

RESPONSIBLE PARTY NAME: Harman Brown

COUNTY: Wetzel DISTRICT: Clay

QUADRANGLE: Littleton

SURFACE OWNER: Genevieve Booth

ROYALTY OWNER: Elkhorn Minerals II, LLC, Lion Royalty, LLC

UTM GPS NORTHING: 4390569.27

UTM GPS EASTING: 540340.92 GPS ELEVATION: 1377'

The Responsible Party named above has chosen to submit GPS coordinates in lieu of preparing a new well location plat for a plugging permit or assigned API number on the above well. The Office of Oil and Gas will not accept GPS coordinates that do not meet the following requirements:

1. Datum: NAD 1983, Zone: 17 North, Coordinate Units: meters, Altitude: height above mean sea level (MSL) – meters.
2. Accuracy to Datum – 3.05 meters
3. Data Collection Method:

Survey grade GPS ____: Post Processed Differential ____

Real-Time Differential ____

Mapping Grade GPS : Post Processed Differential ____

Real-Time Differential ____

4. **Letter size copy of the topography map showing the well location.**

I the undersigned, hereby certify this data is correct to the best of my knowledge and belief and shows all the information required by law and the regulations issued and prescribed by the Office of Oil and Gas.

David R. Oliver
Signature

Digitally signed by David R. Oliver
Date: 2023.04.23 08:45:40 -0400

Pipeline/Facilities Engineer
Title

4/23/2023
Date

RECEIVED
Office of Oil and Gas
MAY 18 2023
WV Department of
Environmental Protection

06/16/2023

