


LATITUDE 39° 30' 00"

LONGITUDE 80° 08' 00"

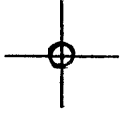

7.5 OGIS topo location

7.5' 10C 1.42S 15' 10C \_\_\_\_\_  
                  2.22W (calc.) \_\_\_\_\_

Company \_\_\_\_\_

Farm \_\_\_\_\_

Quad Folsom 7 1/2'


County WETZEL

District GRANT


WELL LOCATION MAP

File No. 103-1121



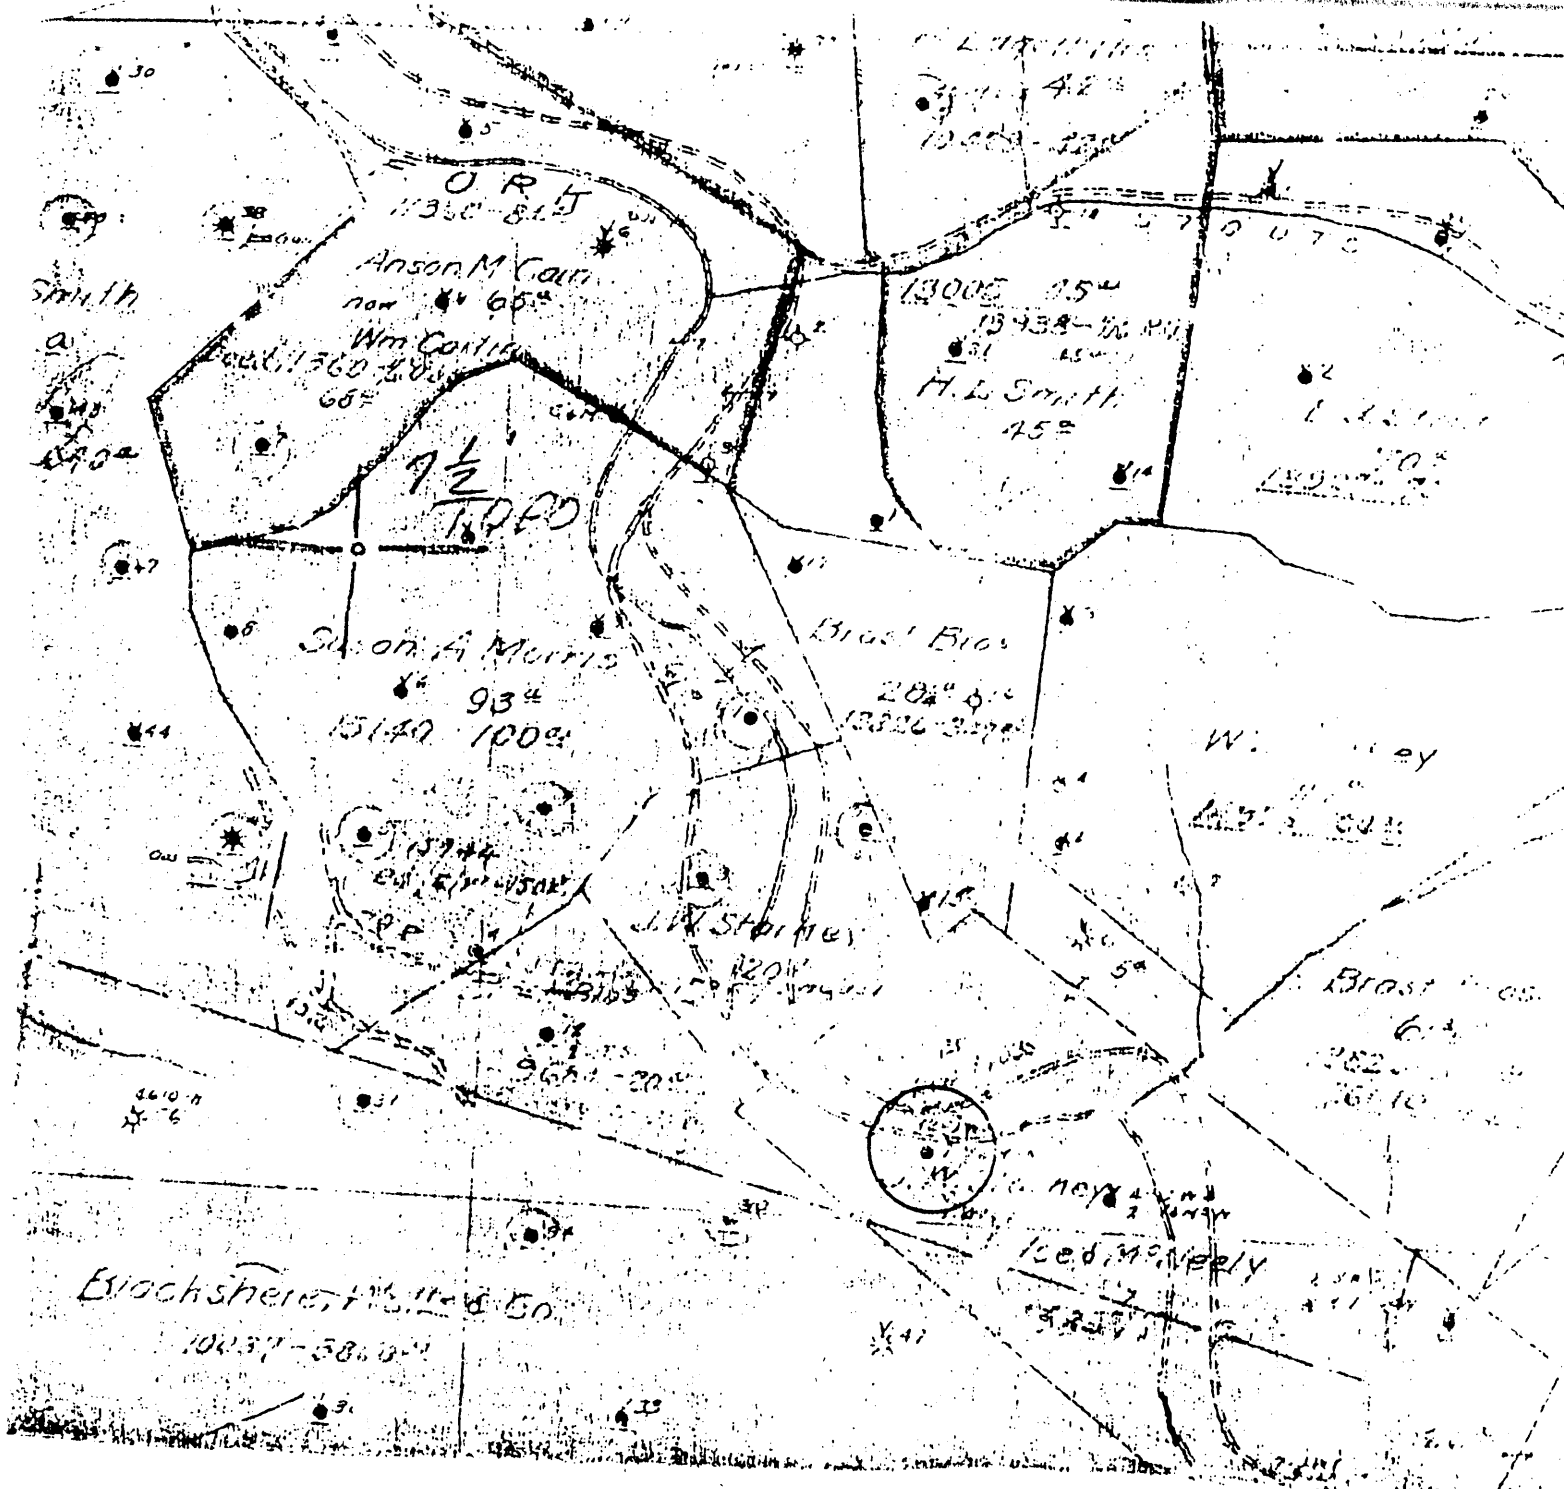

(+) DENOTES LOCATION OF WELL ON UNITED STATES TOPOGRAPHIC MAPS  
 FORM IV-6 (8-78)  
 N59 N3 E5

  
 STATE OF WEST VIRGINIA  
 DEPARTMENT OF MINES  
 OIL AND GAS DIVISION

DATE JAN. 25, 1975  
 OPERATOR'S WELL NO. 1  
 API WELL NO. 47-103-1121  
 STATE COUNTY PERMIT

WELL TYPE: OIL  GAS  LIQUID INJECTION  WASTE DISPOSAL   
 (IF "GAS", PRODUCTION  STORAGE  DZEP  SHALLOW   
 LOCATION: ELEVATION \_\_\_\_\_ WATER SHED \_\_\_\_\_  
 DISTRICT Chilton COUNTY \_\_\_\_\_  
 QUADRANGLE FDK 1011

SURFACE OWNER \_\_\_\_\_ ACREAGE \_\_\_\_\_  
 OIL & GAS ROYALTY OWNER \_\_\_\_\_ LEASE NO. \_\_\_\_\_ LEASE ACREAGE \_\_\_\_\_

PROPOSED WORK: DRILL  CONVERT  DRILL DEEPER  REDRILL  FRACTURE OR STIMULATE  PLUG OFF OLD FORMATION  PERFORATE NEW FORMATION  OTHER PHYSICAL CHANGE IN WELL (SPECIFY) \_\_\_\_\_

PLUS AND ABANDON  CLEAN OUT AND REPLUG   
 TARGET FORMATION \_\_\_\_\_ ESTIMATED DEPTH \_\_\_\_\_  
 WELL OPERATOR Pennzoil Company DESIGNATED AGENT James A. Brown  
 ADDRESS P. O. Box 1588 ADDRESS P. O. Box 1588  
Parkersburg, WV 26101 Parkersburg, WV 26101

J.W. STARKEY - 1

