

LATITUDE 39° 30' 00"

LONGITUDE

~~100° 05' 00"~~  
100° 03' 30"

7'5 OGIS topo location

7.5' loc 1.165 15' loc \_\_\_\_\_  
                  0.03w (calc.) \_\_\_\_\_

Company \_\_\_\_\_

Farm \_\_\_\_\_


Quad Folsom 7 1/2'

County WETZEL

District GRANT

WELL LOCATION MAP

File No. 103-1123

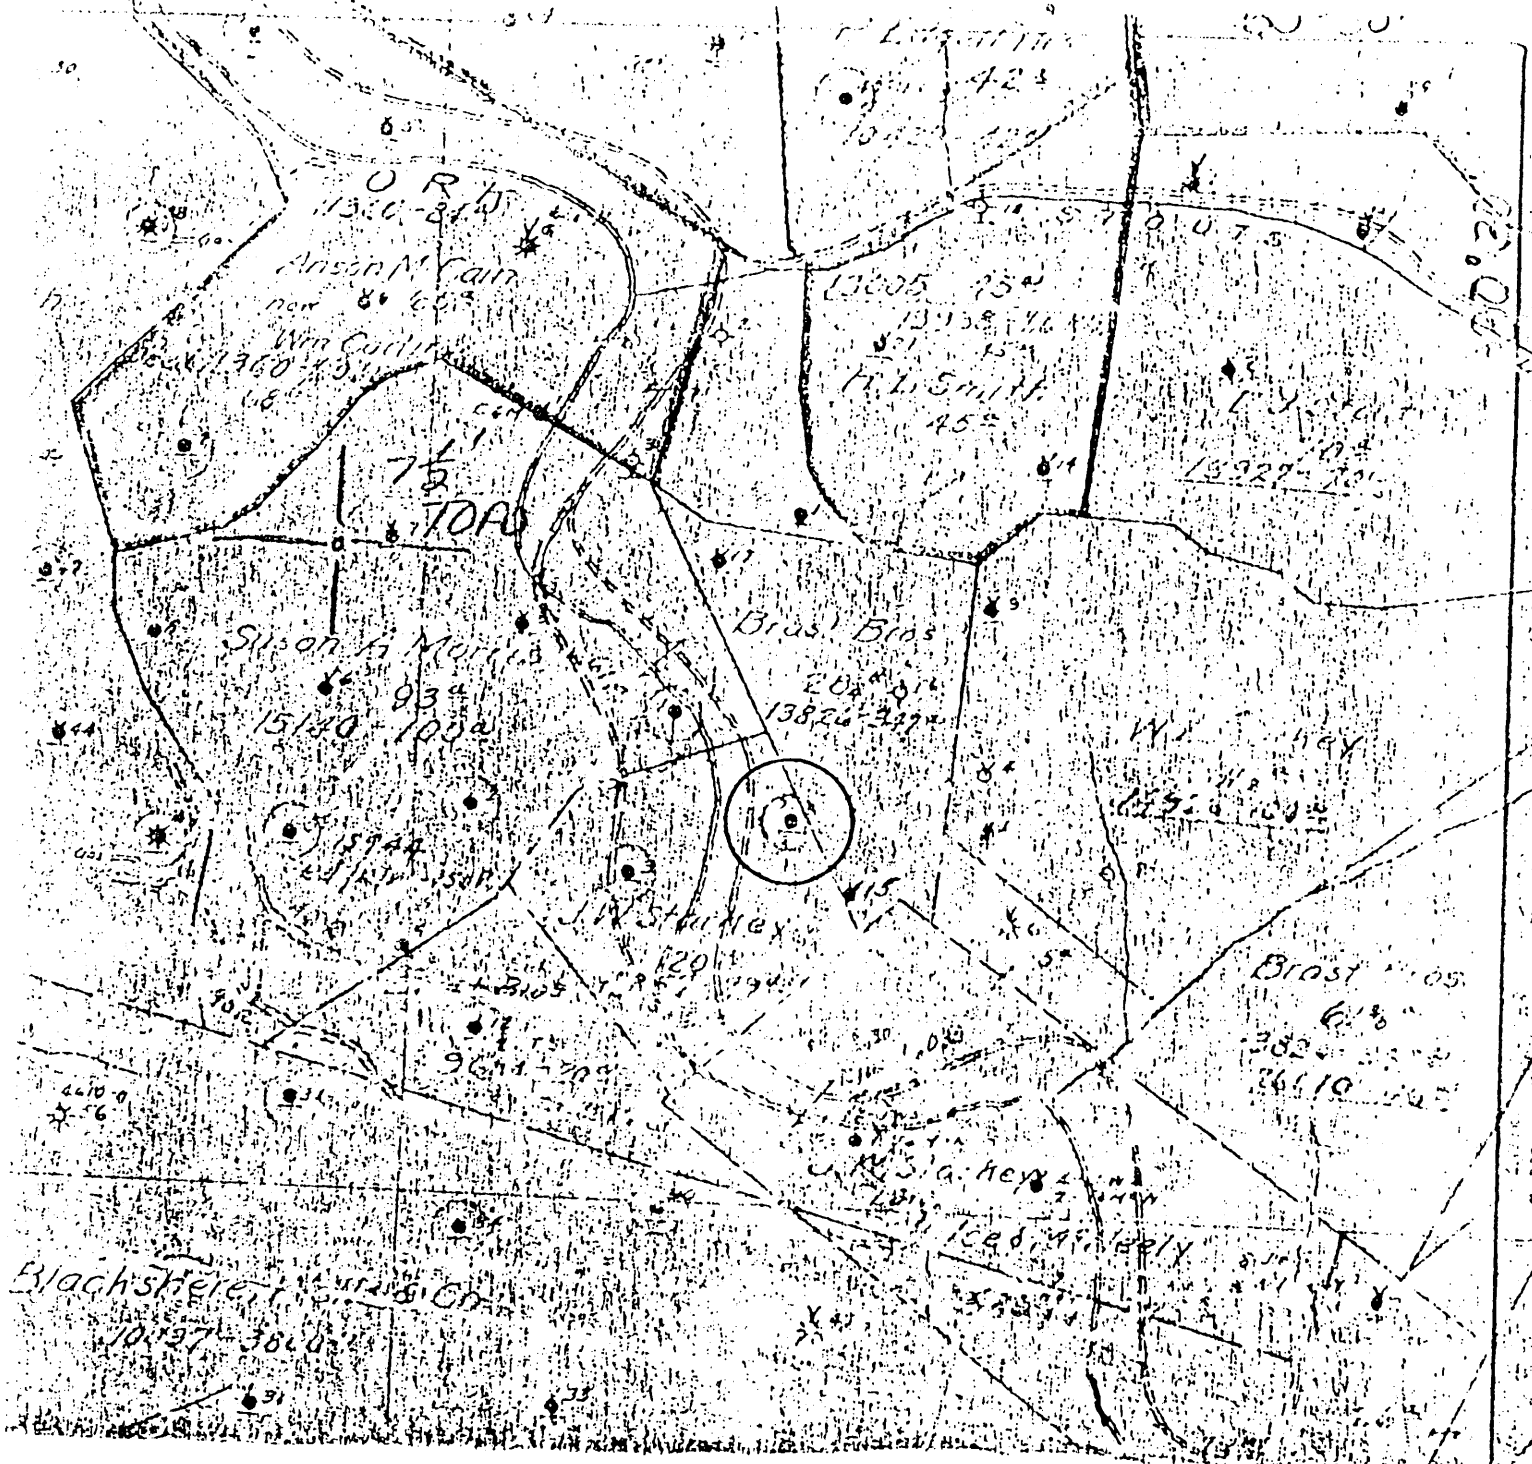

(+) DENOTES LOCATION OF WELL ON UNITED STATES TOPOGRAPHIC MAPS

FORM IV-6 (8-78)

159N3E5



STATE OF WEST VIRGINIA DEPARTMENT OF MINES OIL AND GAS DIVISION

DATE JAN 26, 1979  
 OPERATOR'S WELL NO. 5  
 API WELL NO. 47-103-1123  
 STATE COUNTY PERMIT

WELL TYPE: OIL  GAS  LIQUID INJECTION  WASTE DISPOSAL   
 (IF "GAS", PRODUCTION  STORAGE  DEEP  SHALLOW   
 LOCATION: ELEVATION \_\_\_\_\_ WATER SHED ST. FK FISHING CREEK  
 DISTRICT BRANT COUNTY WETZEL  
 QUADRANGLE F01SDM

SURFACE OWNER \_\_\_\_\_ ACREAGE \_\_\_\_\_  
 OIL & GAS ROYALTY OWNER \_\_\_\_\_ LEASE NO. \_\_\_\_\_ LEASE ACREAGE \_\_\_\_\_

PROPOSED WORK: DRILL  CONVERT  DRILL DEEPER  REDRILL  FRACTURE OR STIMULATE  PLUG OFF OLD FORMATION  PERFORATE NEW FORMATION  OTHER PHYSICAL CHANGE IN WELL (SPECIFY) \_\_\_\_\_

PLUG AND ABANDON  CLEAN OUT AND REPLUG  ESTIMATED DEPTH \_\_\_\_\_  
 TARGET FORMATION \_\_\_\_\_ DESIGNATED AGENT James A. Crews  
 WELL OPERATOR Pennzoil Company ADDRESS P. O. Box 1588  
 ADDRESS Parkersburg, WV 26101 ADDRESS Parkersburg, WV 26101

(W. STARNES) - 5

No. 1

# SOUTH PENN OIL COMPANY—COMPLETION

FORMERLY BRANT & BROS.

SERIAL NO. \_\_\_\_\_ FARM STARKEY. J.W. WELL NO. 5  
 ELEVATION \_\_\_\_\_ N. 3 S. \_\_\_\_\_ E. 5 W. \_\_\_\_\_  
 LEASE NO. \_\_\_\_\_ ACRES Map 2052  
 WATERS OF Ten Mile Fork, So. Fork Fishing Creek  
 DISTRICT Grant COUNTY Wetzel STATE W. Va.  
 DRILLING COMMENCED 2/15/06 COMPLETED 2/26/06 DEPTH 2170

SANDS	TOP	BOTTOM	ELEV. TOP	CASING
Pgm. Coal or <del>Bitum.</del>	763	745		
Big Injun	2053			10 525
1st Pay	2151			8 1316
2nd Pay	2163			6 2115

PACKERS AND DEPTH SET

INITIAL PROD. 6 Ebls SAND Big Injun DEPTH 2163  
 GAS TEST \_\_\_\_\_  
 SHOT 12/4/01 QUARTS 16 " " " 2151

REMARKS \_\_\_\_\_  
 REPORTED BY FRANK \_\_\_\_\_ ABANDONED \_\_\_\_\_

103-1123