

WW-7
8-30-06



West Virginia Department of Environmental Protection
Office of Oil and Gas
WELL LOCATION FORM: GPS

API: 47-103-01484 WELL NO.: 7186
 FARM NAME: LEVI SHUMAN HEIRS
 RESPONSIBLE PARTY NAME: WEST VIRGINIA LAND RESOURCES INC.
 COUNTY: WETZEL DISTRICT: GRANT
 QUADRANGLE: FOLSOM W.VA
 SURFACE OWNER: BERNARD R. ELLIOTT SR.
 ROYALTY OWNER: _____
 UTM GPS NORTHING: 4,371,791 m 1430'
 UTM GPS EASTING: 541,393 m GPS ELEVATION: 436 m

The Responsible Party named above has chosen to submit GPS coordinates in lieu of preparing a new well location plat for a plugging permit or assigned API number on the above well. The Office of Oil and Gas will not accept GPS coordinates that do not meet the following requirements:

1. Datum: NAD 1983, Zone: 17 North, Coordinate Units: meters, Altitude: height above mean sea level (MSL) – meters.
2. Accuracy to Datum – 3.05 meters
3. Data Collection Method:

Survey grade GPS _____: Post Processed Differential _____

Real-Time Differential _____

Mapping Grade GPS X: Post Processed Differential X

Real-Time Differential _____

RECEIVED
Office of Oil and Gas

JUL 26 2021

WV Department of
Environmental Protection

4. **Letter size copy of the topography map showing the well location.**

I the undersigned, hereby certify this data is correct to the best of my knowledge and belief and shows all the information required by law and the regulations issued and prescribed by the Office of Oil and Gas.

Signature

Professional Surveyor

Title

JUNE 24, 2021


Date

08/27/2021

Well# 7186

FOLSOM WV 7.5' Quad

Scale: 1" = 500'

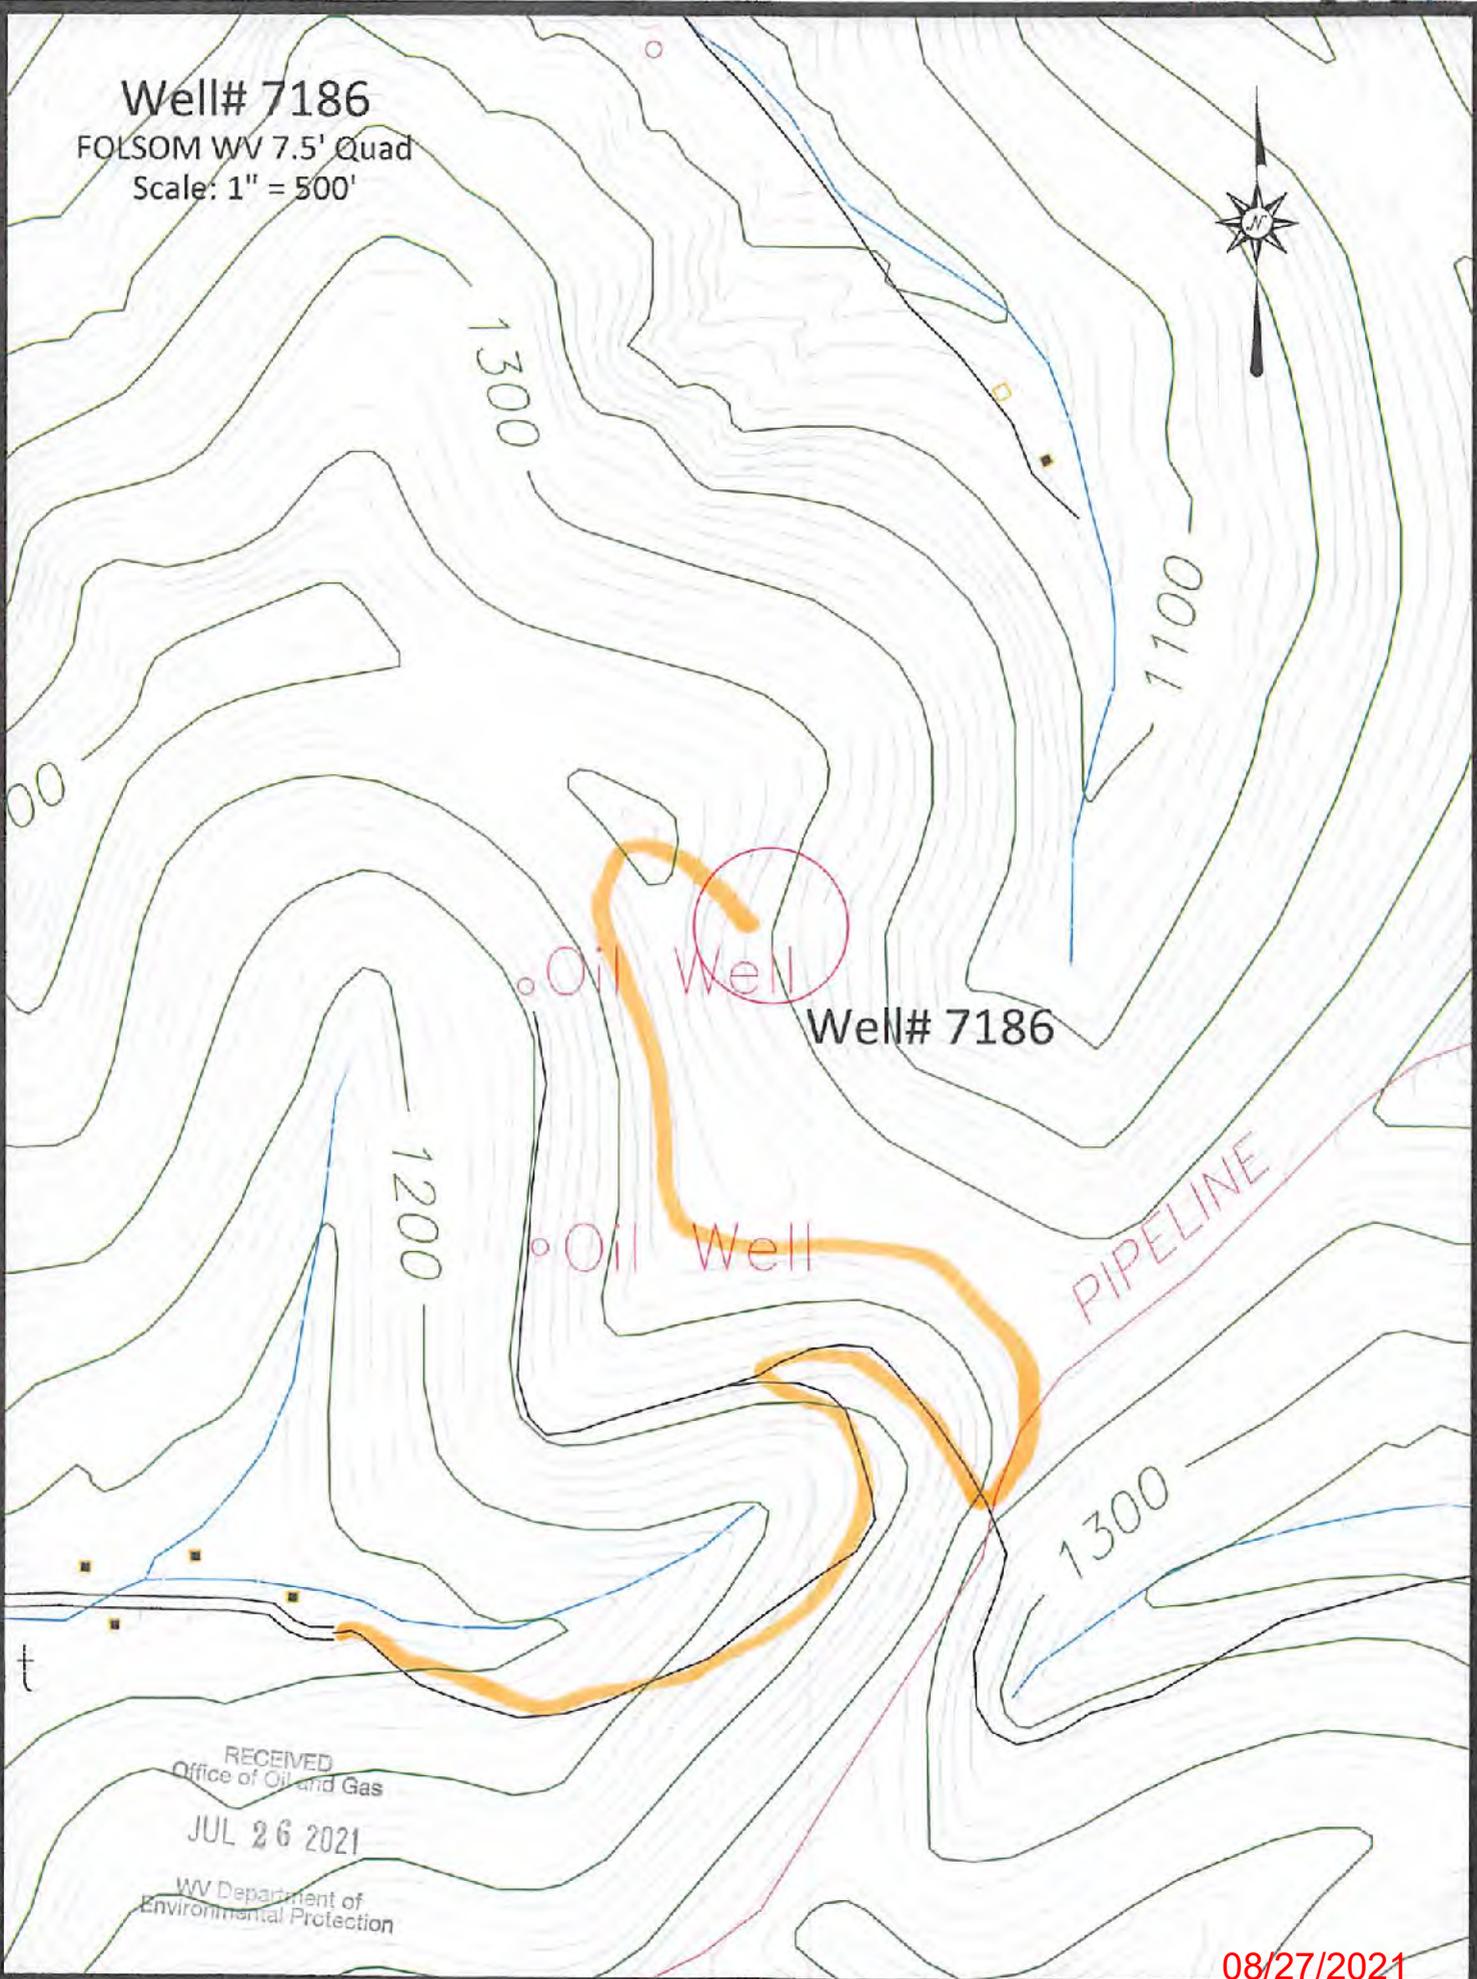

RECEIVED
Office of Oil and Gas

JUL 26 2021

WV Department of
Environmental Protection

08/27/2021

Handwritten orange line H&S and Road


Well# 7186

FOLSOM WV 7.5' Quad

Scale 1" = 2000'

Map

Corn

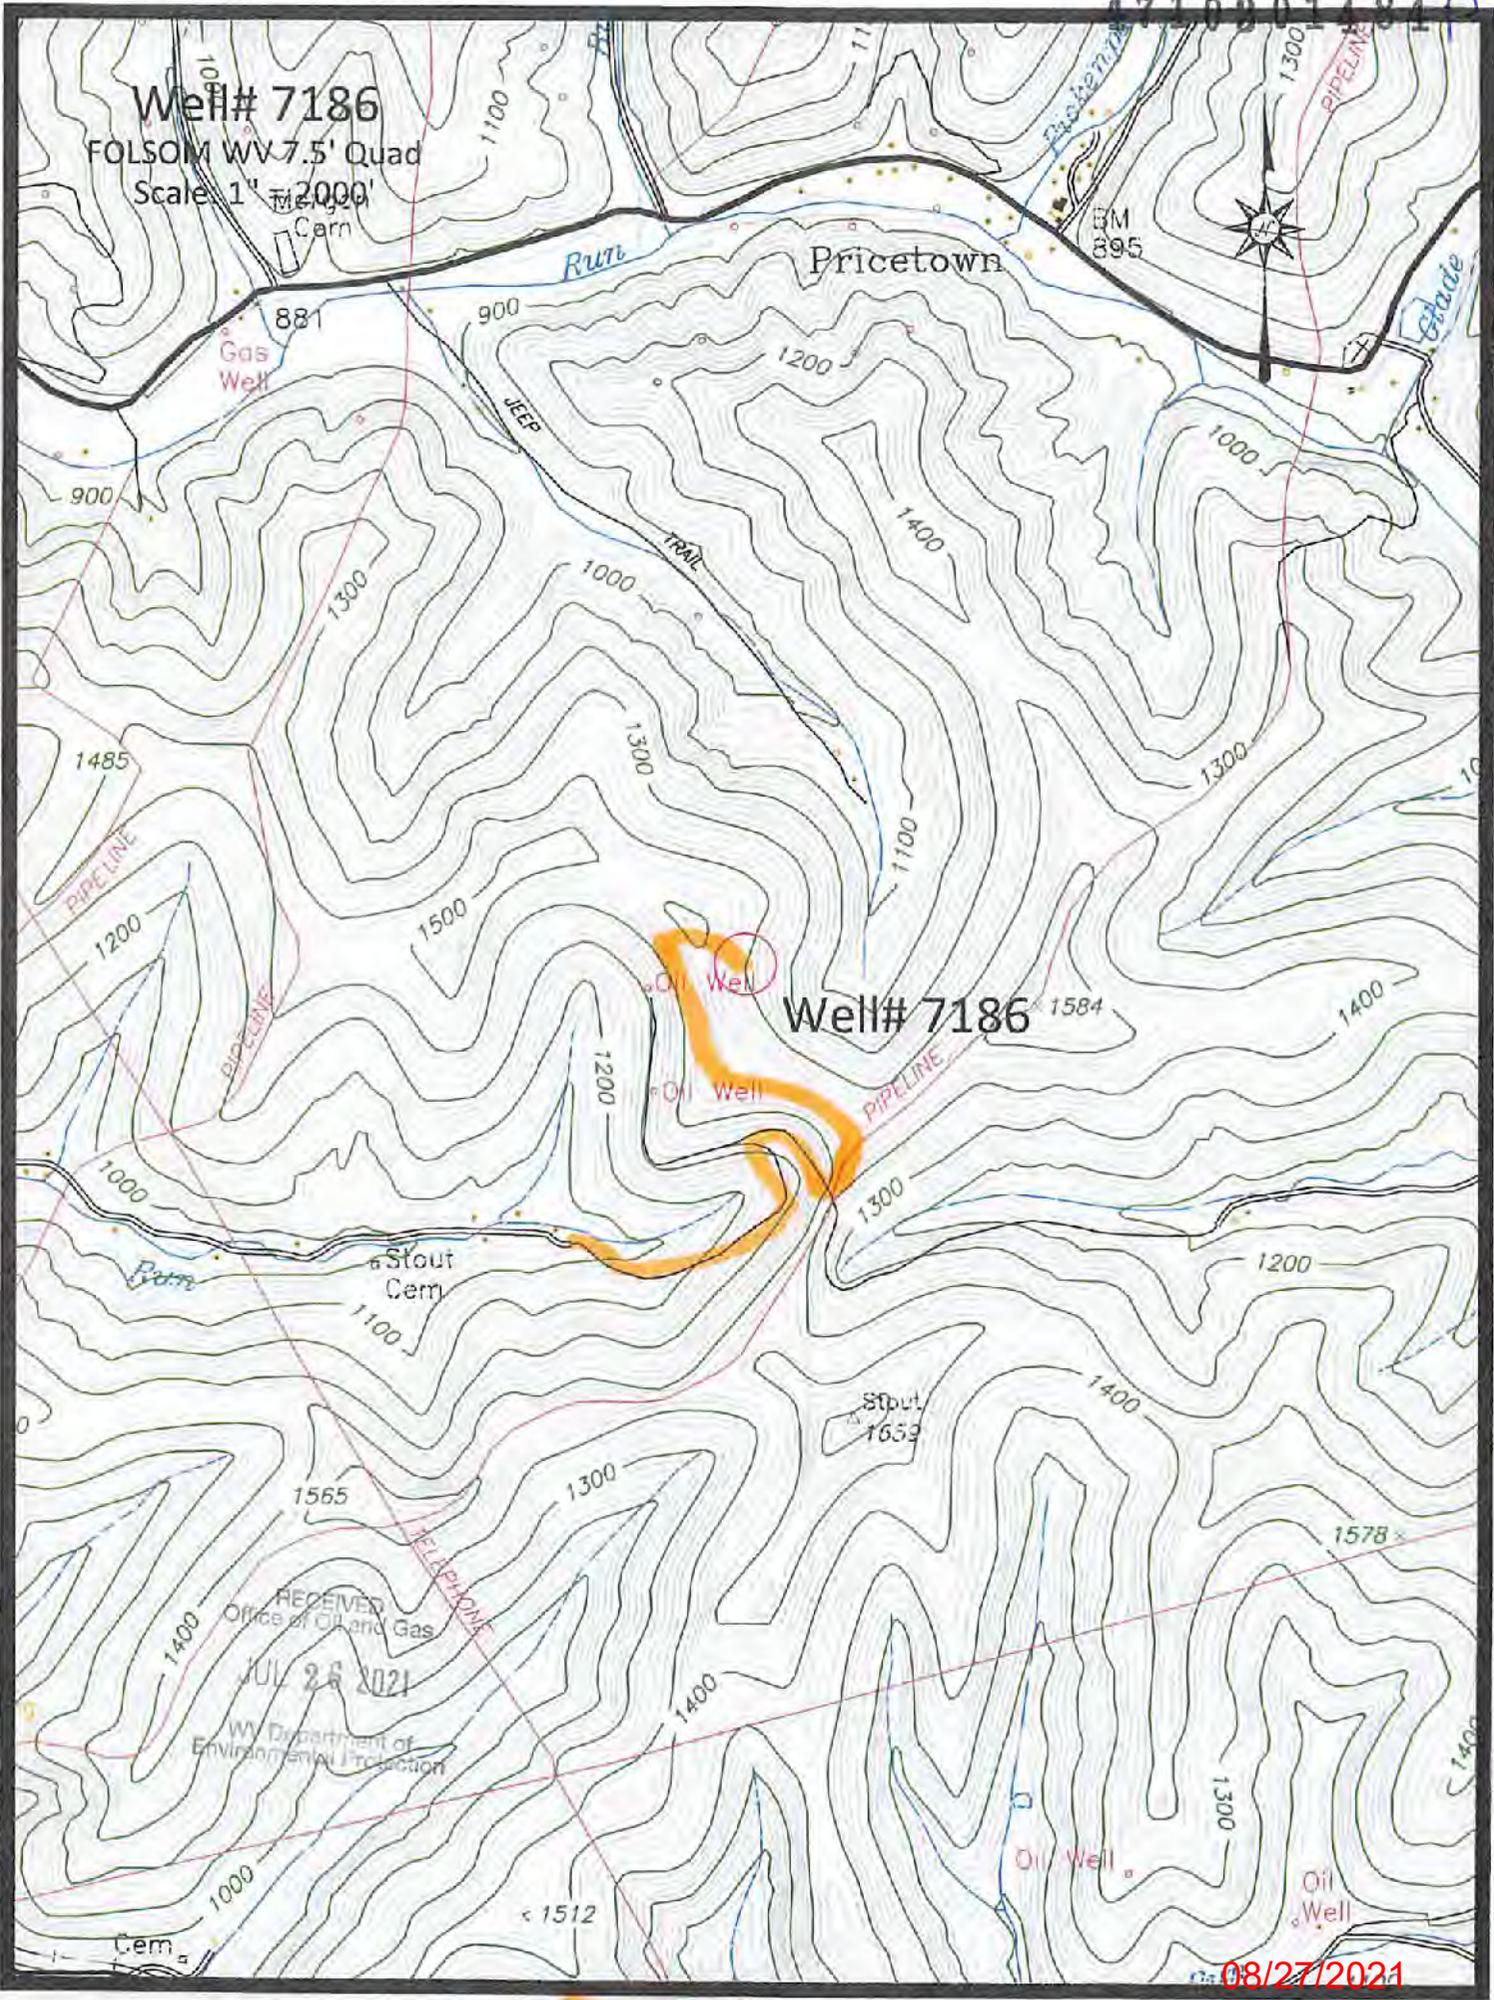


Orange Road

4710301484P

FOLSOM QUADRANGLE
WEST VIRGINIA
7.5 MINUTE SERIES (TOPOGRAPHIC)
NE/4 CENTER POINT 15' QUADRANGLE

M69 III SW
(GLOVER GAP)

339 32'30" 340 1 720 000 FEET 342 80° 30' 39° 30'

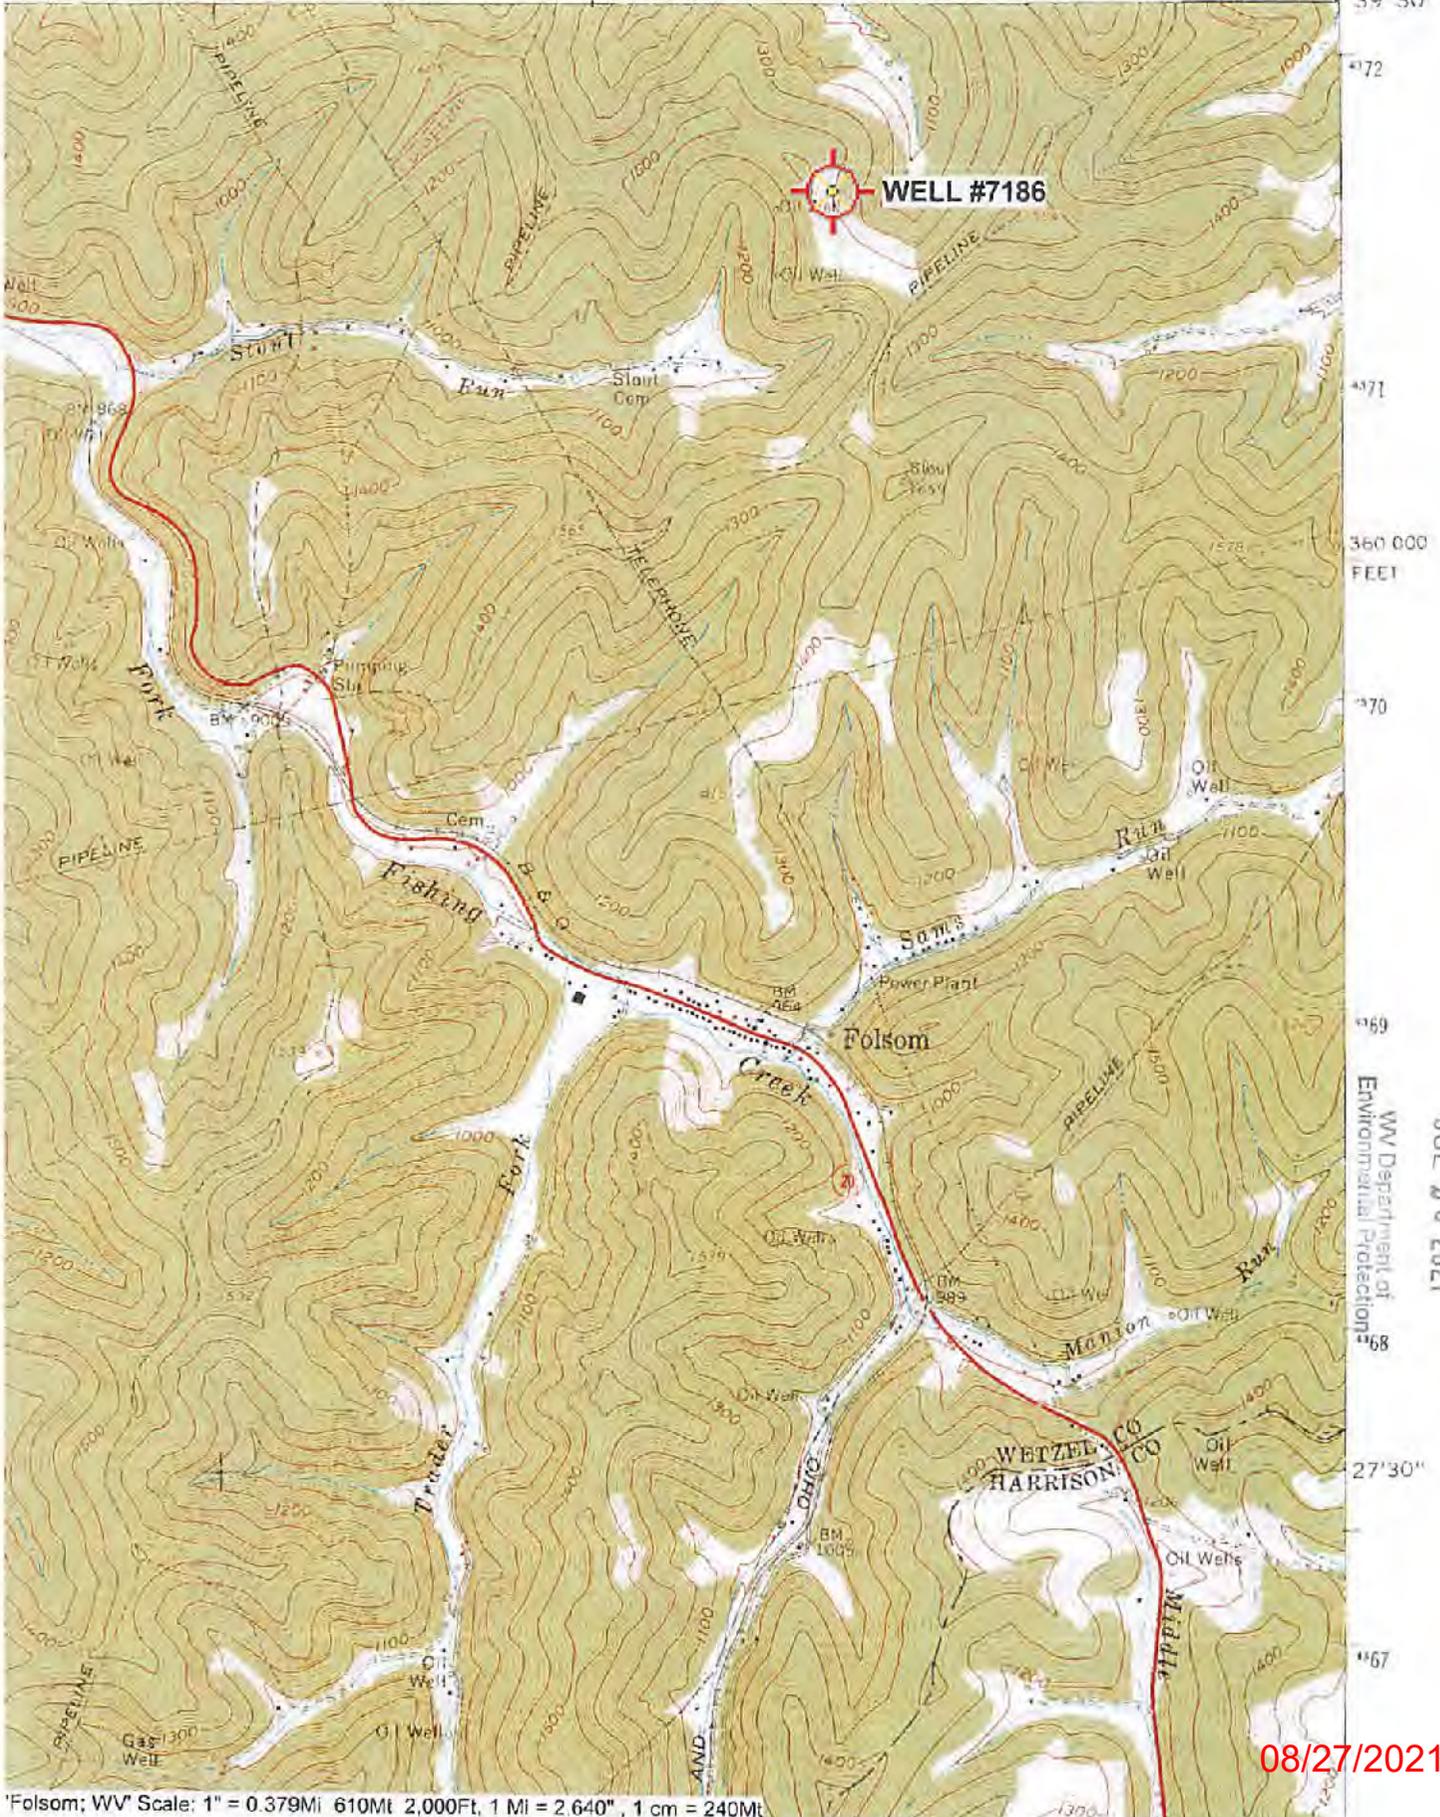

RECEIVED
Office of Oil and Gas
JUL 26 2021
WV Department of
Environmental Protection

08/27/2021

'Folsom; WV' Scale: 1" = 0.379Mi 610M 2,000Ft, 1 Mi = 2.640", 1 cm = 240M