

INSTRUCTIONS

- 1) Attach a photo copy of the location of the well on a 7.5 minute Quadrangle with the corresponding Longitude and Latitude.
- 2) Designate the location of the well with the symbol(+).

80 42 30

+
1.305
202W

I, the undersigned, Hereby certify that this plat is correct to the best of my knowledge and belief.

SIGNED Daryl L. Perkins
TITLE U. Pres.

DATE June 22, 19 90
OPERATORS WELL NO. Garner #6
API WELL NO. 103-1487

STATE OF WEST VIRGINIA
DEPARTMENT OF ENERGY
OIL AND GAS DIVISION

WELL TYPE: OIL GAS LIQUID INJECTION WASTE DISPOSAL
(if "GAS" PRODUCTION STORAGE DEEP SHALLOW

LOCATION: ELEVATION unknown WATER SHED _____
DISTRICT Procter COUNTY Wetzel
QUADRANGLE Wileyville

SURFACE OWNER Garner Heirs ACREAGE 1496

OIL & GAS ROYALTY OWNER _____ LEASE ACREAGE 1496
LEASE NO. _____

PRODUCING FORMATION Gordon TOTAL DEPTH 2862

WELL OPERATOR PERKINS OIL AND GAS, INC. DESIGNATED AGENT Daryl L. Perkins


ADDRESS #2, Box 214 ADDRESS _____
Pennsboro, WV 26415

MAR 10 1992

Wileyville 4

Wileyville Quadrangle

New Martinsville Quadrangle

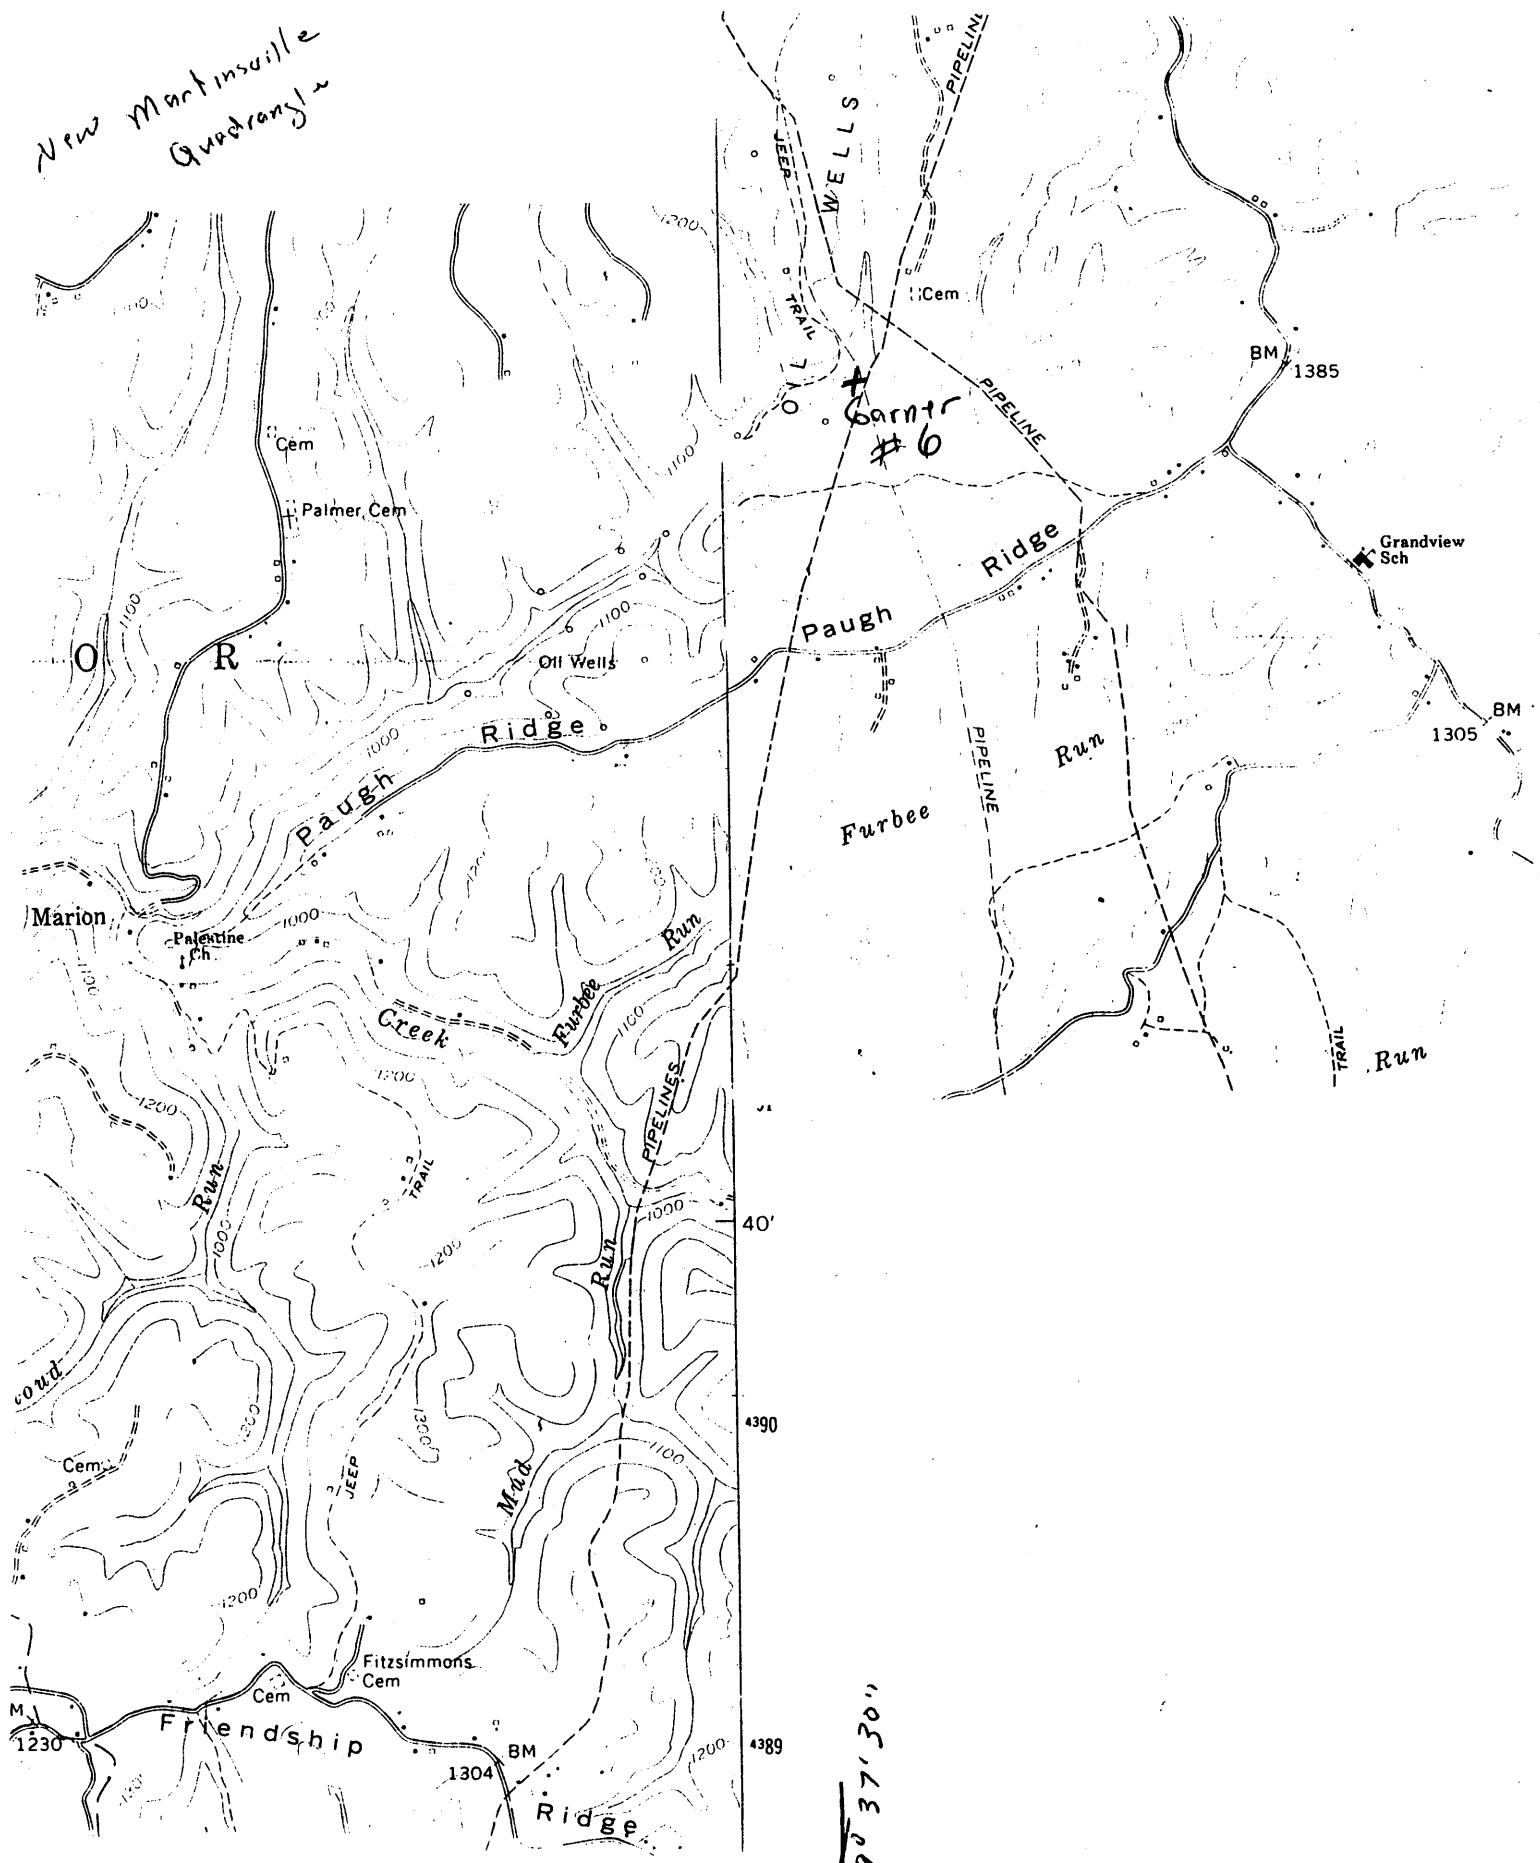

Garner #6

80° 45' ← 390 37' 30" (Pine Grove 4863 11 SW)