

INSTRUCTIONS

- 1) Attach a photo copy of the location of the well on a 7.5 minute Quadrangle with the corresponding Longitude and Latitude.
- 2) Designate the location of the well with the symbol(+).

80 45

+
1.43
0.00

I, the undersigned, Hereby certify that this plat is correct to the best of my knowledge and belief.

SIGNED David L. Perkins
TITLE V. Pres.

DATE June 22, 1990
OPERATORS WELL NO. Nuggins #4
API WELL NO. 103-1491

STATE OF WEST VIRGINIA
DEPARTMENT OF ENERGY
OIL AND GAS DIVISION

WELL TYPE: OIL GAS LIQUID INJECTION WASTE DISPOSAL
(IE "GAS" PRODUCTION STORAGE DEEP SHALLOW

889
70110
73000

LOCATION: ELEVATION unknown WATER SHED _____
DISTRICT Proctor COUNTY Wetzel
QUADRANGLE New Martinsville


SURFACE OWNER J. R. Nuggins Heirs ACREAGE 100⁺
OIL & GAS ROYALTY OWNER J. R. Nuggins Heirs LEASE ACREAGE 100⁺
LEASE NO. _____

PRODUCING FORMATION Gordon TOTAL DEPTH 2786
WELL OPERATOR PERKINS OIL AND GAS, INC. DESIGNATED AGENT Deryl L. Perkins
ADDRESS Pennsboro, WV 26415 ADDRESS PERKINS OIL AND GAS, INC.
Rt. 2, Box 214 Pennsboro, WV 26415

New Martinsville 6

New Martinsville
Quadrangle

Wileyville Quadrangle

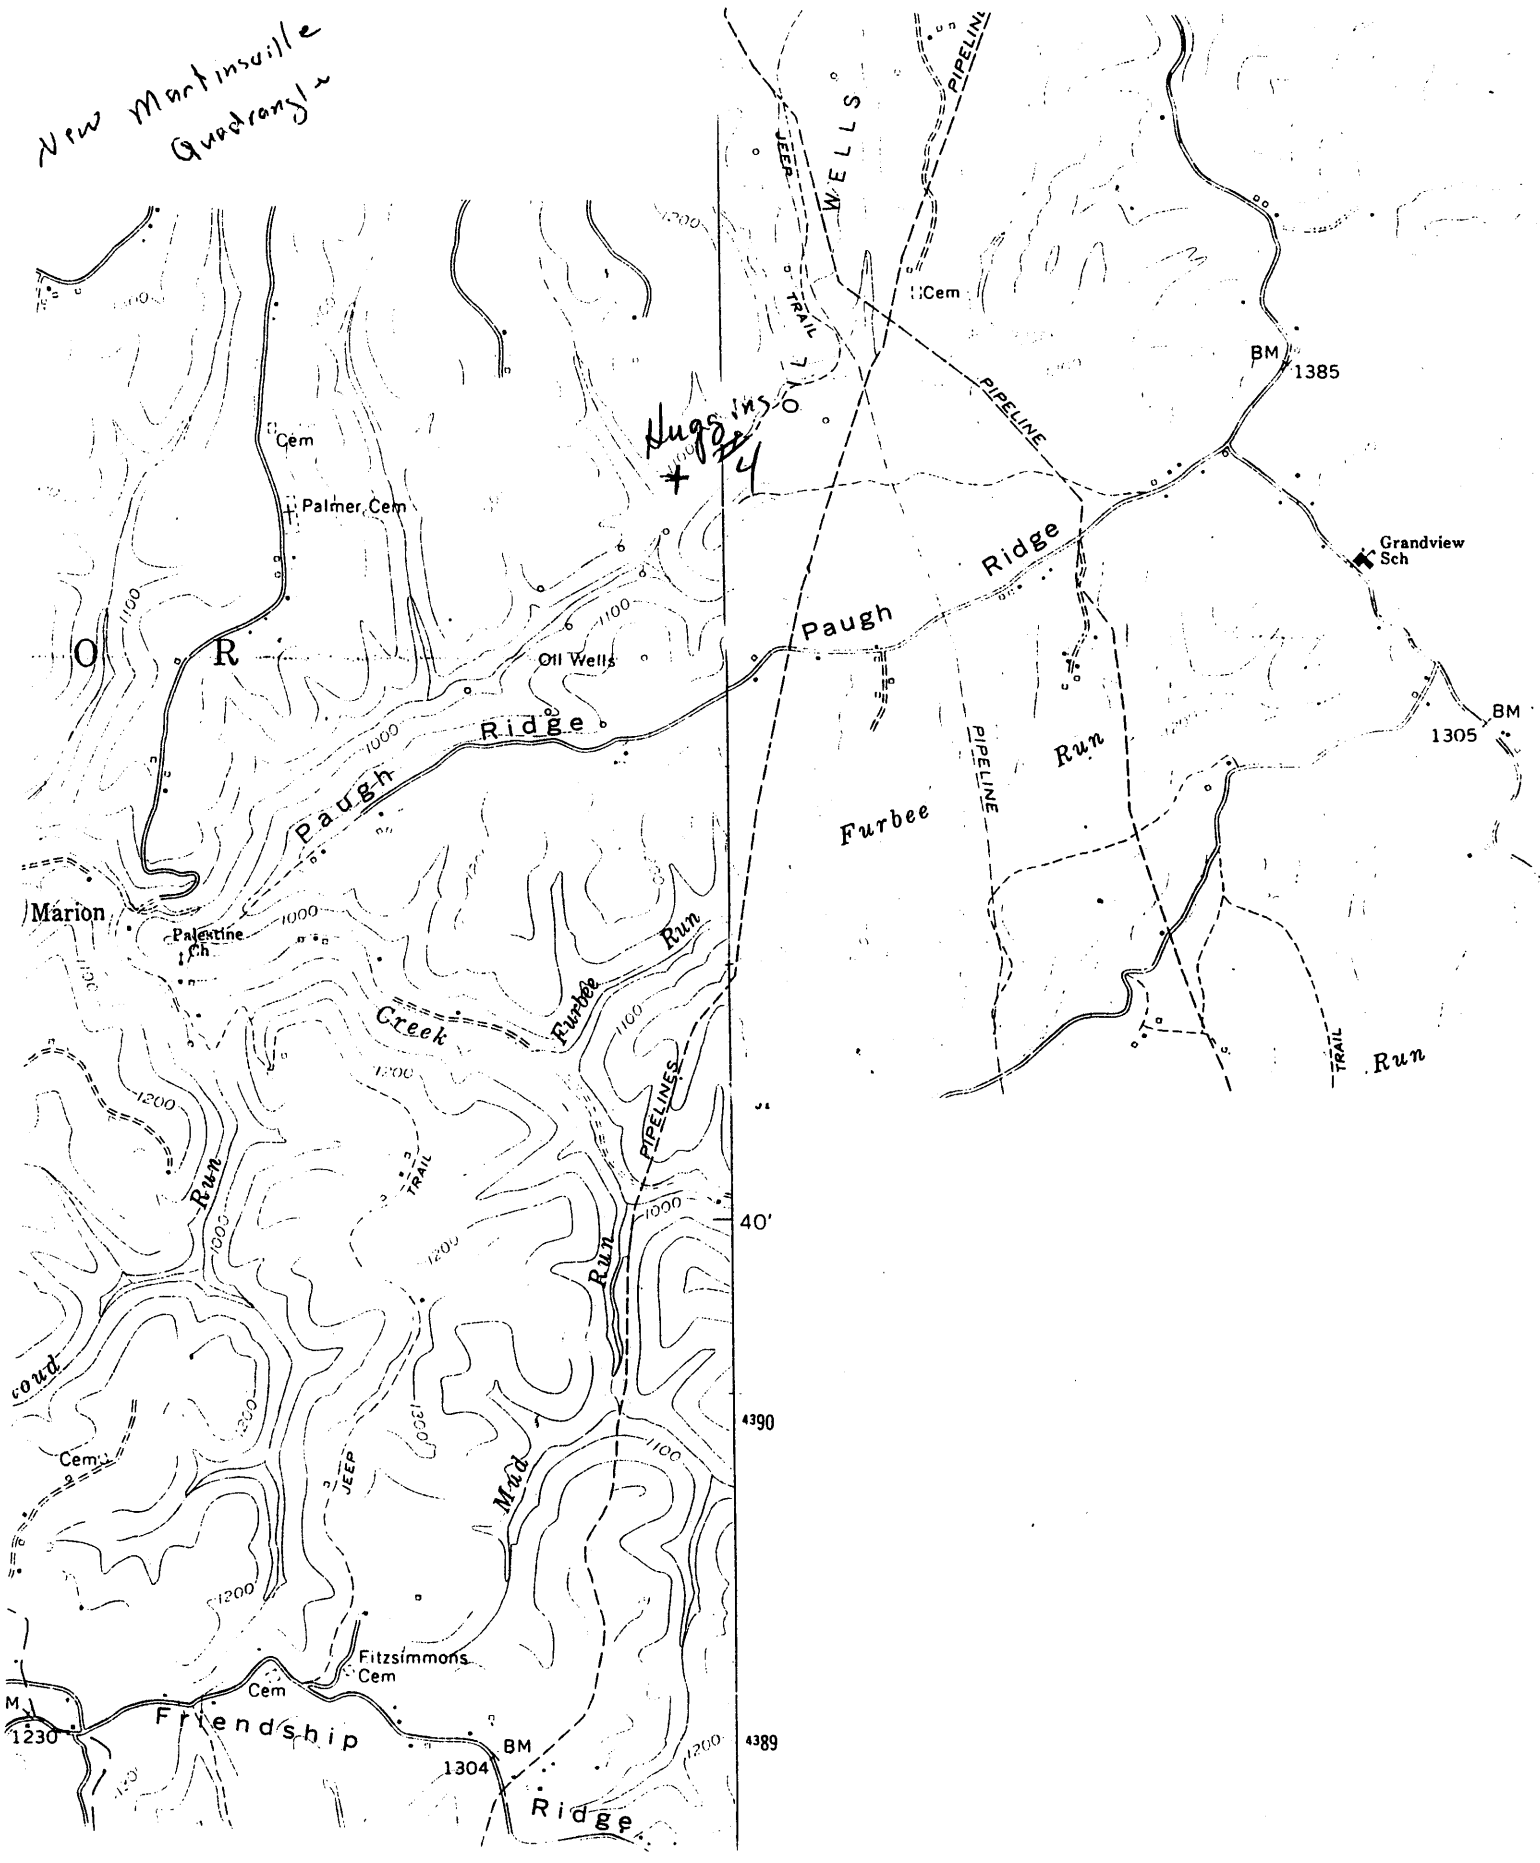

↘ Pine Grove 4863 11 SW