

INSTRUCTIONS

- 1) Attach a photo copy of the location of the well on a 7.5 minute Quadrangle with the corresponding Longitude and Latitude.
- 2) Designate the location of the well with the symbol(+).

80 45
1505
0123
+

I, the undersigned, Hereby certify that this plat is correct to the best of my knowledge and belief.

SIGNED Daryl L. Perkins

TITLE V. Pres.

DATE June 22, 1990

OPERATORS WELL NO. Huggins #6

API WELL NO. 103-1492

STATE OF WEST VIRGINIA
DEPARTMENT OF ENERGY
OIL AND GAS DIVISION

WELL TYPE: OIL GAS LIQUID INJECTION WASTE DISPOSAL
(if "GAS" PRODUCTION STORAGE DEEP SHALLOW

LOCATION: ELEVATION unknown WATER SHED _____
DISTRICT Proctor COUNTY Wetzel
QUADRANGLE New Martinsville

SURFACE OWNER J. R. Huggins Heirs ACREAGE 100⁺

OIL & GAS ROYALTY OWNER J. R. Huggins Heirs LEASE ACREAGE 100⁺
LEASE NO. _____

PRODUCING FORMATION Gordon TOTAL DEPTH 2837


WELL OPERATOR PERKINS OIL AND GAS, INC. DESIGNATED AGENT Daryl L. Perkins

ADDRESS Rt. 2, Box 214
Pennsboro, WV 26415 ADDRESS PERKINS OIL AND GAS, INC.
Rt. 2, Box 214
Pennsboro, WV 26415

MAR 16 1992

Wileyville Quadrangle

New Martinsville Quadrangle

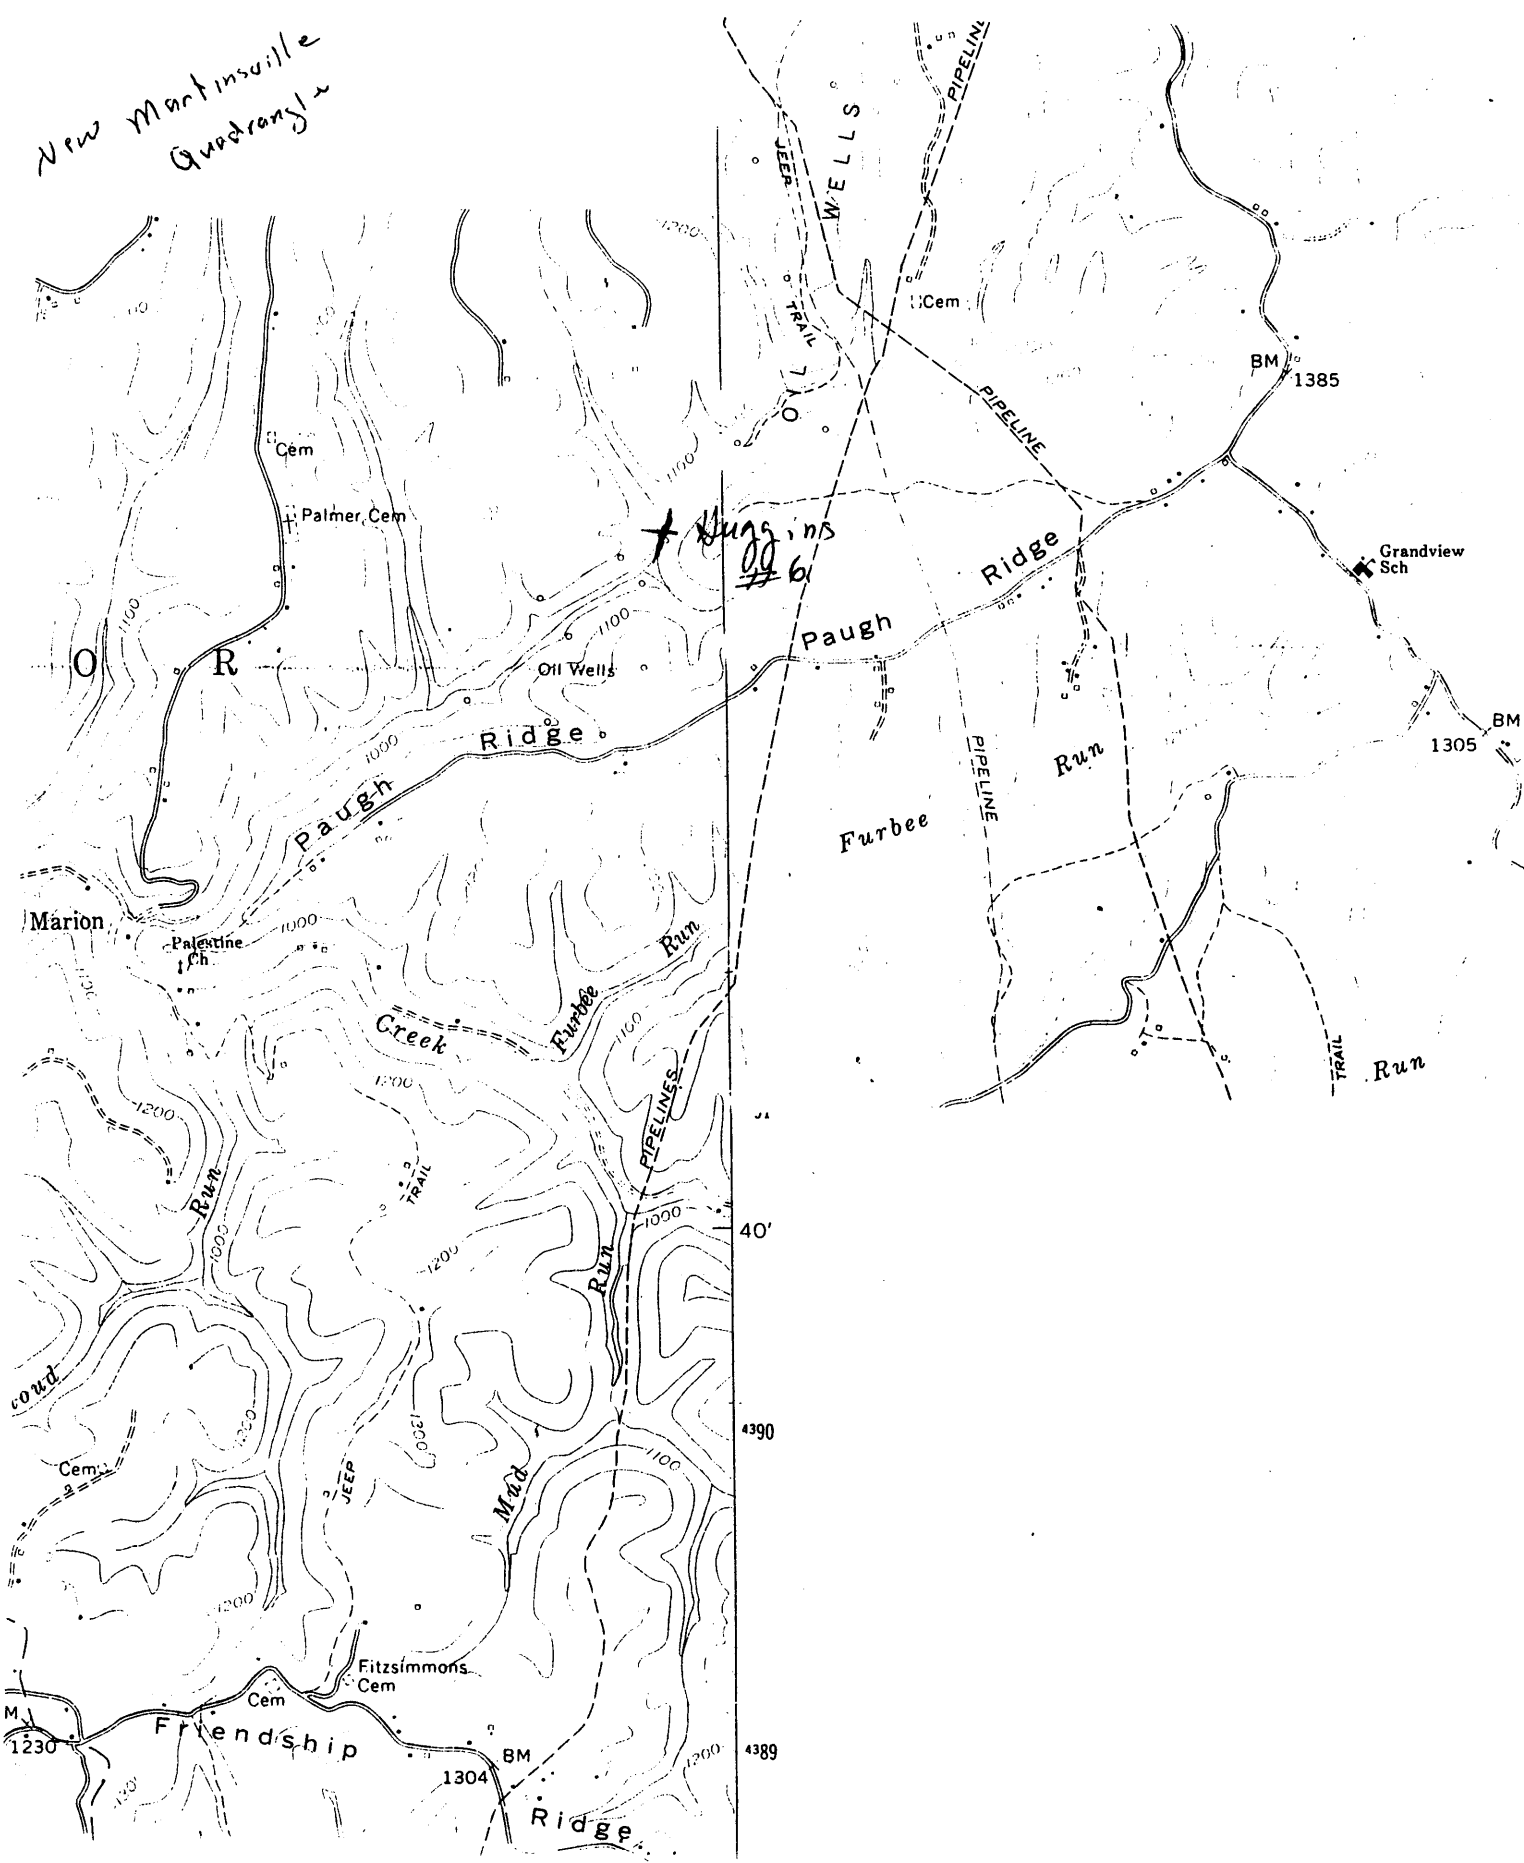

↘ Pine Grove 4863 115W

MAR 18 1972