

INSTRUCTIONS

1) Attach a photo copy of the location of the well on a 7.5 minute Quadrangle with the corresponding Longitude and Latitude.
 2) Designate the location of the well with the symbol(+).

1.125
0.10w

45
90

I, the undersigned, Hereby certify that this plat is correct to the best of my knowledge and belief.

SIGNED Daryl L. Perkins
 TITLE V. Pres.

DATE June 22, 1990
 OPERATORS WELL NO. Huggins #9
 API WELL NO. 103-1493

STATE OF WEST VIRGINIA
 DEPARTMENT OF ENERGY
 OIL AND GAS DIVISION

WELL TYPE: OIL GAS LIQUID INJECTION WASTE DISPOSAL
 (if "GAS" PRODUCTION STORAGE DEEP SHALLOW

LOCATION: ELEVATION unknown WATER SHED _____
 DISTRICT Proctor COUNTY Wetzel
 QUADRANGLE New Martinsville


SURFACE OWNER J. R. Huggins Heirs ACREAGE 100[±]
 OIL & GAS ROYALTY OWNER J. R. Huggins Heirs LEASE ACREAGE _____
 LEASE NO. _____

PRODUCING FORMATION Gordon TOTAL DEPTH unknown
 WELL OPERATOR PERKINS OIL AND GAS, INC. DESIGNATED AGENT Daryl L. Perkins
 ADDRESS Rt. 2, Box 214 ADDRESS PERKINS OIL AND GAS, INC.
Pennsboro, WV 26415 Rt. 2, Box 214
Pennsboro, WV 26415

MAR 1 8 1992

Wileyville Quadrangle

New Martinsville Quadrangle

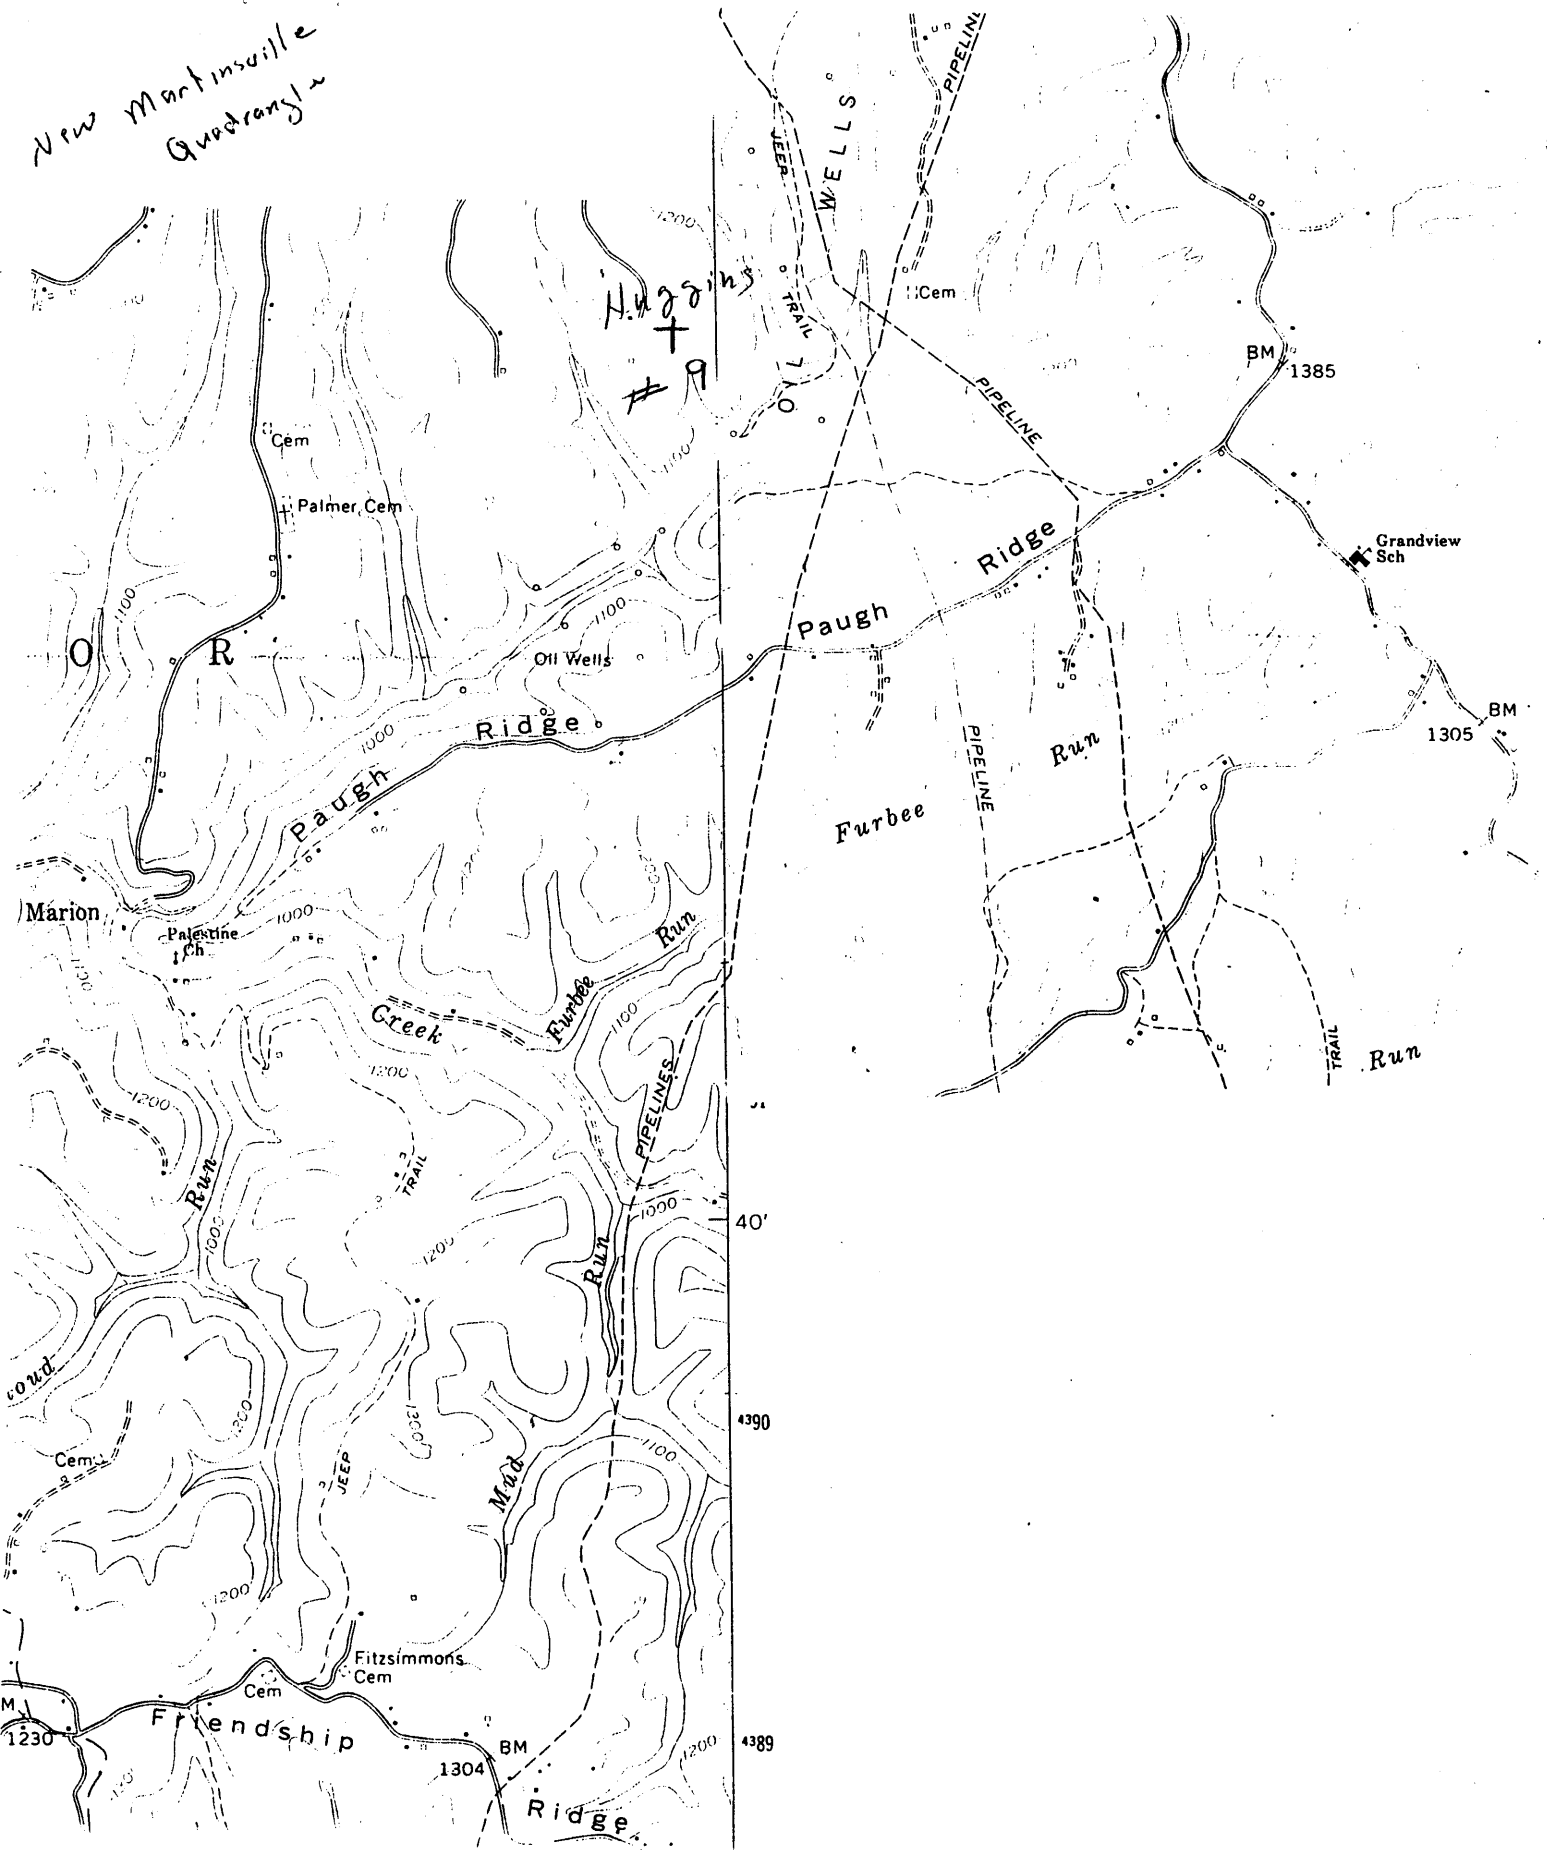

↓ (Pine Grove 4863 11sw)

MAR 16 1952