

INSTRUCTIONS


2700 39°40'00"

13200
80°40'00"

1) Attach a photo copy of the location of the well on a 7.5 minute Quadrangle with the corresponding Longitude and Latitude.

2) Designate the location of the well with the symbol(+).

2.50 S
0.51 W

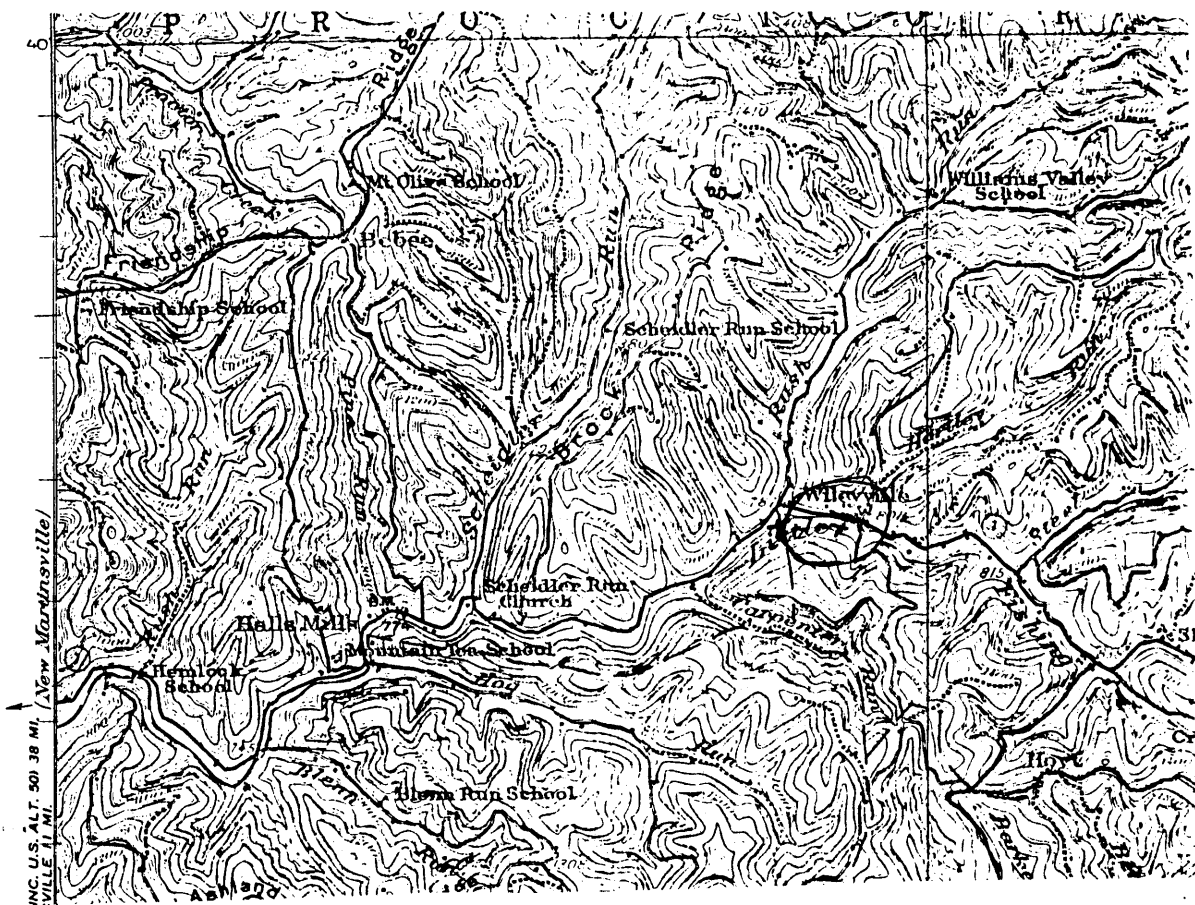

I, the undersigned, Hereby certify that this plat is correct to the best of my knowledge and belief.

SIGNED George B. McNeely

+ 7.5 tick

TITLE Owner

DATE March 8, 19 93

OPERATORS WELL NO. 1

API WELL NO. 103-1567-N

16907

STATE OF WEST VIRGINIA
DEPARTMENT OF ENERGY
OIL AND GAS DIVISION

WELL TYPE: OIL GAS LIQUID INJECTION WASTE DISPOSAL
(if "GAS" PRODUCTION STORAGE DEEP SHALLOW

LOCATION: ELEVATION 815 WATER SHED Fishing Creek
DISTRICT Center COUNTY Wetzel
QUADRANGLE Wileyville

SURFACE OWNER Ervin Hutchinson heirs ACREAGE 92

OIL & GAS ROYALTY OWNER Amos Long Estate LEASE ACREAGE 92
Nancy Morris Estate
LEASE NO. _____

PRODUCING FORMATION Gordon Sand TOTAL DEPTH 2927

WELL OPERATOR George B McNeely DESIGNATED AGENT none

ADDRESS Box 404, Hundred, WV 26575 ADDRESS _____

Section 8

STATE OF WEST VIRGINIA
DIVISION OF ENVIRONMENTAL PROTECTION
SECTION OF OIL AND GAS

WELL REGISTER ASSIGNMENT


This API Number 47-103-01567, issued to McNEELY, GEORGE B. is evidence of permission to operate the well that is referenced at the location described on the attached plat, subject to the provisions of Chapters 22 and 22B of the West Virginia Code of 1931, as amended, and all rules and regulations promulgated thereunder. The name and telephone number of the Oil and Gas Inspector for this well is RANDAL MICK -
304-986-3324.

Spills or emergency discharges must be reported to 1-800-654-3312.

Failure to abide by all statutory and regulatory provisions governing all duties and operations hereunder may result in suspension or revocation of your permits and in addition may result in civil and/or criminal penalties.

The enclosed WR-35 must be completed by you and returned to this office. In addition annual production reports must be submitted on this well and failure to do so may require you to plug the well.

Theodore M. Streit
Chief

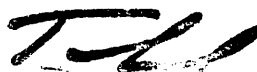

By: _____

Title: _____

Operator's Well No: LONG/MORRIS 1

Farm Name: HUTCHINSON, ERVIN - HEIRS

API Well Number : 47-103-01567 N

Date Issued : 02/07/94