

WW-7
8-30-06



West Virginia Department of Environmental Protection
Office of Oil and Gas

WELL LOCATION FORM: GPS

API: 47-103-01571 WELL NO.: 7252

FARM NAME: I. D. MORGAN

RESPONSIBLE PARTY NAME: WEST VIRGINIA LAND RESOURCES INC.

COUNTY: WETZEL DISTRICT: GRANT

QUADRANGLE: BIG RUN W.VA

SURFACE OWNER: JOHN H. & PAMELA J. MELVIN

ROYALTY OWNER: _____

UTM GPS NORTHING: 4,372,772 m

862.6'

UTM GPS EASTING: 539,997 m GPS ELEVATION: 263 m

The Responsible Party named above has chosen to submit GPS coordinates in lieu of preparing a new well location plat for a plugging permit or assigned API number on the above well. The Office of Oil and Gas will not accept GPS coordinates that do not meet the following requirements:

- Datum: NAD 1983, Zone: 17 North, Coordinate Units: meters, Altitude: height above mean sea level (MSL) – meters.
- Accuracy to Datum – 3.05 meters
- Data Collection Method:

Survey grade GPS _____: Post Processed Differential _____

Real-Time Differential _____

Mapping Grade GPS X: Post Processed Differential X

Real-Time Differential _____

- Letter size copy of the topography map showing the well location.

I the undersigned, hereby certify this data is correct to the best of my knowledge and belief and shows all the information required by law and the regulations issued and prescribed by the Office of Oil and Gas.

Signature

Professional Surveyor

Title

FEBRUARY 5, 2022

Date

RECEIVED
Office of Oil and Gas

FEB 25 2022

WV Department of
Environmental Protection

03/11/2022

Well# 7252

BIG RUN WV 7.5' Quad

Scale: 1" = 2000'



GILBE

Morgan
Cern

Well# 7252

Gas
Well

Oil Well

Oil Well

Oil Well


RECEIVED
Office of Oil and Gas

Stout
Cern

WV Department of
Environmental Protection

03/11/2022

Access R...

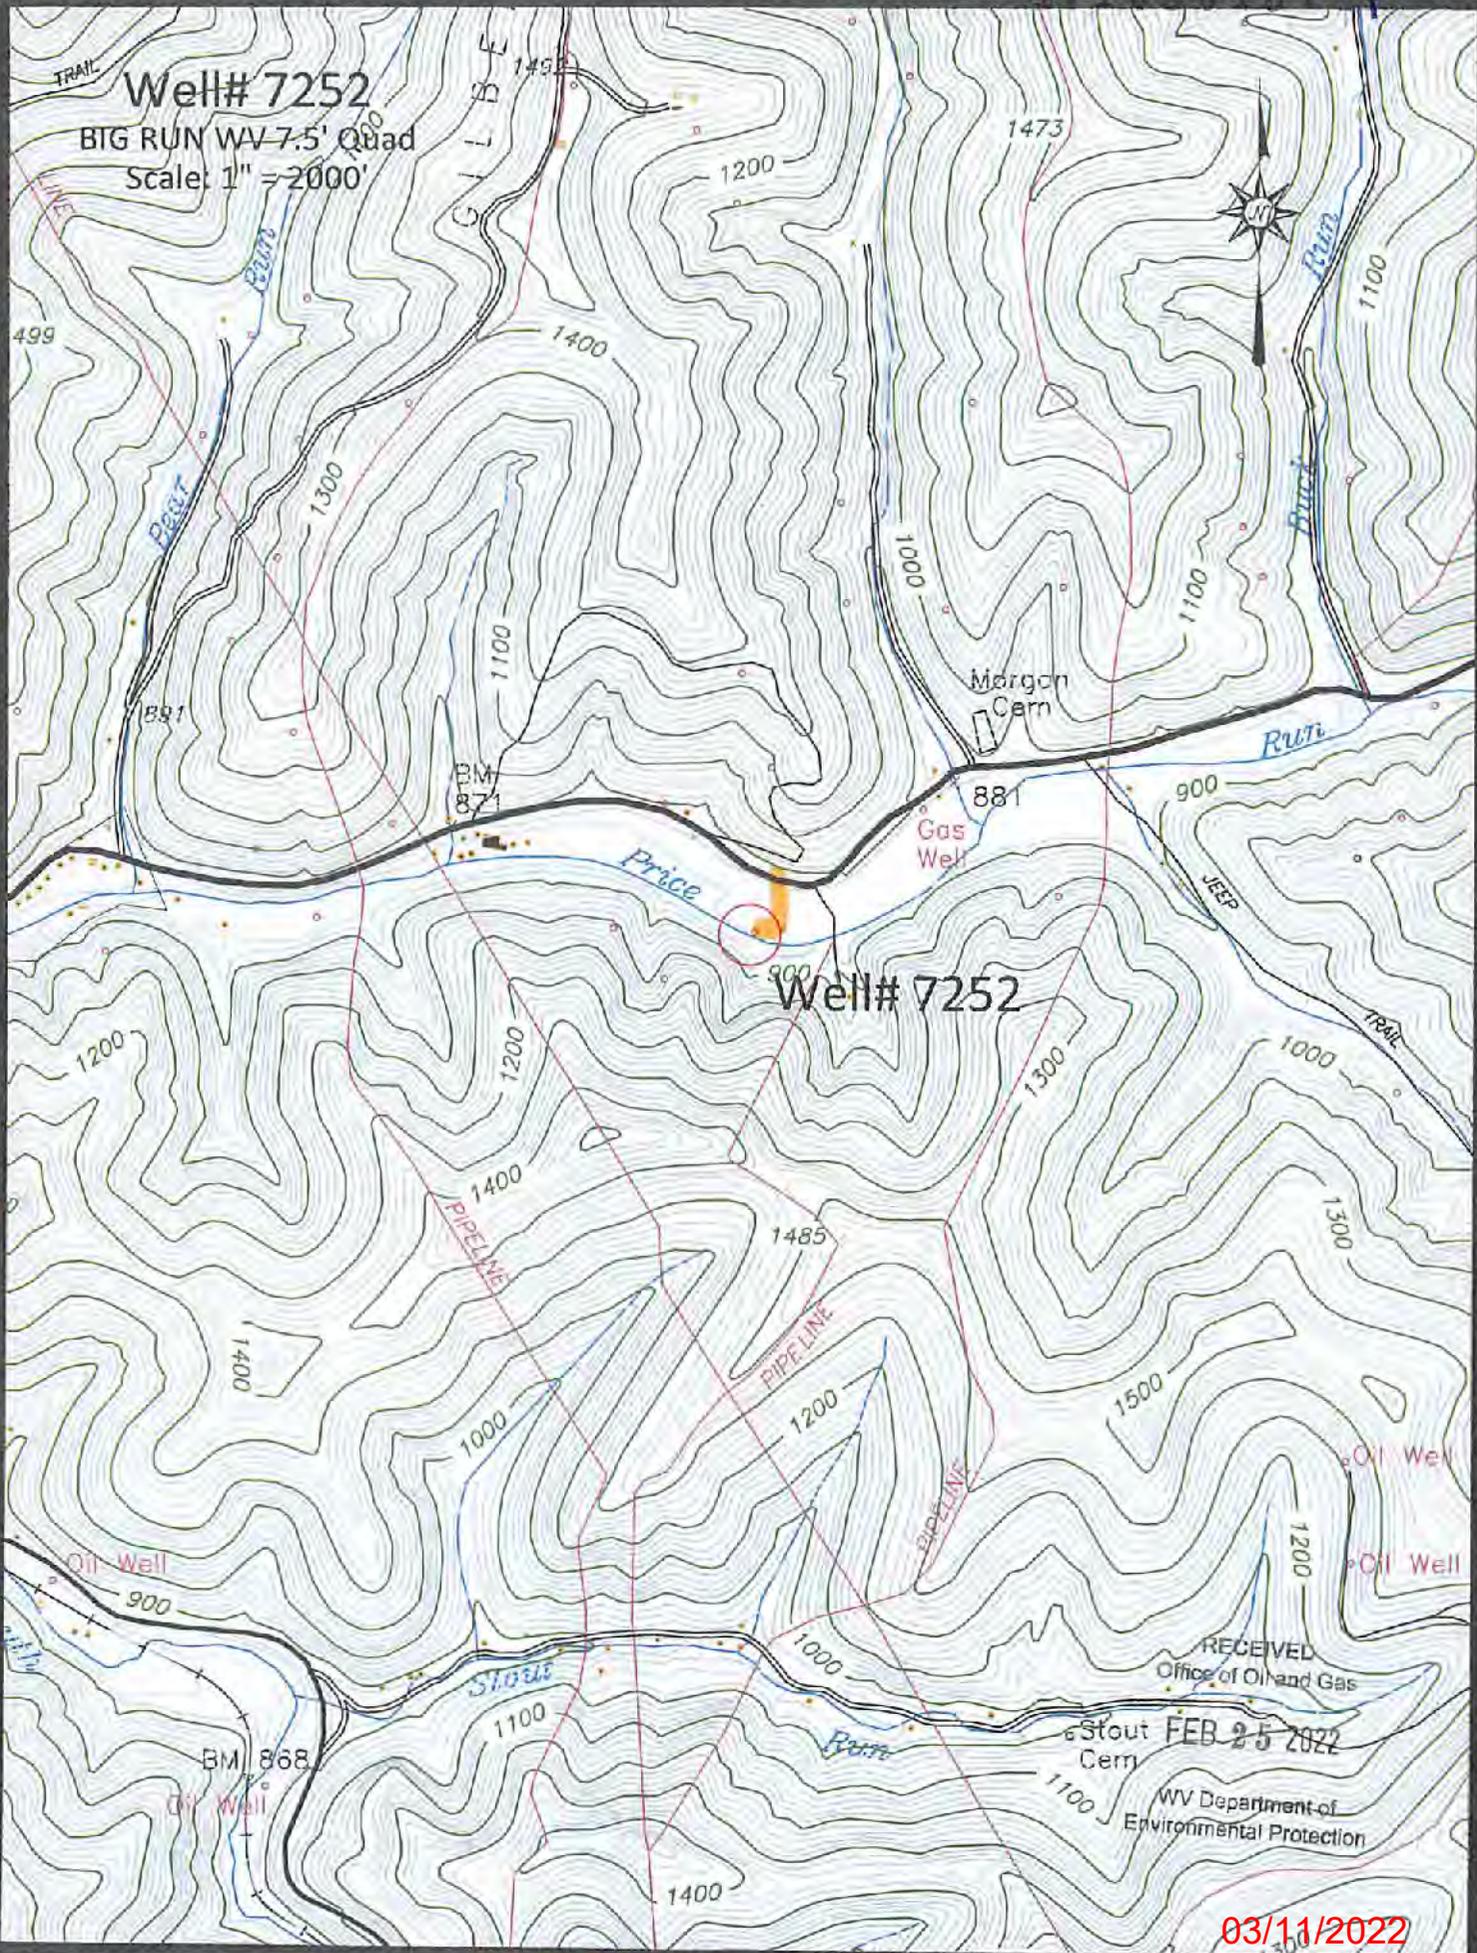

Well# 7252

BIG RUN WV 7.5' Quad

Scale: 1" = 500'



Moro
Ce

BM
871

881

Gas
Well

Price

Well# 7252

1200

1400

1485


RECEIVED
Office of Oil and Gas

FEB 25 2022

WV Department of
Environmental Protection

03/11/2022


Access Road

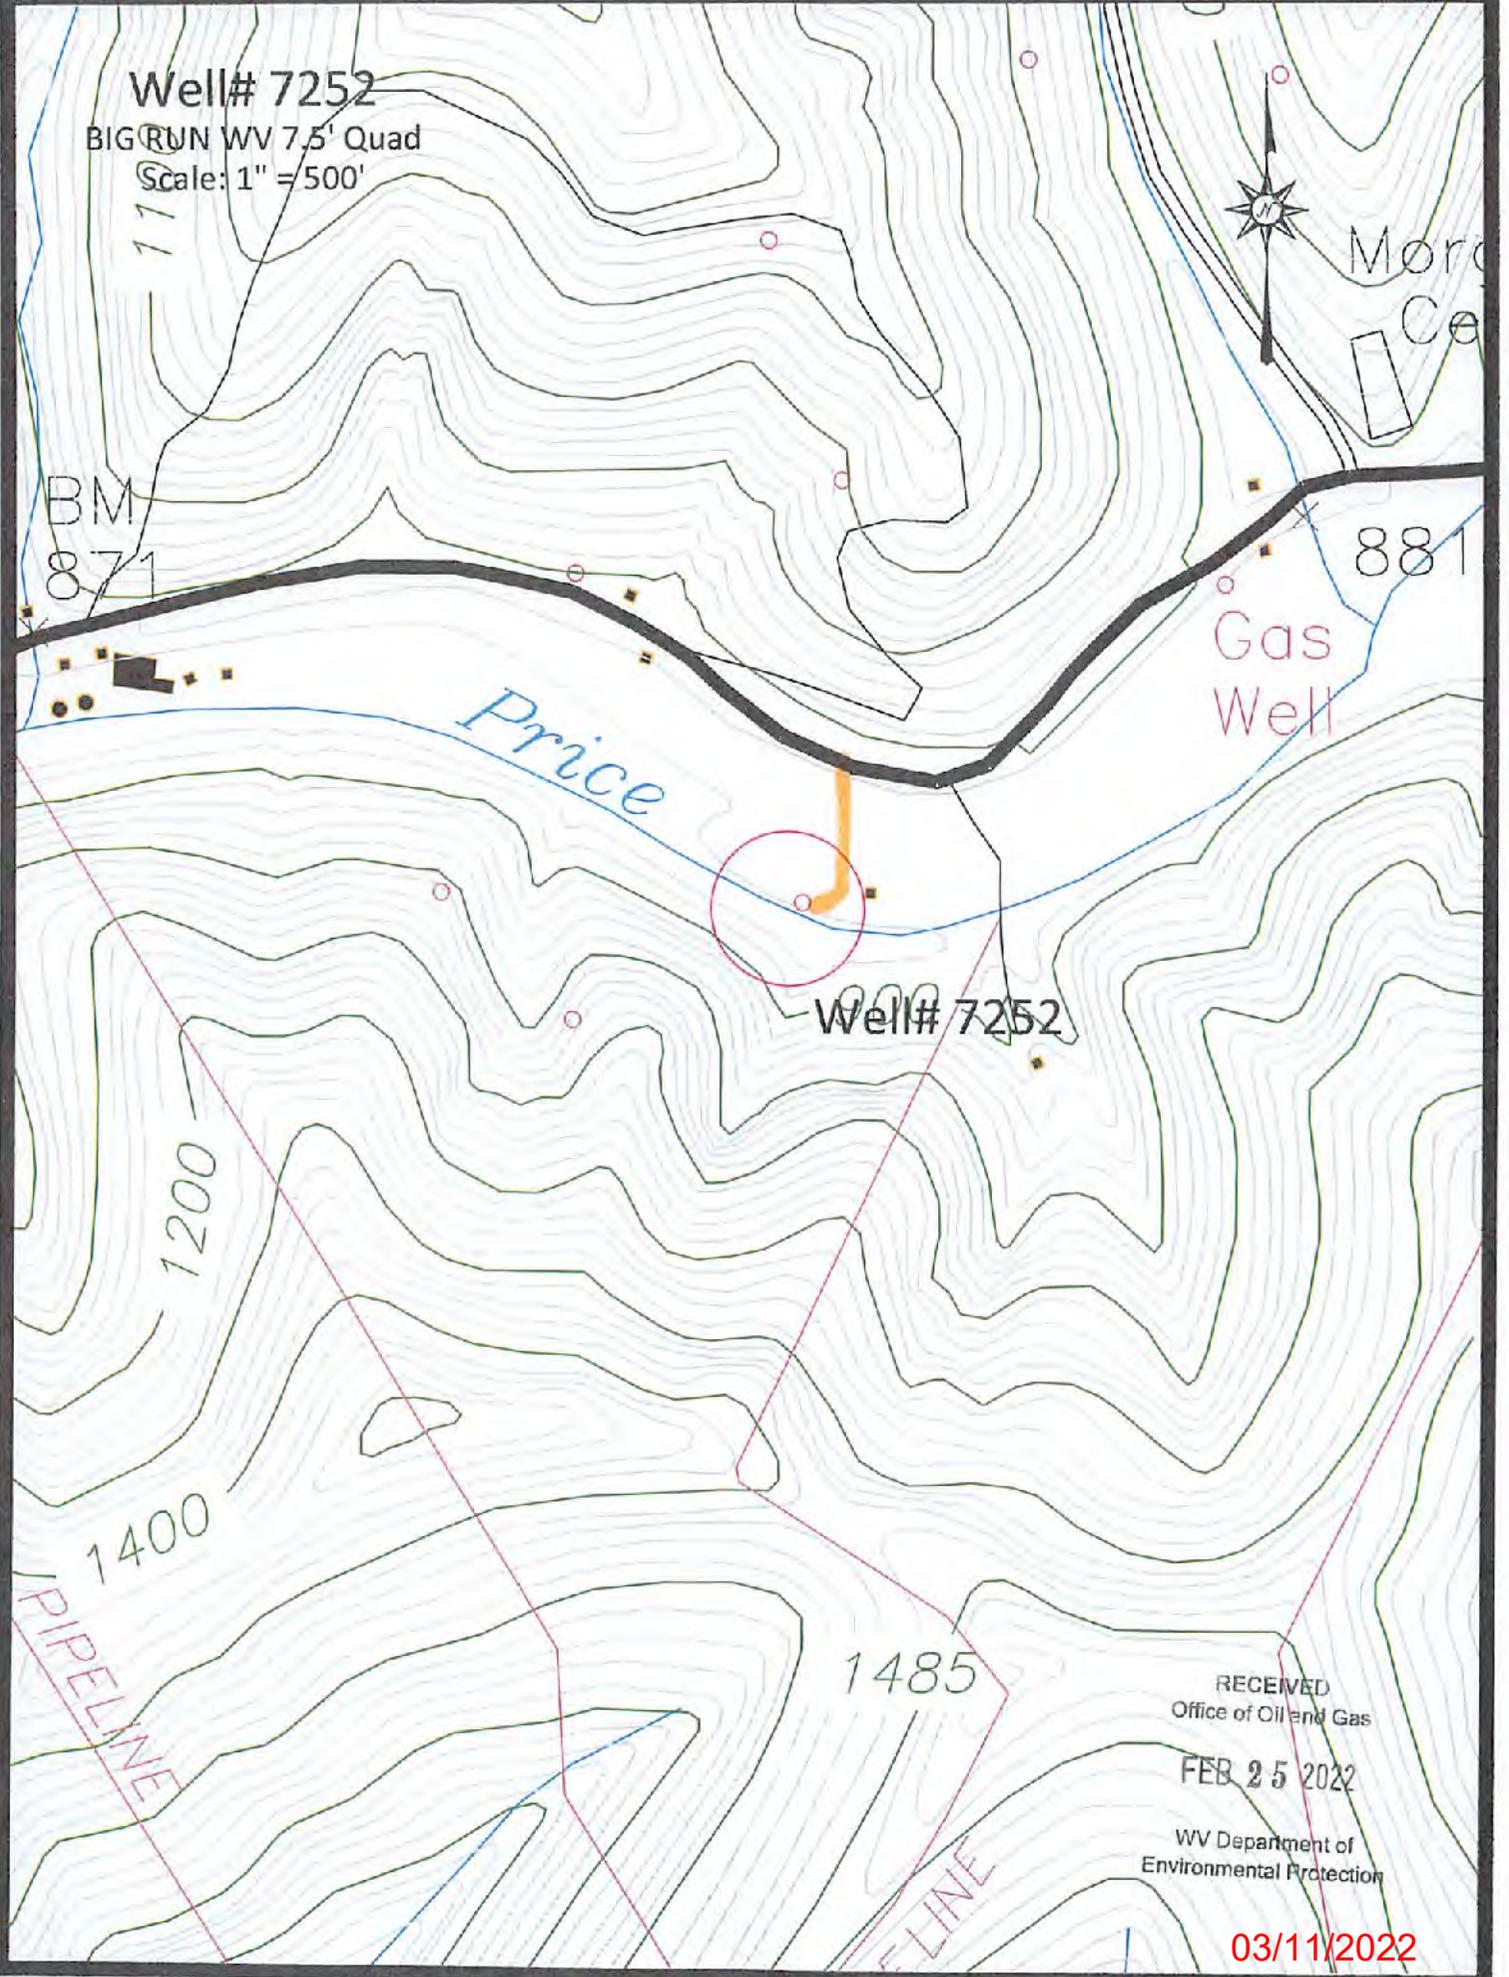

471030 1571P



471
32'30"
476
475
474
473
39°30'

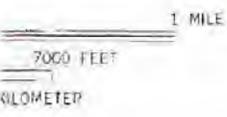

INTERIOR GEOLOGICAL SURVEY, RESTON, VIRGINIA - 1977

ROAD CLASSIFICATION

- Heavy-duty (thick solid line)
- Medium-duty (solid line)
- Light-duty (thin solid line)
- Unimproved dirt (dashed line)
- Slate Route (dotted line)

RECEIVED
Office of Oil and Gas
FEB 25 2022
WV Department of Environmental Protection

BIG RUN, W. VA.
SE 1/4 LITTLETON 15' QUADRANGLE
N3930—W8030/7.5
03/11/2022