

39° 30' 00"

Latitude

well spot

80° 37' 30"

Longitude

Digitized loc

0.115
1.40W

calc 15' loc. 0.115
3.64W

Topo Location

7.5' Loc. 0.045 15' Loc. 0.045
1.38W (calc.) 3.61W

Company Quaker State Corp.
Farm John Mills # 60
15' Quad Center Point (NC)
(sec.)
7.5' Quad Center Point
District Grant

(was 71839) Gordon-2875-2913
Comp. 10/30/1900 show
out @ 2895

WELL LOCATION PLAT


County 103 Permit 1597N

INSTRUCTIONS

LATITUDE 39°37'30"
(120'5)

LONGITUDE 80°37'30"
(7240'W)

1) Attach a photo copy of the location of the well on a 7.5 minute Quadrangle with the corresponding Longitude and Latitude.
2) Designate the location of the well with the symbol(+).

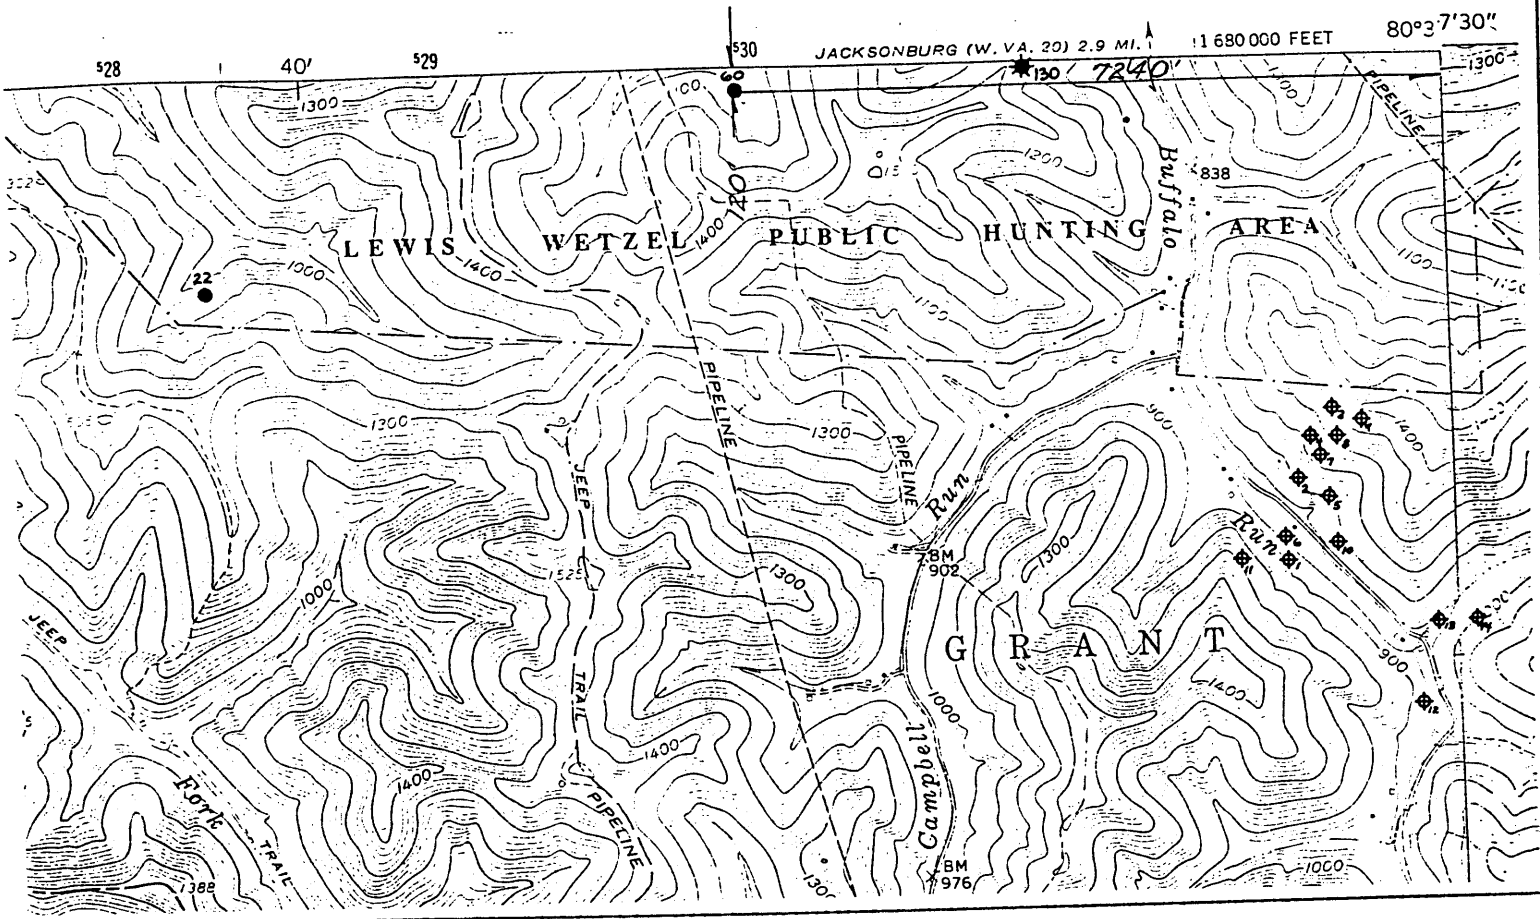

I, the undersigned, Hereby certify that this plat is correct to the best of my knowledge and belief.


SIGNED *Quaker State*

TITLE District Manager

DATE November 18, 1993

OPERATORS WELL NO. Mills #60

API WELL NO. 47-103-1597-2

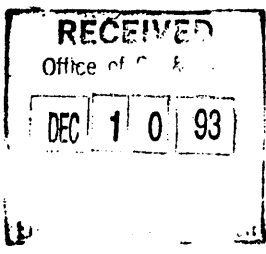

STATE OF WEST VIRGINIA
DEPARTMENT OF ENERGY
OIL AND GAS DIVISION

WELL TYPE: OIL GAS LIQUID INJECTION WASTE DISPOSAL
(If "GAS" PRODUCTION STORAGE DEEP SHALLOW

LOCATION: ELEVATION 1027' WATER SHED Tributary of Buffalo Run
DISTRICT Grant COUNTY Wetzel
QUADRANGLE Center Point

SURFACE OWNER John Mills ACREAGE 5451

OIL & GAS ROYALTY OWNER N/A LEASE ACREAGE
LEASE NO.

PRODUCING FORMATION Gordon Sand TOTAL DEPTH 2917'

WELL OPERATOR Quaker State Corporation DESIGNATED AGENT Frank Rotunda

ADDRESS 1226 Putnam Howe Drive ADDRESS P.O. Box 823
Belpre, OH 45714 Parkersburg, WV 26102

18515

STATE OF WEST VIRGINIA
DIVISION OF ENVIRONMENTAL PROTECTION
SECTION OF OIL AND GAS

WELL REGISTER ASSIGNMENT

This API Number 47-103-01597, issued to QUAKER STATE CORPORATION is evidence of permission to operate the well that is referenced at the location described on the attached plat, subject to the provisions of Chapters 22 and 22B of the West Virginia Code of 1931, as amended, and all rules and regulations promulgated thereunder. The name and telephone number of the Oil and Gas Inspector for this well is RANDAL MICK -
304-986-3324.

Spills or emergency discharges must be reported to 1-800-654-3312.

Failure to abide by all statutory and regulatory provisions governing all duties and operations hereunder may result in suspension or revocation of your permits and in addition may result in civil and/or criminal penalties.

The enclosed WR-35 must be completed by you and returned to this office. In addition annual production reports must be submitted on this well and failure to do so may require you to plug the well.

Theodore M. Streit
Chief

By: 

Title: _____

Operator's Well No: MILLS #60

Farm Name: MILLS, JOHN

API Well Number : 47-103-01597 N

Date Issued : 03/10/94